


ABELL
SURVEYING & MAPPING

DELAVAN, WISCONSIN 53115


414-728-6737

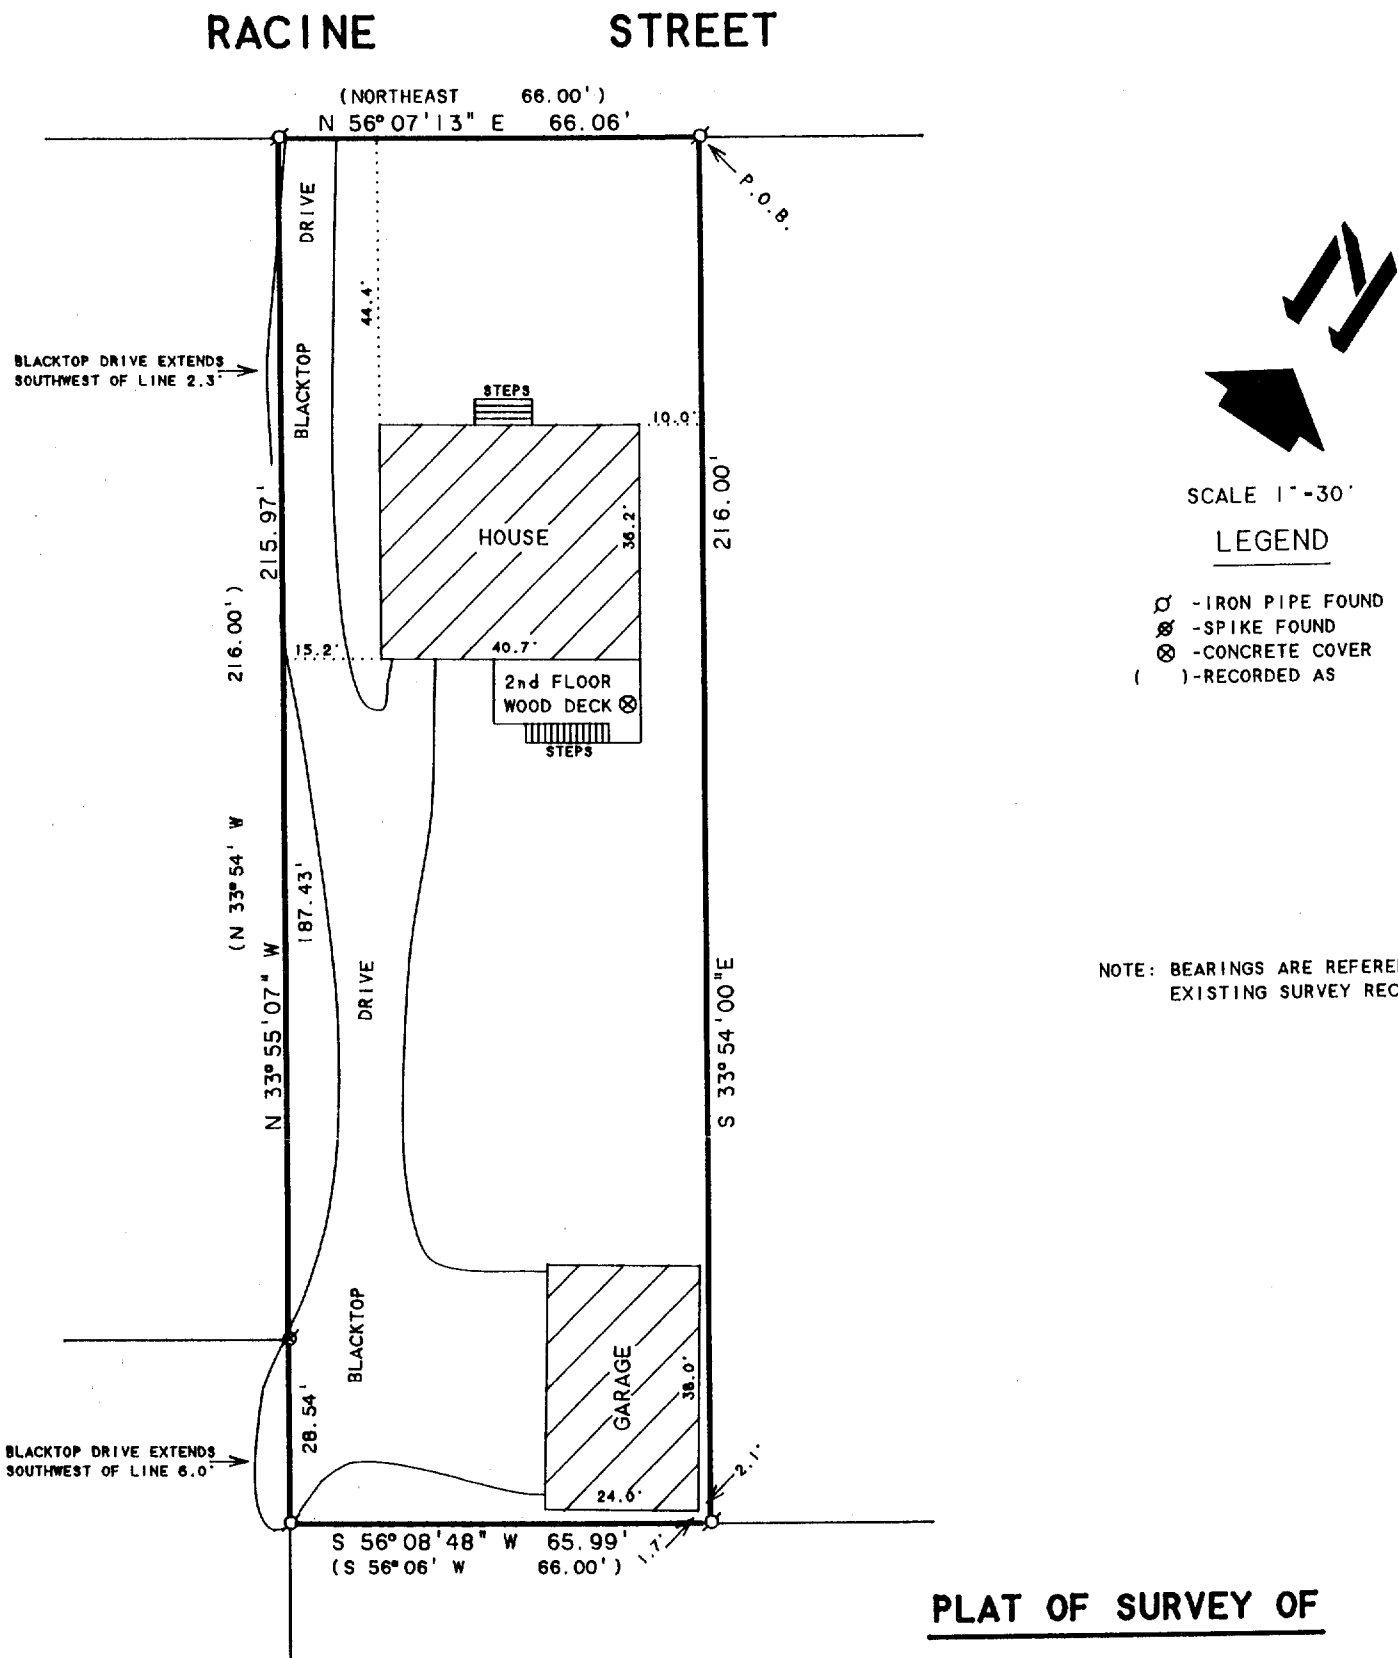

Beginning at a point on the S line of Racine Street in the City of Delavan, N 56° 6' E distant 6 chains, 38 links, from the intersection of the N and S 1/8th section line of the NW 1/4 of Section 17, T2N, R16E, with the S line of Racine Street, and running thence S 33° 54' E 216 feet, thence S 56° 6' W 66 feet, thence N 33° 54' W 216 feet to a point on the S line of Racine Street, thence NE along the S line of Racine Street 66 feet to the place of beginning.

Tax Key Number: XWUP 00028

ORDERED BY: PROFESSIONAL REALTY
706 E. GENEVA ST.
DELAVAN, WI. 53115

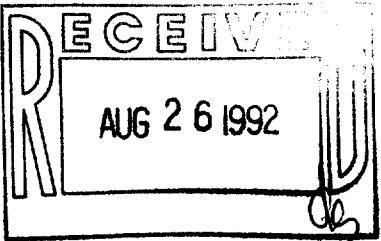

I HEREBY CERTIFY THAT I HAVE SURVEYED THE ABOVE DESCRIBED PROPERTY AND THAT THE ABOVE MAP IS A TRUE REPRESENTATION THEREOF AND SHOWS THE SIZE AND LOCATION OF THE PROPERTY, ITS EXTERIOR BOUNDARIES, THE LOCATION OF ALL VISIBLE STRUCTURES AND DIMENSIONS OF ALL PRINCIPAL BUILDINGS THEREON, BOUNDARY FENCES, APPARENT EASEMENTS, ROADWAYS AND VISIBLE ENCROACHMENTS, IF ANY, TO THE BEST OF MY KNOWLEDGE AND BELIEF.

THIS SURVEY IS MADE FOR THE USE OF THE PRESENT OWNERS OF THE PROPERTY, AND ALSO THOSE WHO PURCHASE, MORTGAGE, OR GUARANTEE THE TITLE THERETO WITHIN ONE (1) YEAR FROM DATE HEREON.

David F. Abell

DAVID F. ABELL
WISCONSIN REGISTERED LAND SURVEYOR, S-1596

JUNE 22, 1992

DATE
NOTE: THIS IS NOT A CERTIFIED COPY UNLESS SEALED.

JOB NUMBER - 92127

002-1159

XWUP-28