


N

 SCALE ~ 1" = 20'
 O ~ IRON PIPE

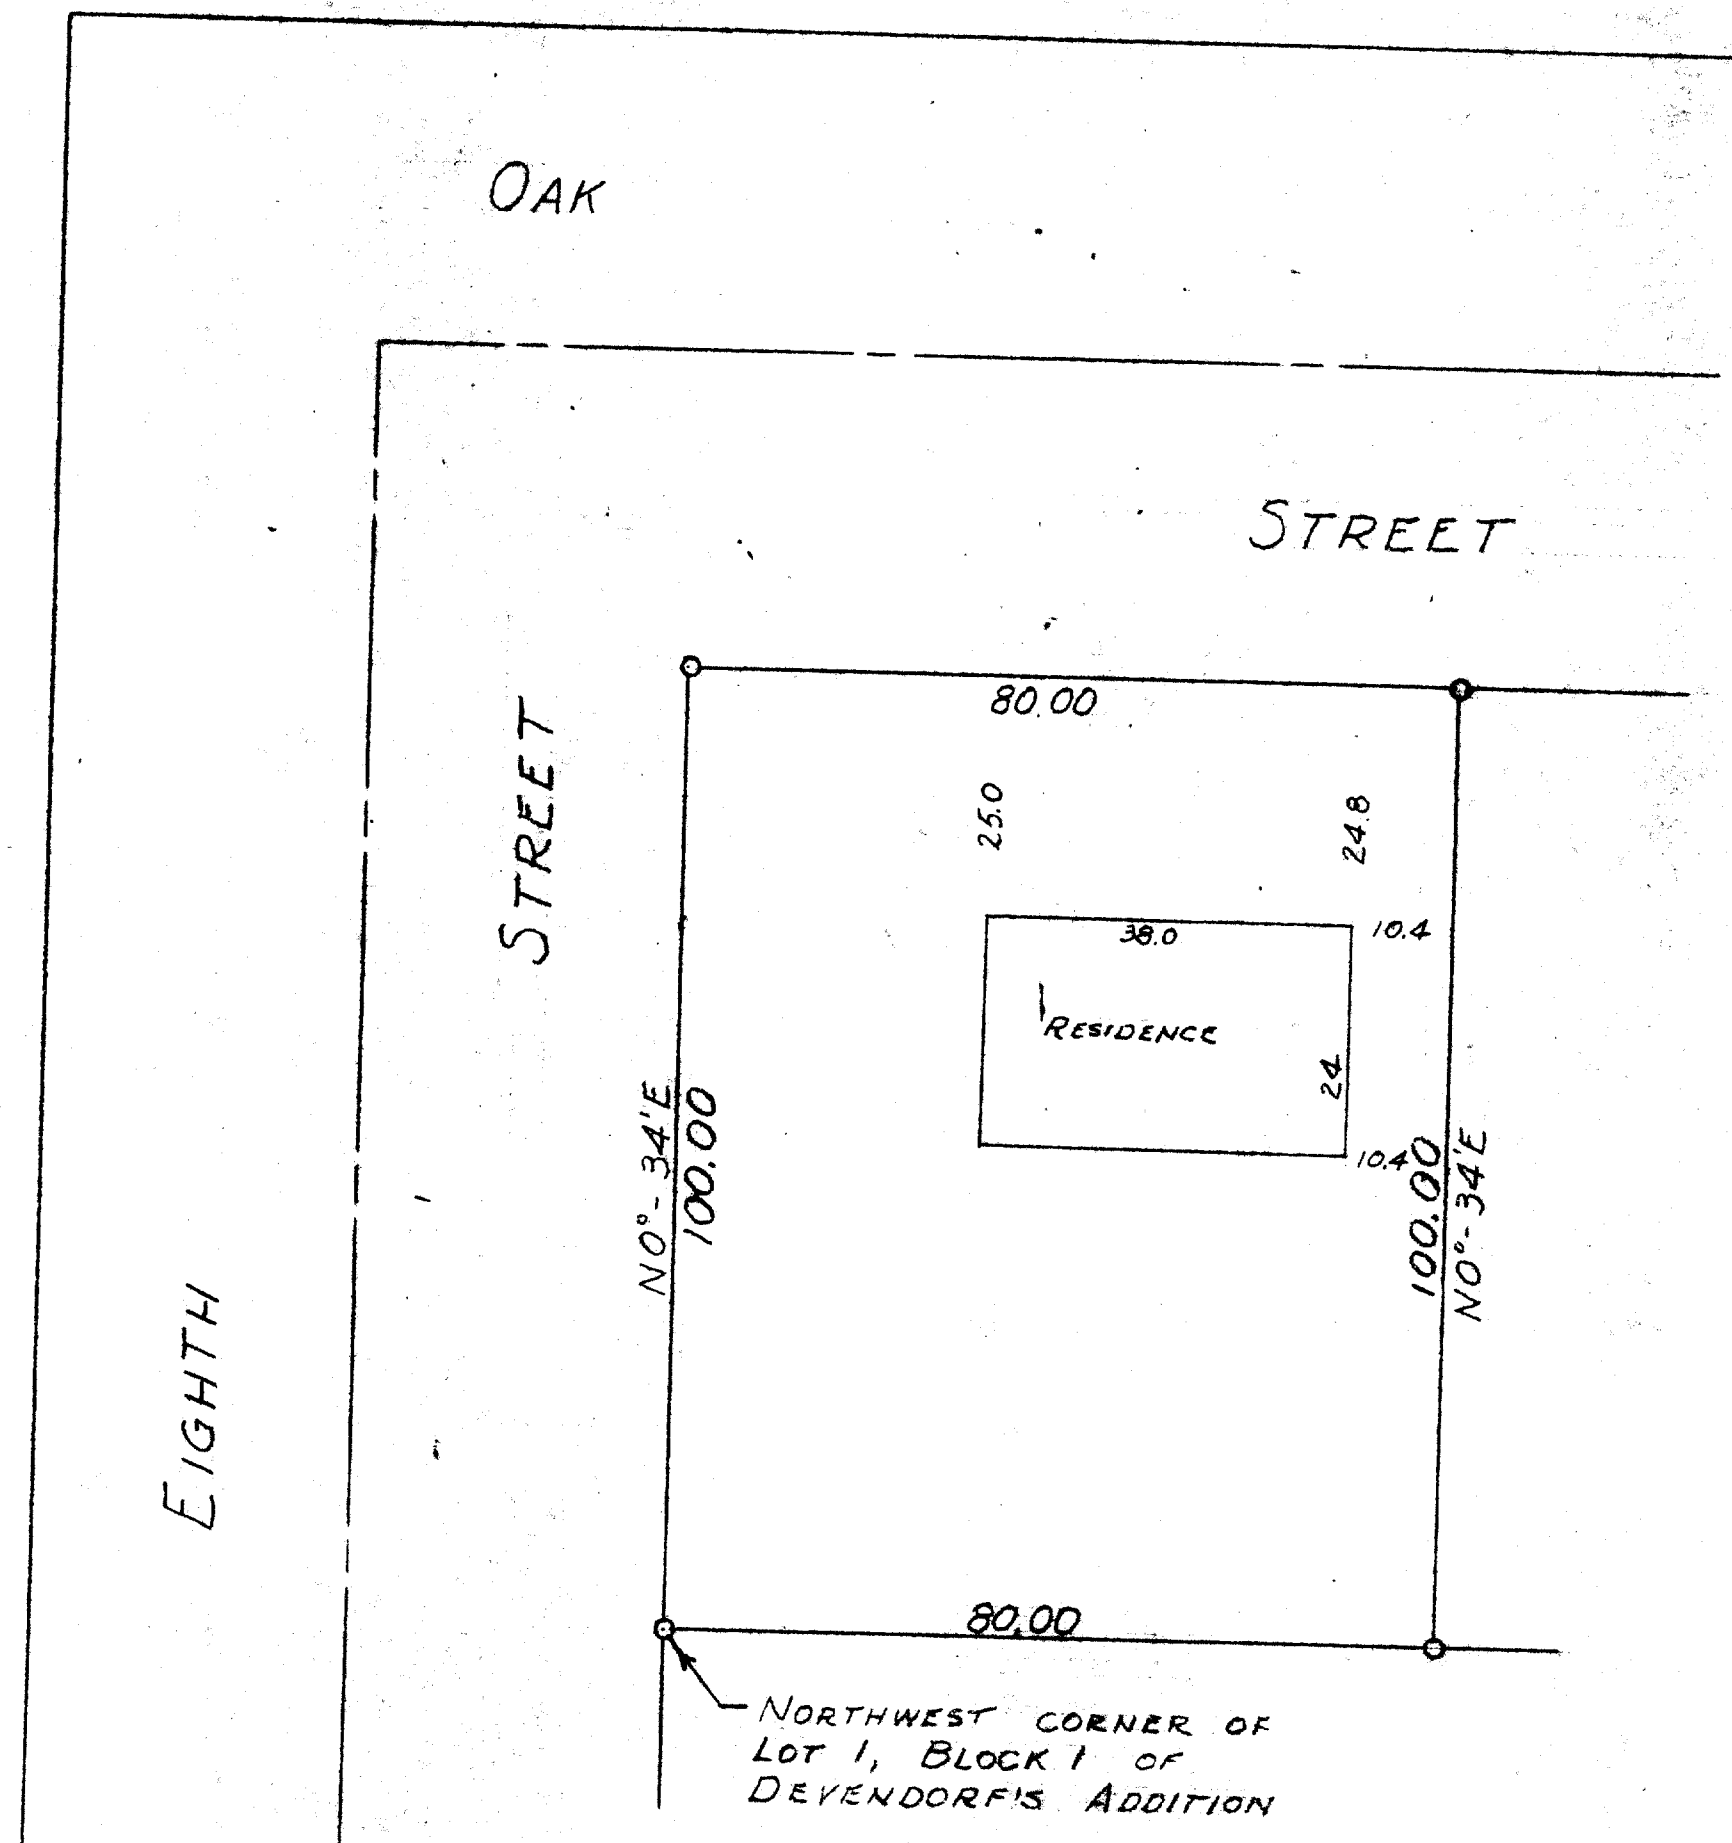


STATE OF WISCONSIN } S.S.
 WALWORTH COUNTY }

I, GEORGE T. DUNHAM, HEREBY CERTIFY THAT I HAVE SURVEYED THE PROPERTY DESCRIBED AS FOLLOWS:

A PARCEL OF LAND LOCATED IN THE NORTHWEST 1/4 OF SECTION 17, T2NR16E, CITY OF DELAVAN, WALWORTH COUNTY, WISCONSIN, DESCRIBED AS FOLLOWS, TO-WIT: BEGINNING AT THE NORTHWEST CORNER OF LOT 1, BLOCK 1, OF DEVENDORF'S ADDITION TO THE CITY OF DELAVAN; THENCE EASTERLY ALONG THE NORTH LINE OF SAID LOT 1, 80.00 FEET TO A POINT; THENCE N0°-34'E PARALLEL TO THE EAST LINE OF EIGHTH STREET 100.00 FEET TO THE SOUTH LINE OF OAK STREET; THENCE WESTERLY ALONG THE SOUTH LINE OF OAK STREET 80.00 FEET TO THE EAST LINE OF EIGHTH STREET; THENCE S0°-34'W ALONG THE EAST LINE OF EIGHTH STREET 100.00 FEET TO THE PLACE OF BEGINNING, AND THAT THE PLAT SHOWN ABOVE IS A CORRECT REPRESENTATION OF THE PROPERTY LINES AND THE IMPROVEMENTS LOCATED THEREON.

AUG. 22, 1950

WUP-42E

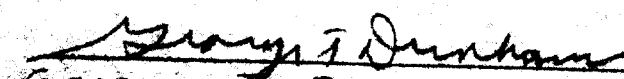
 GEORGE T. DUNHAM, SURVEYOR 2-117