


DUNHAM REVISION 1C

DELAVAN, WISCONSIN 53114

STREET

ELM

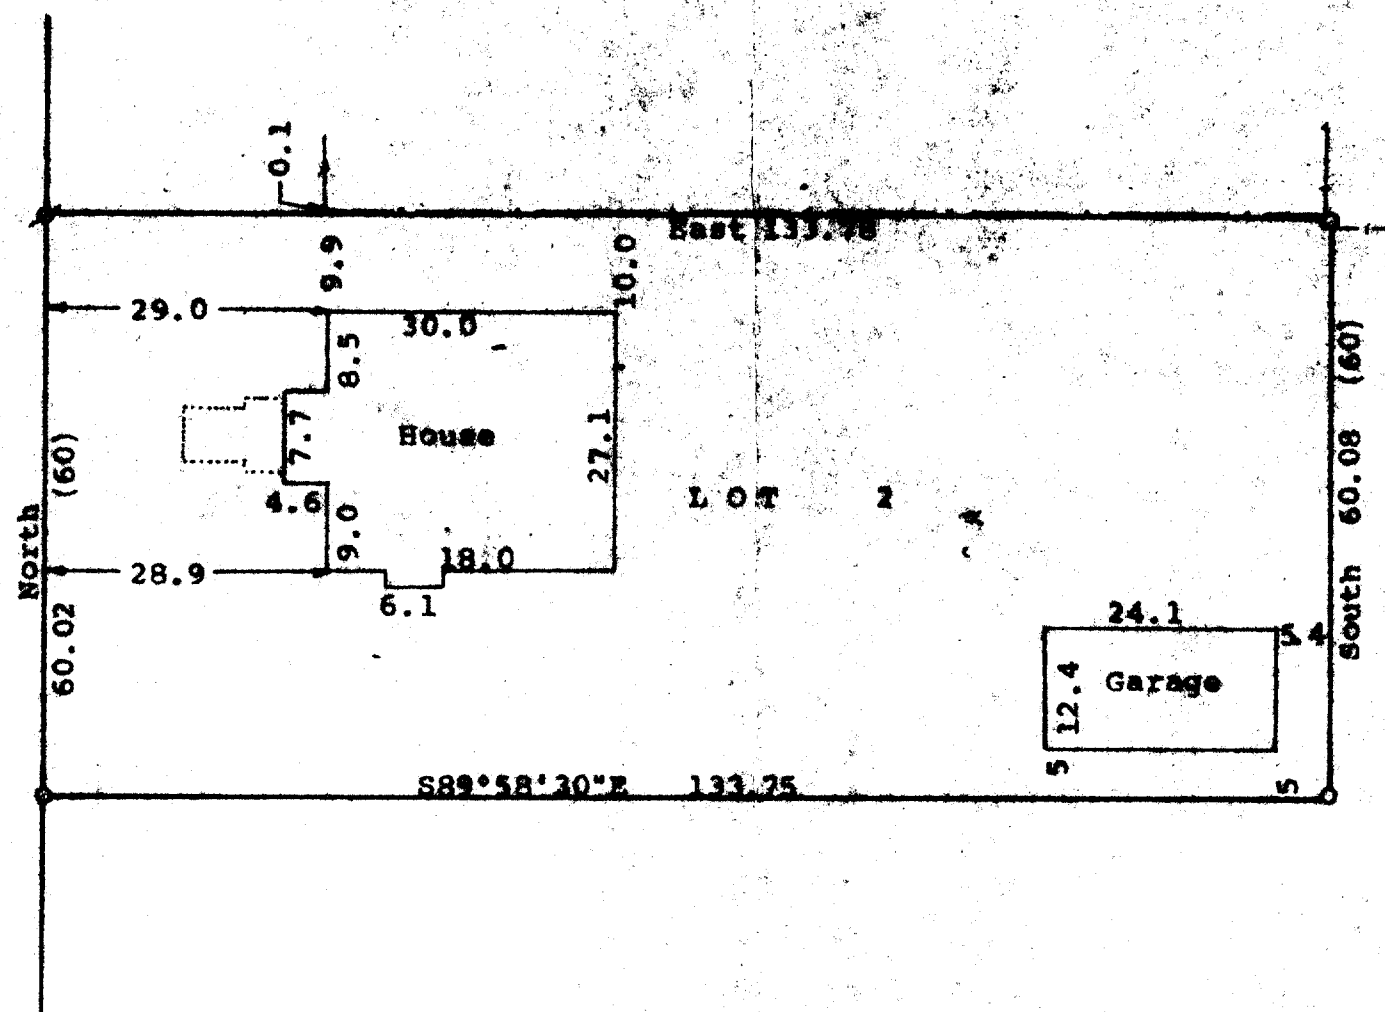

N

Scale - 1" = 20'

Ø = 1" Iron Pipe Found

○ = 3/4" Iron Pipe Found

--- = Fence Line

(0.00) = recorded distance
Bearings referenced to the east line of
Elm Street with the assumed bearing of
North.

Survey ordered by:
Danielson & Osman Realtors
23 North Wisconsin Street
Darien, WI 53114

STATE OF WISCONSIN)
COUNTY OF WALWORTH) SS

I, George T. Dunham, Surveyor, certify that I have surveyed the
property described as follows:

Lot 2 in Block 2 of Sunset View Subdivision located in the City
of Delavan, Walworth County, Wisconsin,

and that the plat shown hereon is a correct representation thereof and shows
the size and location of the property, its exterior boundaries, the location
of all visible structures and dimensions of all principal buildings thereon,
boundary fences, apparent easements, roadways, and visible encroachments, if
any, and that I have surveyed the property hereon described, according to the
official records, to the best of my knowledge and belief.
May 12, 1992

George T. Dunham
George T. Dunham, Surveyor

