


DUNHAM SURVEYING, S.C.
SURVEYING & SUBDIVIDING
DELAVER, WISCONSIN 53115



SEVENTH

STREET

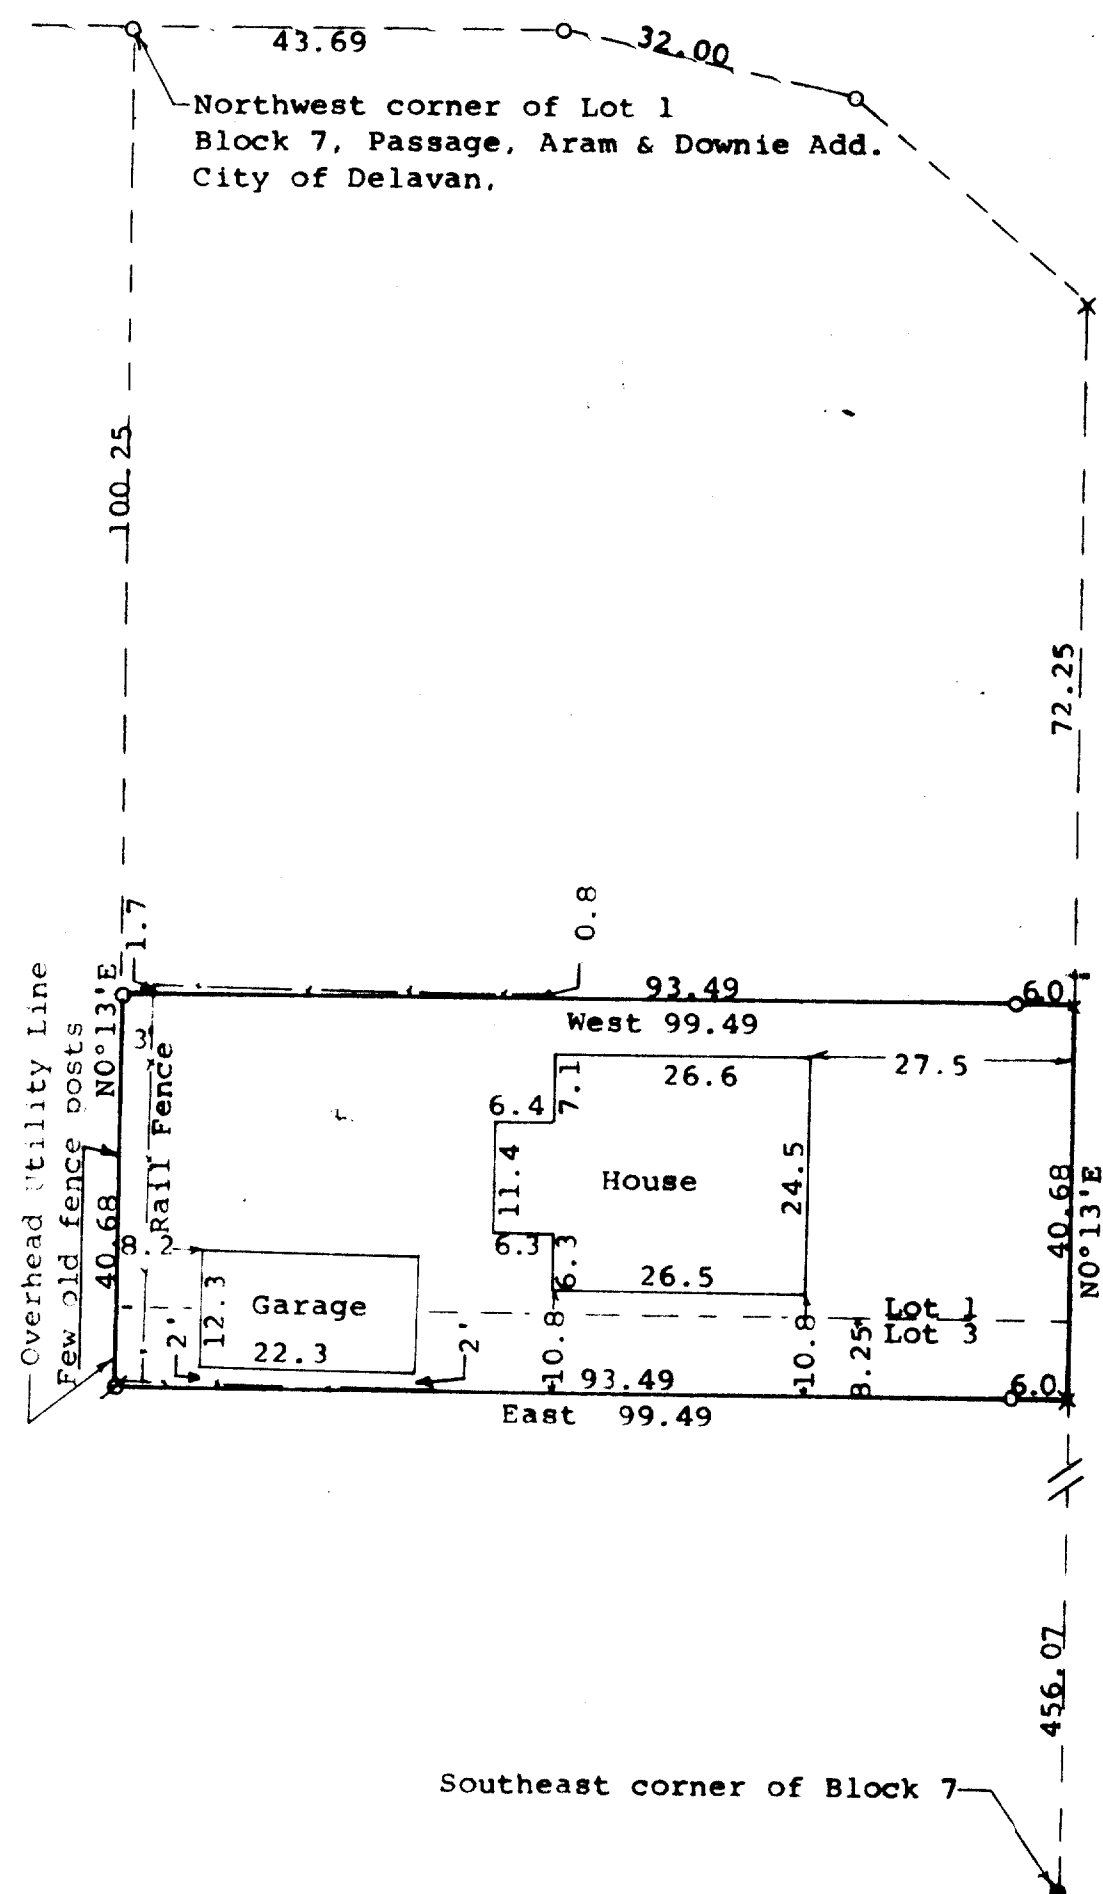

Scale - 1" = 20'

- = Concrete Monument Found
- = 3/4" X 24" Iron Pipe Set
- x = cross cut in concrete
- ⊘ = 1/2" X 24" Iron Pipe Set

Bearings referenced to the west line of Seventh Street with the assumed bearing of N0°13'E

Survey ordered by:
Arthur Johnson
111 West Washington Street
Delavan, WI 53115

--- = Fence Line

STATE OF WISCONSIN) SS
COUNTY OF WALWORTH)

I, George T. Dunham, Surveyor, certify that I have surveyed the property described as follows:

Lot 1, Block 7, except the North 100.25 feet thereof and the North 8.25 feet of the East 99 feet of Lot 3, Block 7, Passage, Aram, & Downie Addition, City of Delavan, Walworth County, Wisconsin,

and that the plat shown hereon is a correct representation thereof and shows the size and location of the property, its exterior boundaries, the location of all visible structures and dimensions of all principal buildings thereon, boundary fences, apparent easements, roadways and visible encroachments, if any, and that I have surveyed the property hereon described, according to the official records, to the best of my knowledge and belief.

August 5, 1991

George T. Dunham
George T. Dunham, Surveyor

