


DUNHAM SURVEYING, S.C.
SURVEYING & SUBDIVIDING
DELAVER, WISCONSIN 53115

N

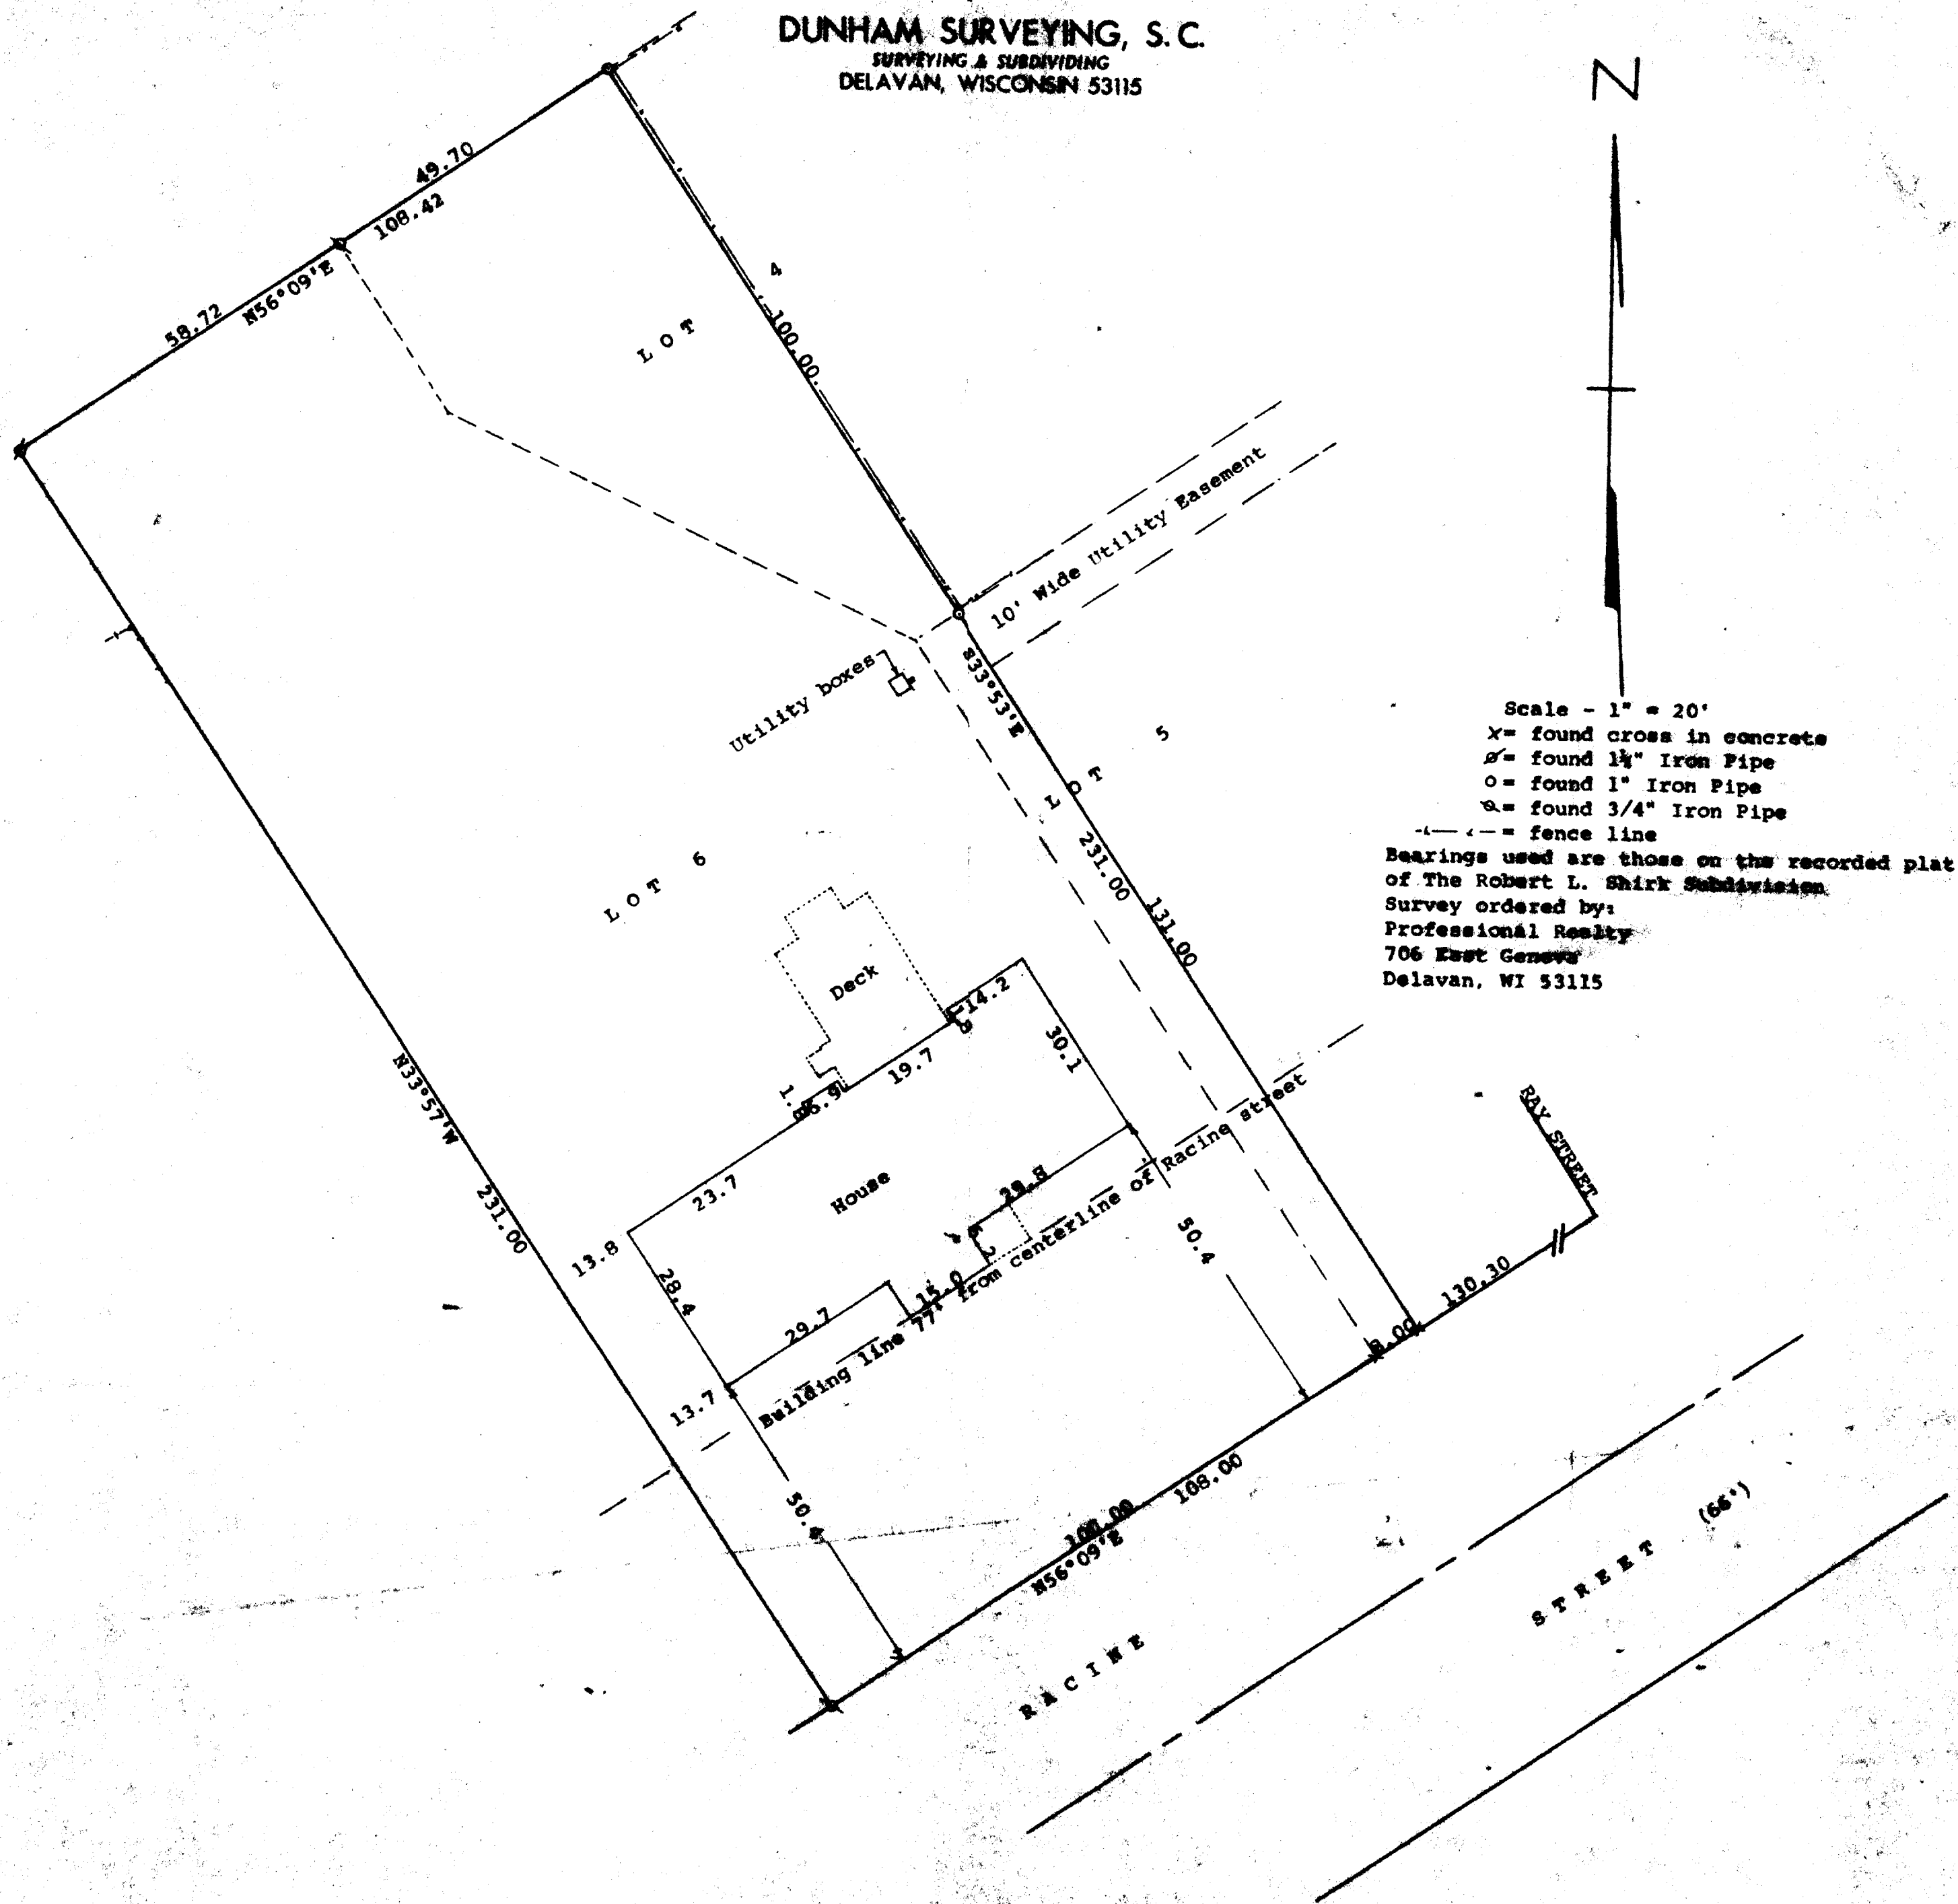

STATE OF WISCONSIN)
COUNTY OF WAUKESHA)

I, George T. Dunham, Surveyor, certify that I have surveyed the property described as follows:

Lots 4, 5, and 6 of the Robert L. Shirk Subdivision located in the City of Delavan, Walworth County, Wisconsin, EXCEPTING THEREFROM the Northeastern 148.30 feet of said Lots 4 and 5 of the Robert L. Shirk Subdivision, subject to easements of record, and that the plat shown hereon is a correct representation thereof and shows the size and location of the property, its adjacent boundaries, the location of all visible structures and dimensions of all principal buildings thereon, boundary fences, apparent easements, and any and visible encroachments, if any, and that I have surveyed the property shown described, according to the official records, to the best of my knowledge and belief.
August 6, 1992

George T. Dunham
George T. Dunham, Surveyor

