


DUNHAM SURVEYING, S.C.
SURVEYING & SUBDIVIDING
DELAVER, WISCONSIN 53115

FIFTH

STREET

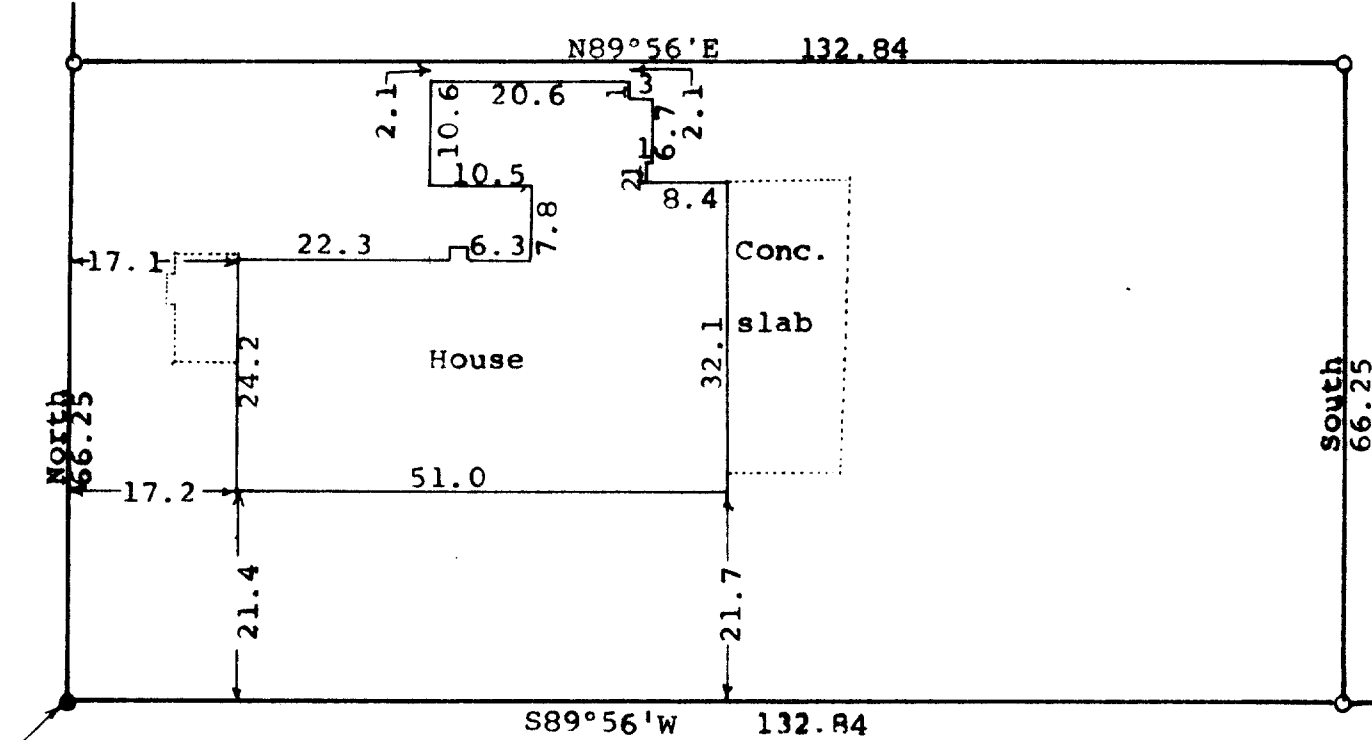

Southwest corner of Lot 15,
Block 6, Passage, Aram & Downie
Addition to the City of Delavan

WASHINGTON

STREET

N

Scale - 1" = 20'

● = Concrete Monument Found
○ = 1" Iron Pipe Found

Bearings referenced to the east line of
Fifth Street with the assumed bearing of
North.

Survey ordered by:
The Rauland Agency
118 Kenosha
Walworth, WI 53184

STATE OF WISCONSIN) ss
COUNTY OF WALWORTH)

I, George T. Dunham, Surveyor, certify that I have surveyed the
property described as follows:

A part of Lot 15 in Block 6, Passage, Aram, & Downie Addition to
the Village, (Now City) of Delavan, Walworth County, Wisconsin,
described as follows: Beginning at the southwest corner of said
Lot 15; thence North along the west line of said Lot 15, 66.25 feet;
thence N89°56'E along the north line of said Lot 15, 132.84 feet;
thence South 66.25 feet; thence S89°56'W along the south line of
said Lot 15, 132.84 feet to the place of beginning.

and that the plat shown hereon is a correct representation thereof and shows
the size and location of the property, its exterior boundaries, the location
of all visible structures and dimensions of all principal buildings thereon,
boundary fences, apparent easements, roadways and visible encroachments, if
any, and that I have surveyed the property hereon described, according to the
official records, to the best of my knowledge and belief.
September 22, 1992

George T. Dunham
George T. Dunham, Surveyor

