


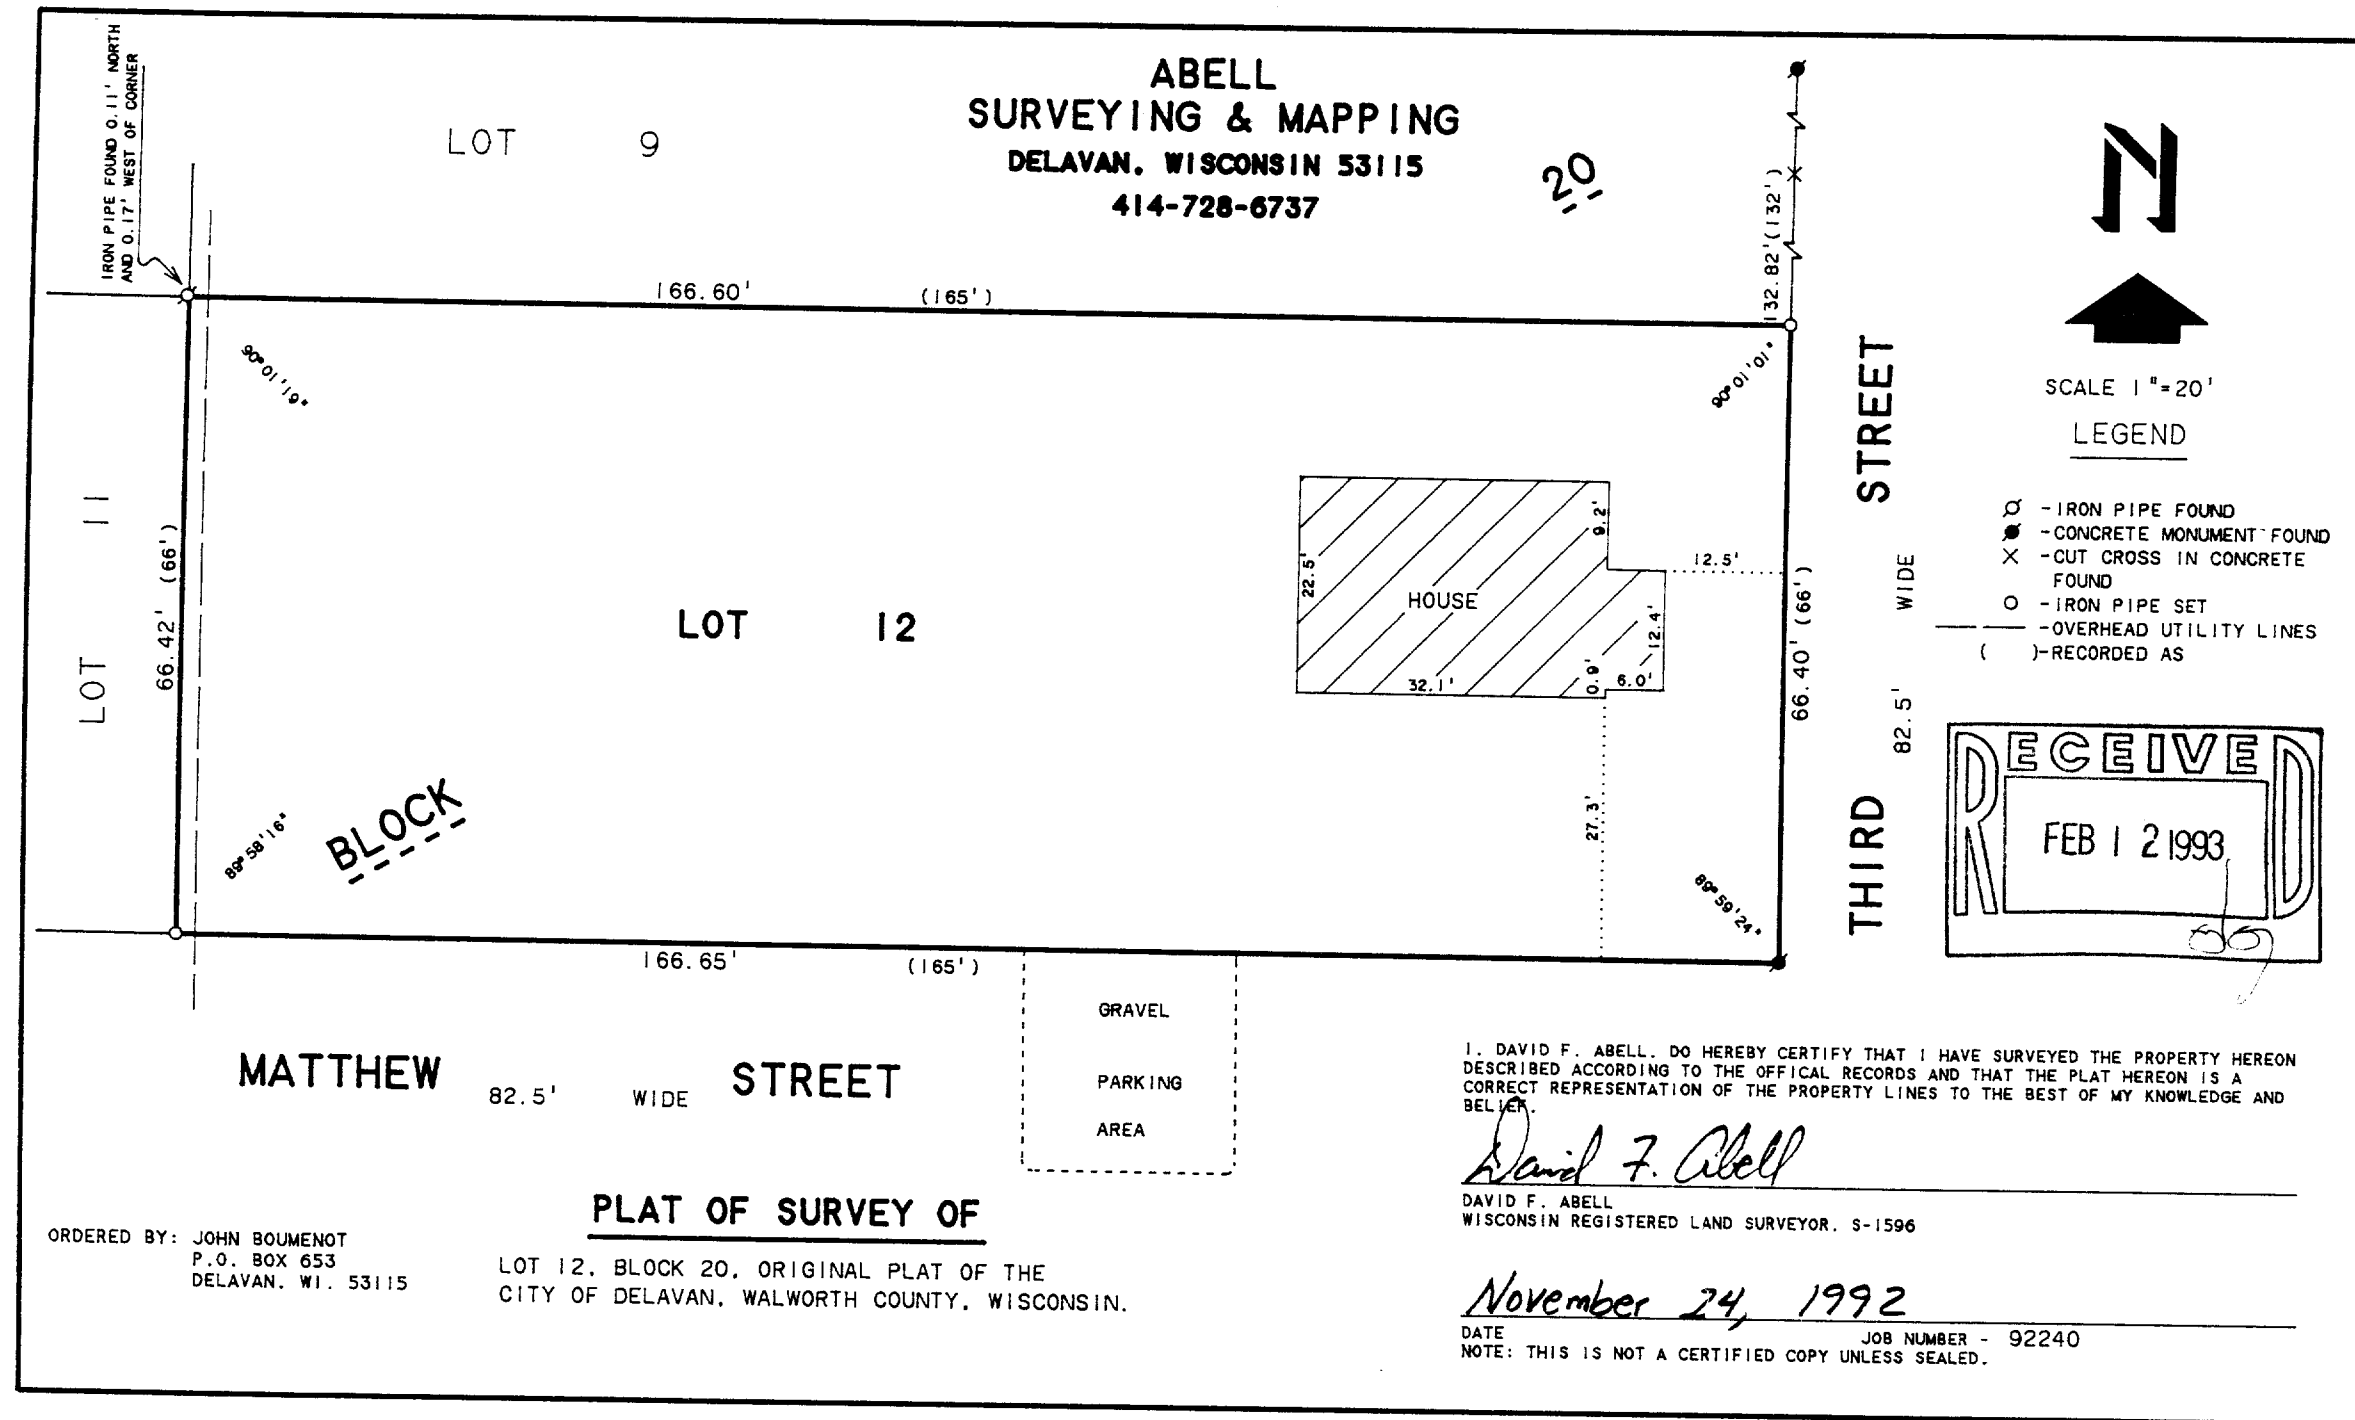

002-1225

XOP-215