


N

ELM

STREET

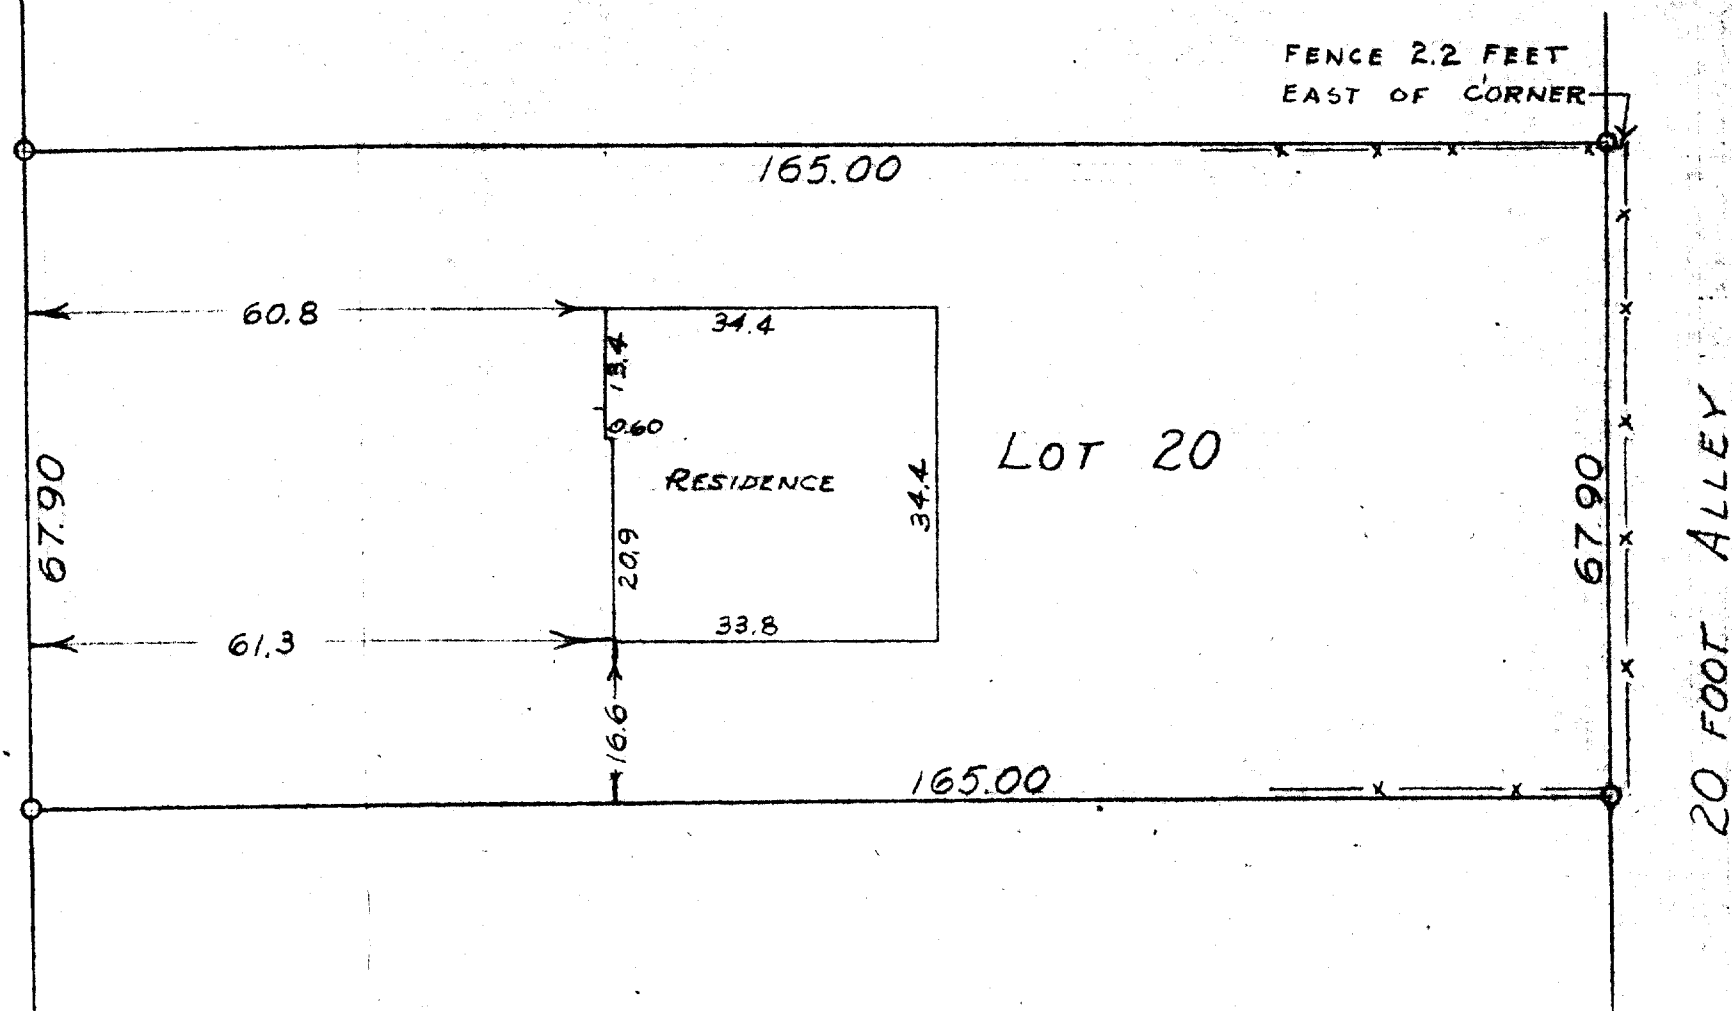

SCALE ~ 1" = 20'
O ~ IRON PIPE

STATE OF WISCONSIN } SS.
WALWORTH COUNTY }

I, GEORGE T. DUNHAM, DO HEREBY CERTIFY THAT I HAVE SURVEYED THE PROPERTY DESCRIBED AS FOLLOWS:

LOT 20, BLOCK 4 OF F. K. PHOENIX WEST ADDITION TO THE CITY OF DELAVAN, WALWORTH COUNTY, WISCONSIN.

AND THAT THE PLAT SHOWN ABOVE IS A CORRECT REPRESENTATION OF THE PROPERTY LINES AND THE IMPROVEMENTS LOCATED THEREON.
AUGUST 22, 1958

George T. Dunham
GEORGE T. DUNHAM, SURVEYOR
DELAVAN, WISCONSIN.

2-123