


DUNHAM SURVEYING S.C.
SURVEYING & SUBDIVISION
DELAVER, WISCONSIN 53115

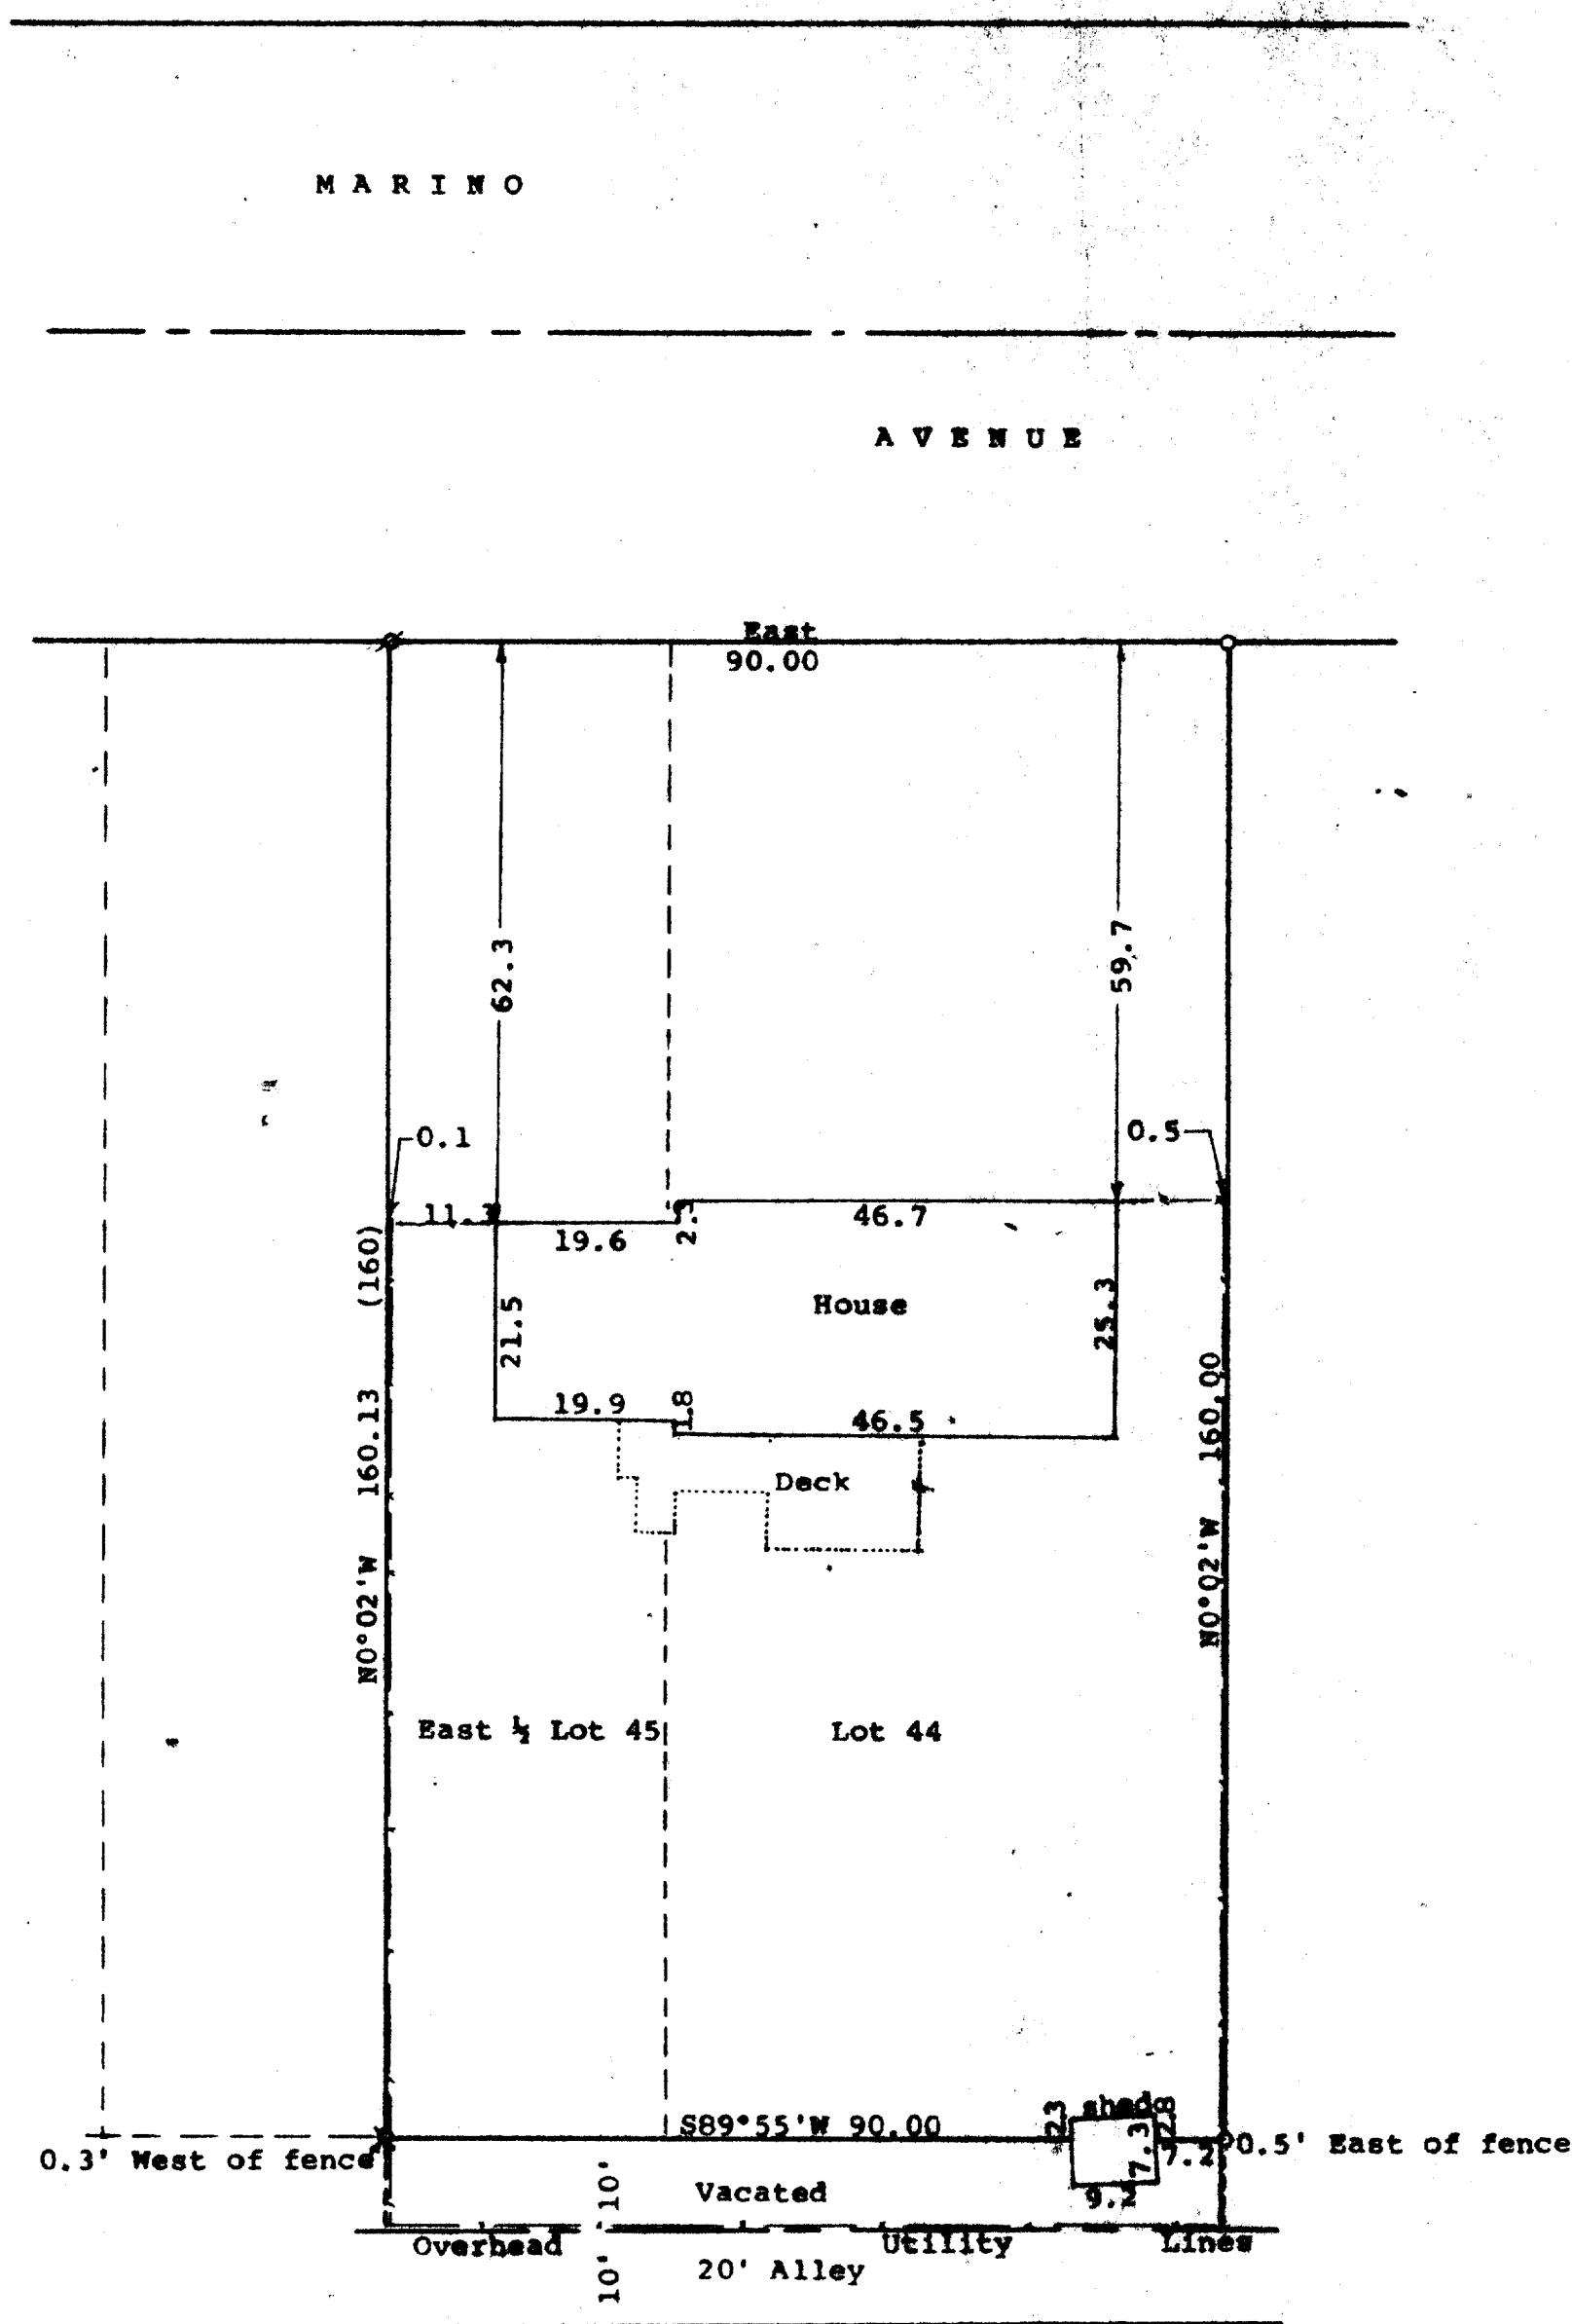

Scale - 1" = 20'
 S = 1 1/4" Iron Pipe Found
 O = 1" Iron Pipe Found
 Q = 3/4" Iron Pipe Found
 --- = Fence Line
 Bearings referenced to the south line of Marino Avenue with the assumed bearing of East
 Survey ordered by:
 Realty World, Garman Realtors
 811 East Geneva St
 Delavan, WI 53115

STATE OF WISCONSIN)SS
 COUNTY OF WALWORTH)

I, George T. Dunham, Surveyor, certify that I have surveyed the property described as follows:
 Lot 44 and the East 1/4 of Lot 45 of Mar-Del Estates, a subdivision located in the City of Delavan, Walworth County, Wisconsin, and that the plat shown hereon is a correct representation thereof and shows the size and location of the property, its exterior boundaries, the location of all visible structures and dimensions of all principal buildings thereon, boundary fences, apparent easements, roadways and visible encroachments, if any, and that I have surveyed the property hereon described, according to the official records, to the best of my knowledge and belief.
 May 21, 1992

George T. Dunham
 George T. Dunham, Surveyor

