


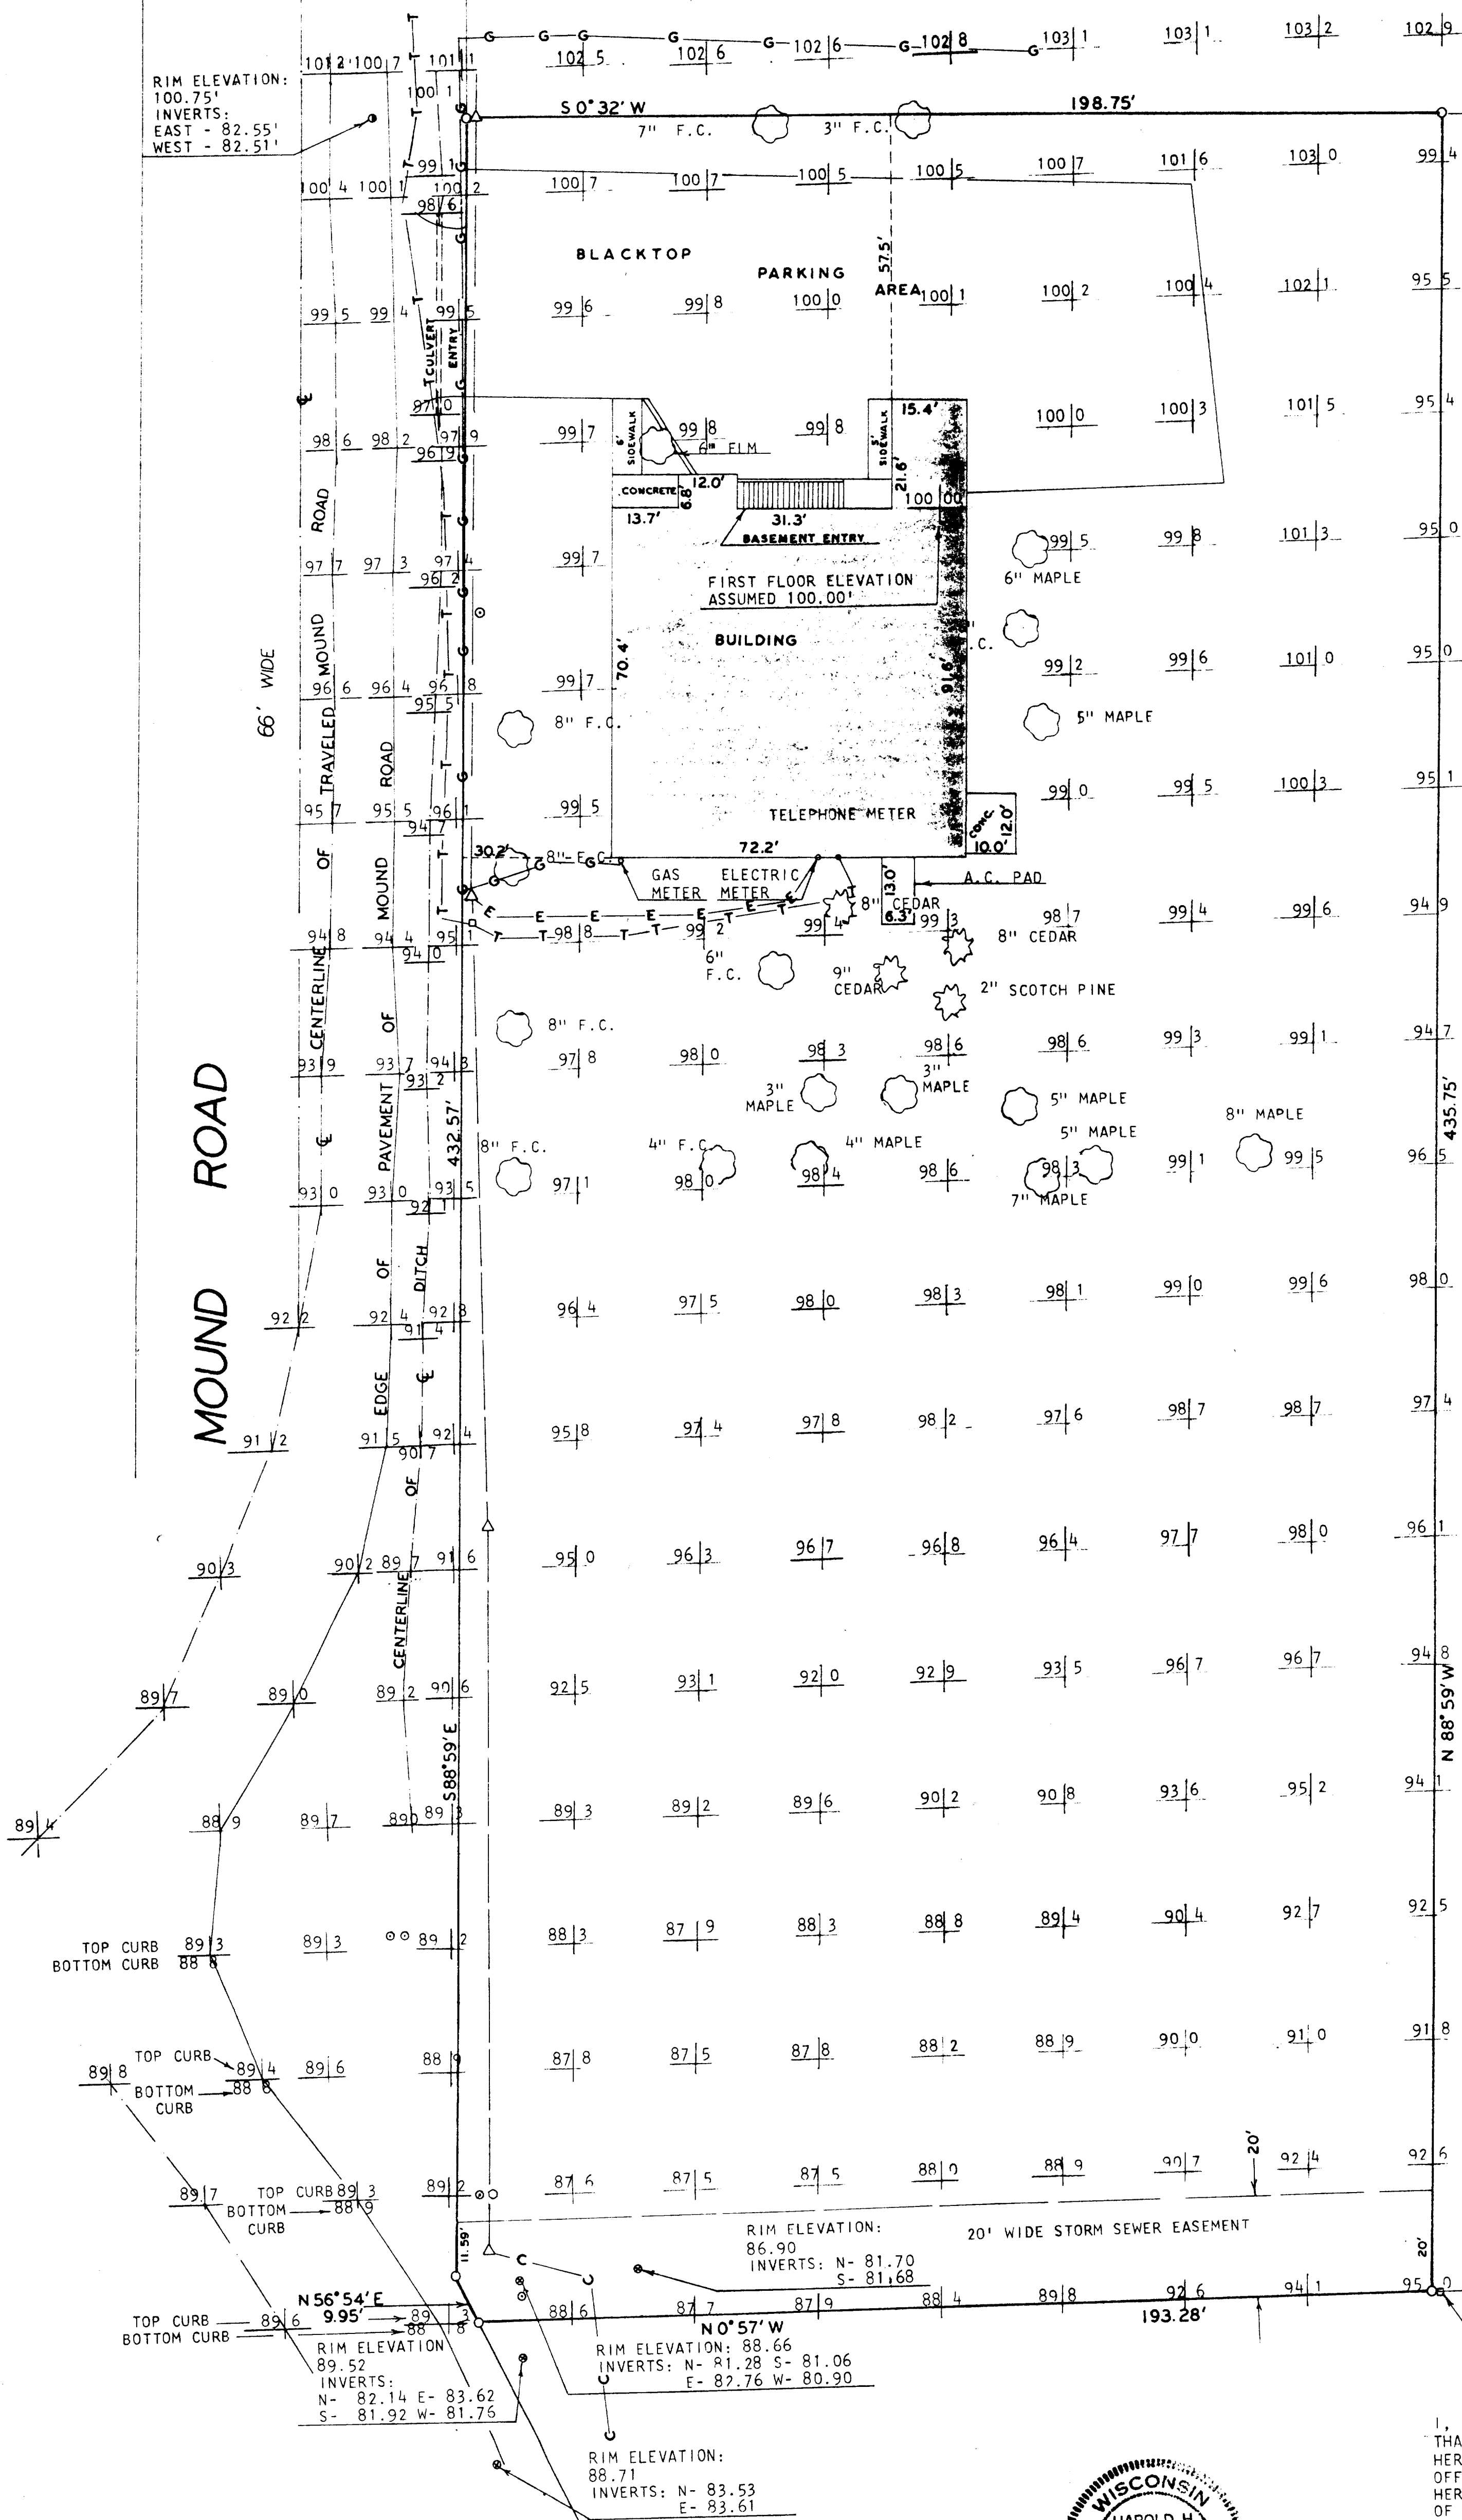


NOTE: SANITARY SEWER LINE IS 10' SOUTH
OF CENTERLINE OF MOUND ROAD
WATER LINE IS 20' SOUTH OF
CENTERLINE OF MOUND ROAD

ORDERED BY: DELAVAN ENTERPRISE %
ANGUS-YOUNG ASSOCIATES
51 S. JACKSON STREET
JANESVILLE, WI. 53445

NOTE: BEARINGS ARE ASSUMED AS SHOWN
ON LEGAL DESCRIPTION..

TOPOGRAPHIC PLAT OF
A PARCEL OF LAND LOCATED IN THE
NORTHEAST 1/4 OF SECTION 17, T2N,
R16E, CITY OF DELAVAN, WALWORTH
COUNTY, WISCONSIN.

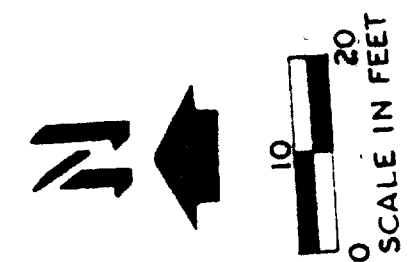

LEGEND

- Ø - IRON PIPE FOUND
- - IRON PIPE SET
- - CONCRETE MONUMENT
- F.C. - FLOWERING CRAB
- △ - UTILITY POLE
- OVERHEAD UTILITY LINE
- - UTILITY PEDISTAL
- ⊗ - STORM SEWER
- ⦿ - SANITARY SEWER
- ⊙ - WATER VALVE
- G——G - UNDERGROUND GAS LINE
- E——E - UNDERGROUND ELEC. LINE
- T——T - UNDERGROUND TELEPHONE LINE
- C——C - UNDERGROUND T.V. CABLE

I, HAROLD H. KOLB, DO HEREBY CERTIFY THAT I HAVE SURVEYED THE PROPERTY HEREON DESCRIBED ACCORDING TO THE OFFICIAL RECORDS AND THAT THE PLAT HEREON IS A CORRECT REPRESENTATION OF THE LOT LINES TO THE BEST OF MY KNOWLEDGE AND BELIEF.
SURVEY NOT VALID UNLESS SURVEYOR'S SIGNATURE IS IN RED.

Harold H. Kolb
HAROLD H. KOLB
WISCONSIN REGISTERED LAND SURVEYOR, S-197
DATE: July 23, 1992
REVISED: AUGUST 7, 1992
REVISED: AUGUST 13, 1992

002-1236

DAJ-VP-196