


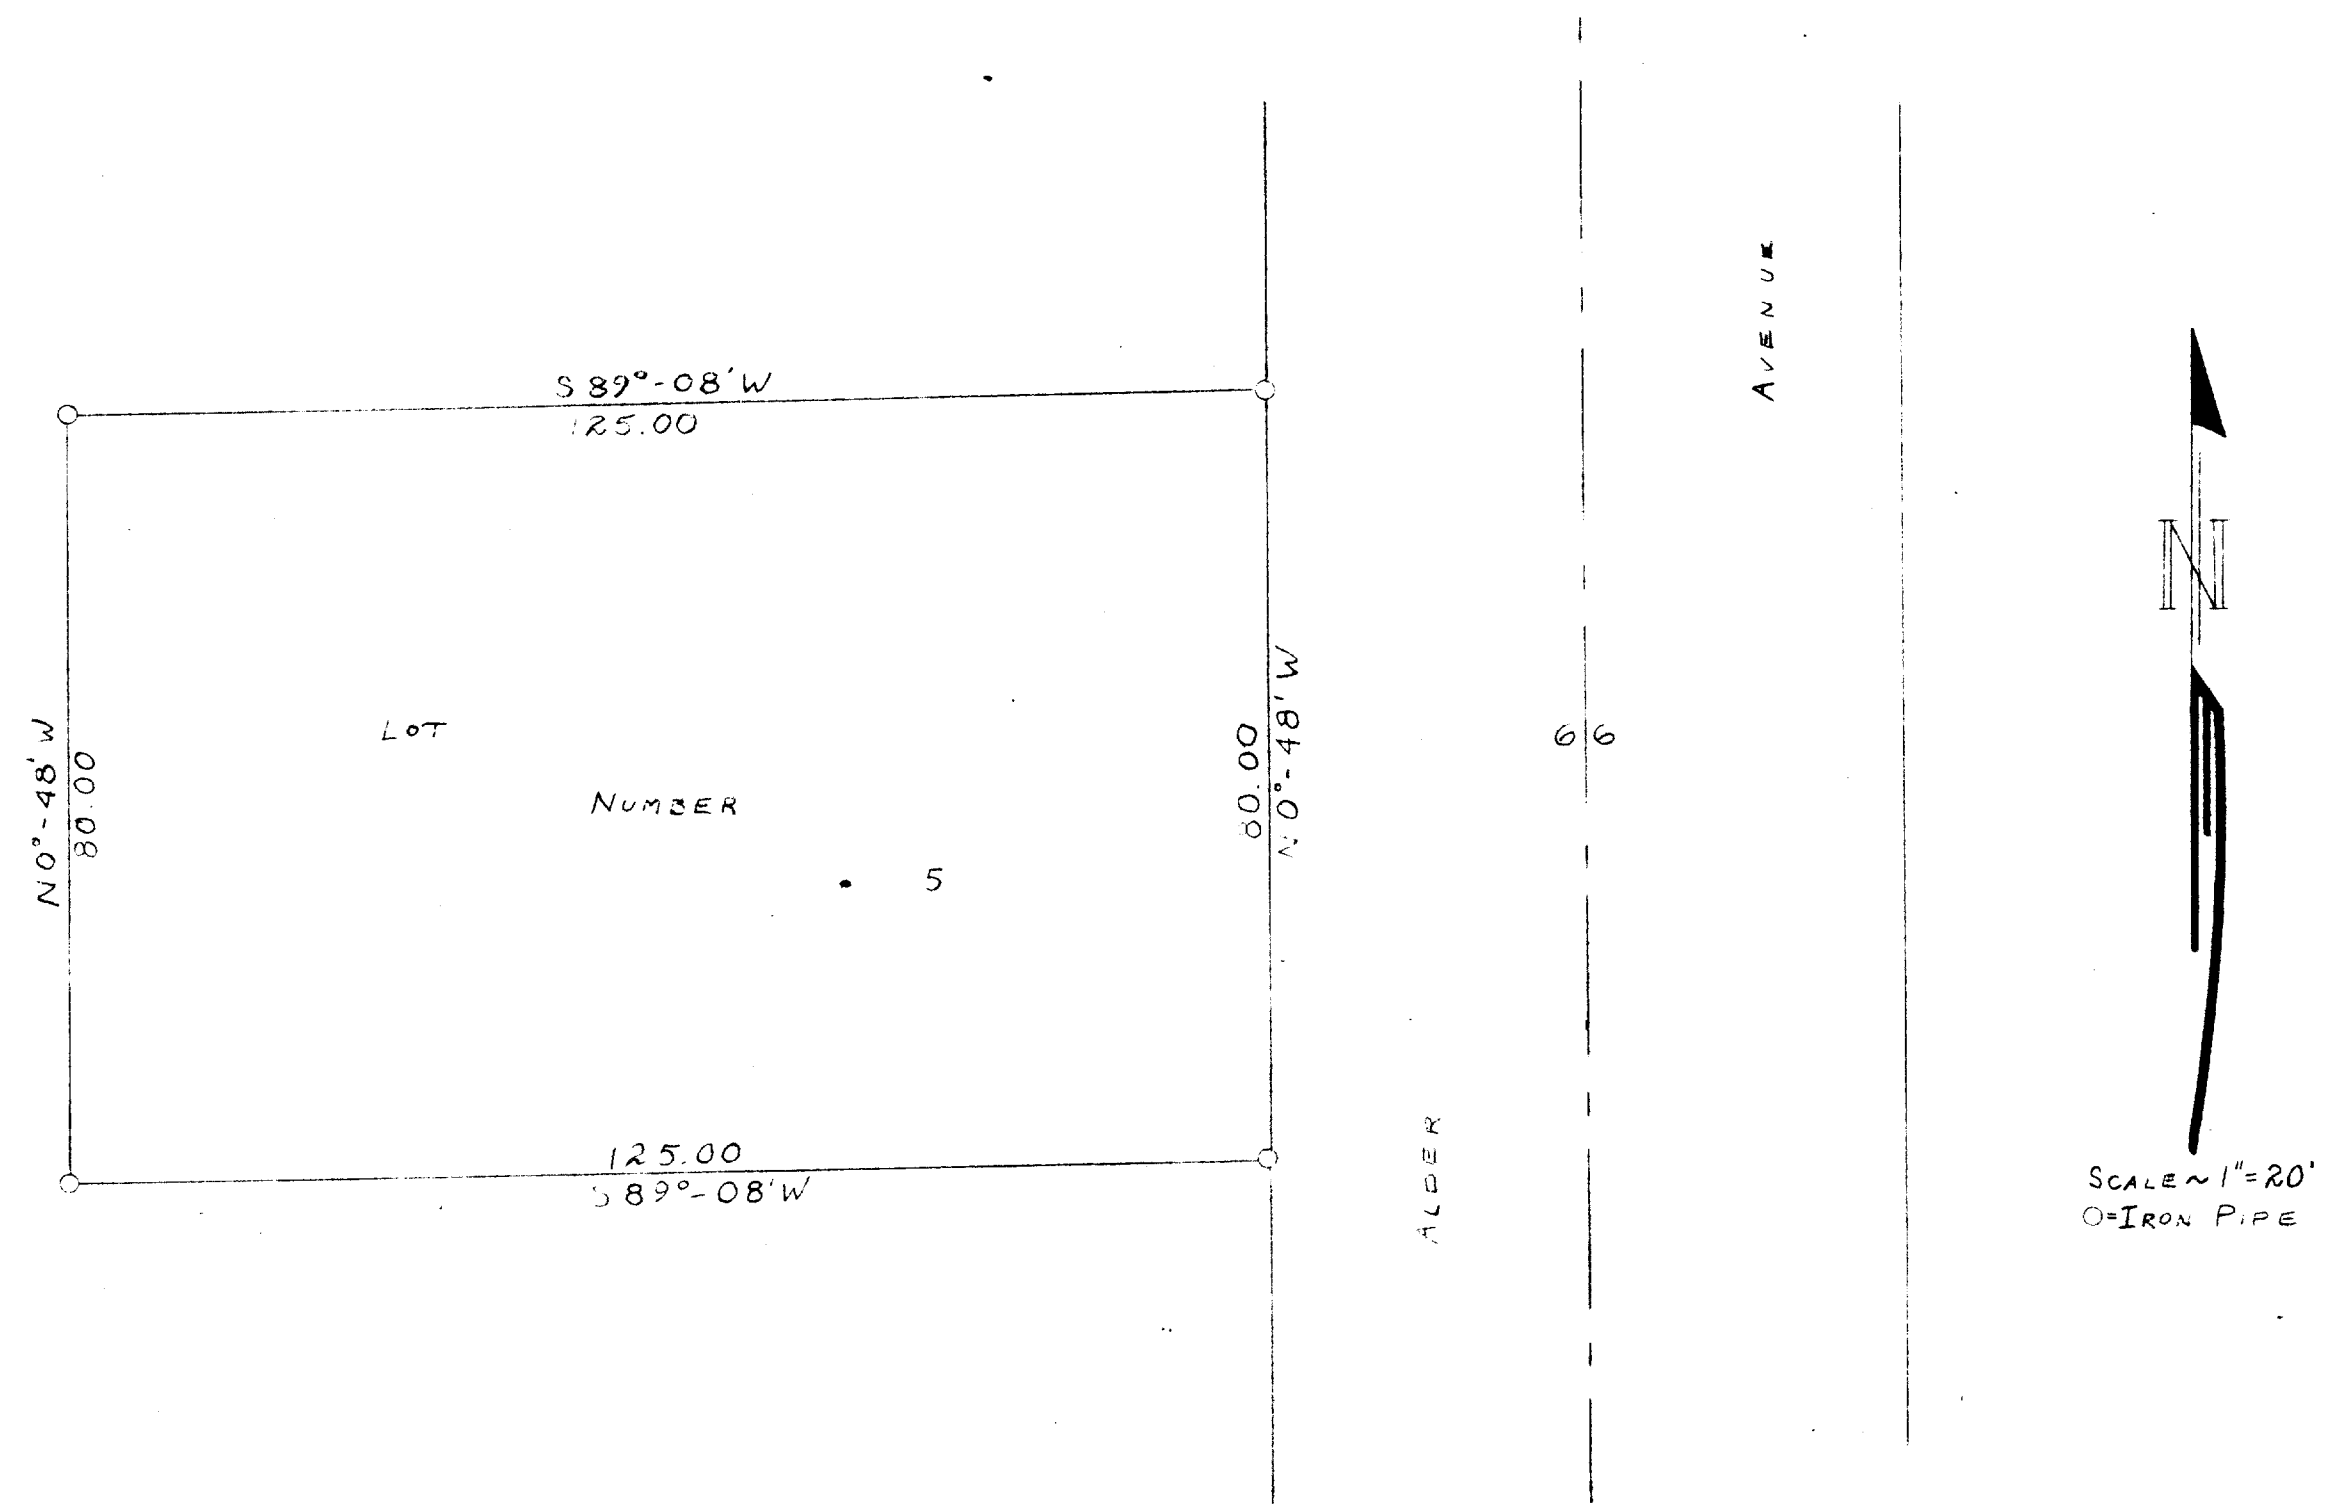

STATE OF WISCONSIN) SS
NORTH COUNTY)

I, GEORGE T. DUNHAM, DO HEREBY CERTIFY THAT I HAVE SURVEYED LOT 5, BLOCK 3, OF ALLYNHURST SUBDIVISION IN THE CITY OF DELAWARE, WISCONSIN; AND THAT THE ABOVE PLAT IS A CORRECT REPRESENTATION OF THE PROPERTY LINES
AUGUST 14, 1959

George T. Dunham
GEORGE T. DUNHAM, SURVEYOR
DELAWARE, WISCONSIN