
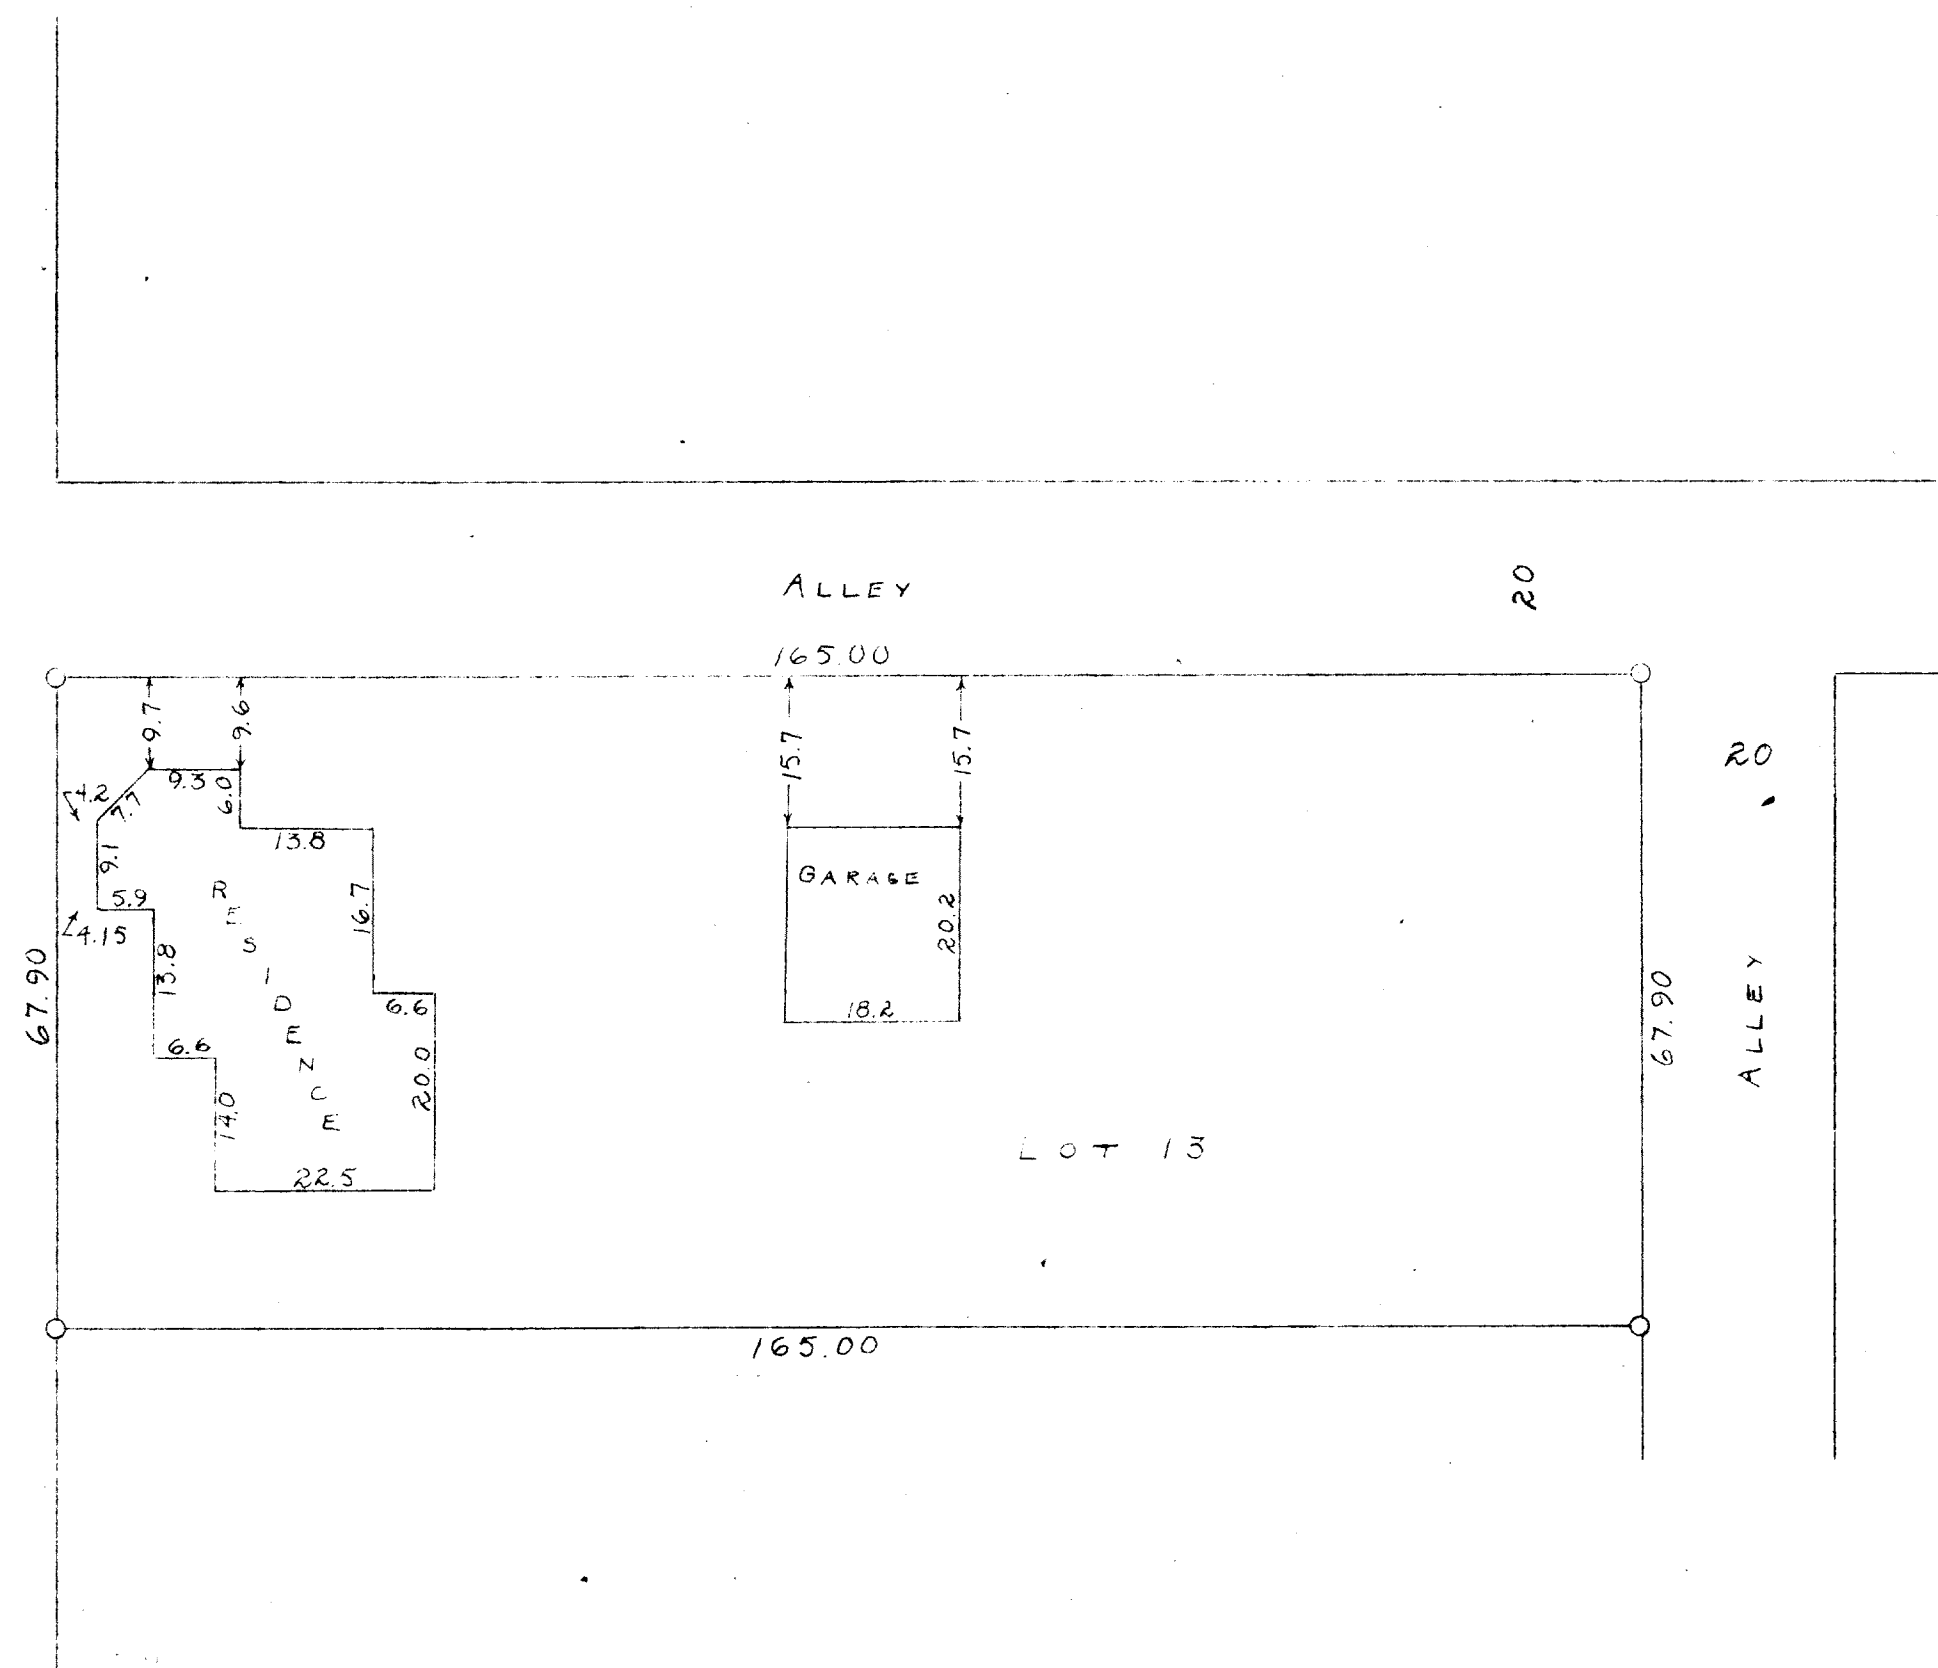


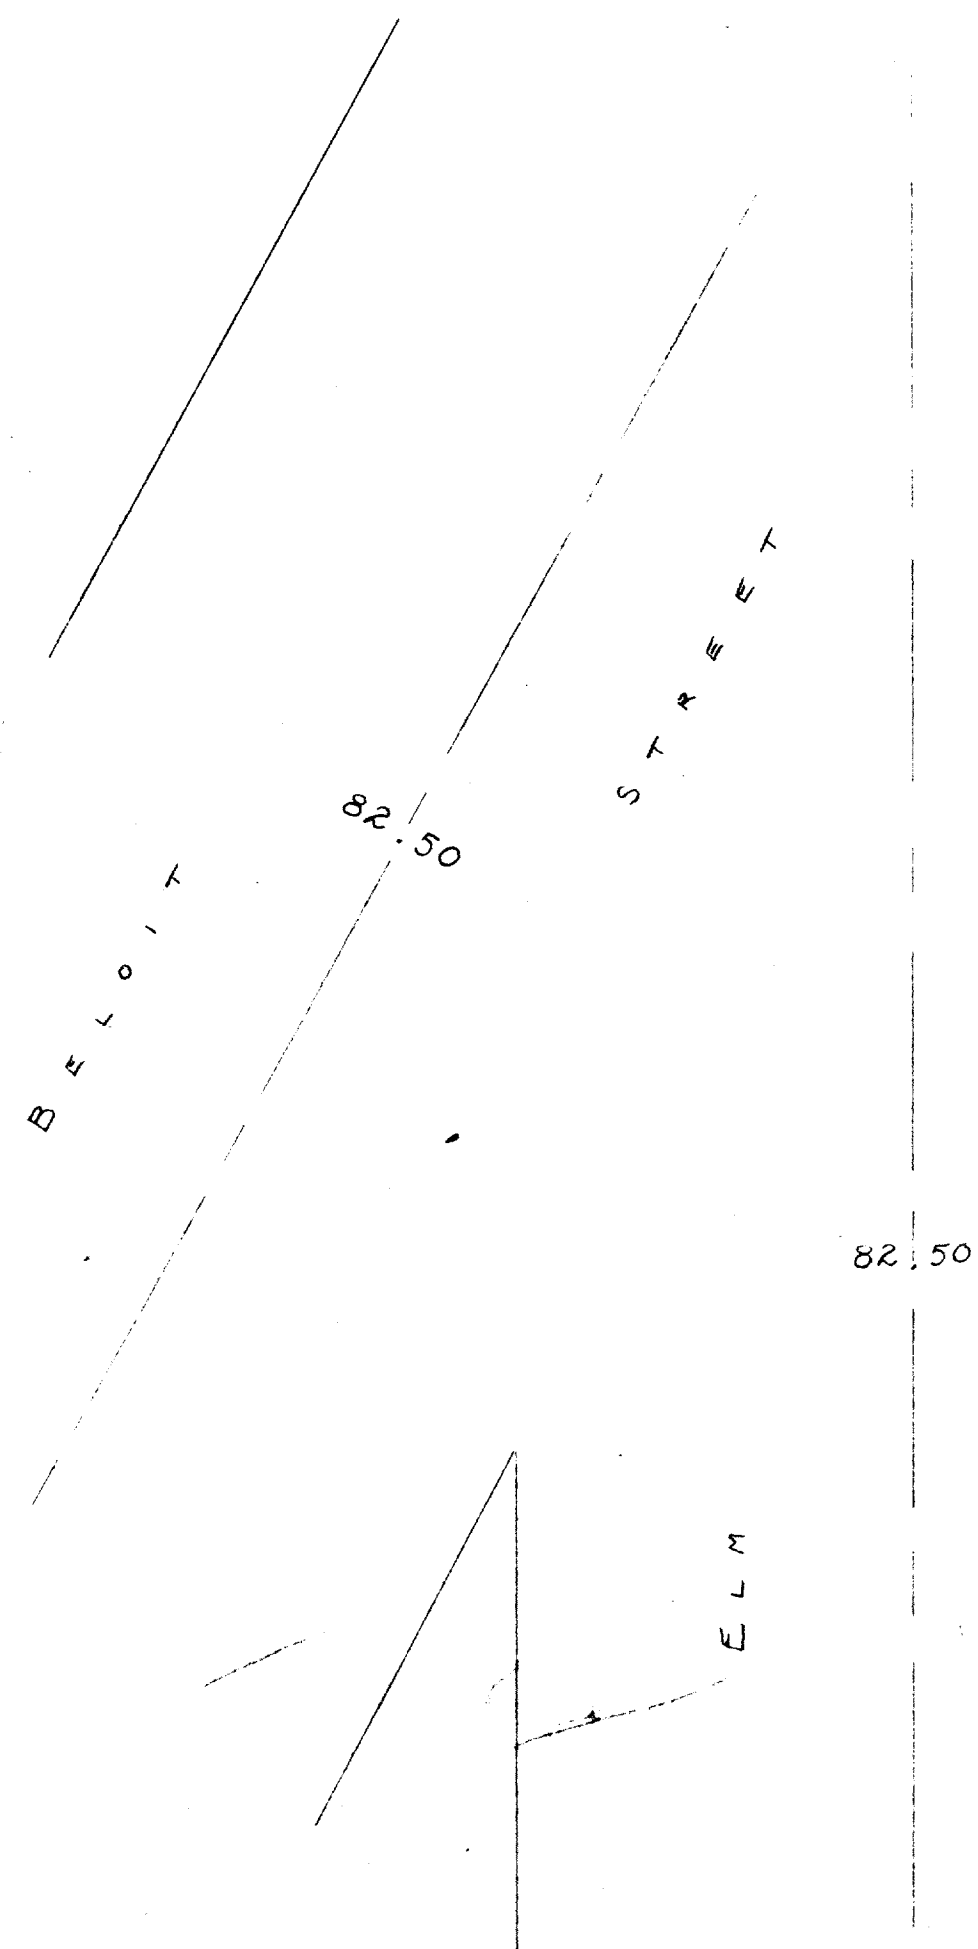

SCALE 1"=20'
O = IRON PIPE

STATE OF WISCONSIN) SS
WALWORTH COUNTY) -
I, GEORGE T. DUNHAM, DO HEREBY CERTIFY THAT I HAVE SURVEYED THE
PROPERTY DESCRIBED AS FOLLOWS:
LOT 13, BLOCK 4 OF THE F.K. PHOENIX WEST ADDITION TO THE CITY
OF DELAVAN, WALWORTH COUNTY, WISCONSIN.
AND THAT THE PLAT SHOWN ABOVE IS A CORRECT REPRESENTATION OF THE PROPERTY
LINES AND OF THE IMPROVEMENTS LOCATED THEREON
SEPTEMBER 3, 1959

George T. Dunham
GEORGE T. DUNHAM, SURVEYOR
DELAVAN, WISCONSIN