


ABELL
SURVEYING & MAPPING
DELAVAN, WISCONSIN 53115
414-728-6737



PLAT OF SURVEY OF

LOT 45, WHISPERING PINES, LOCATED IN
THE CITY OF DELAVAN, WALWORTH COUNTY,
WISCONSIN.

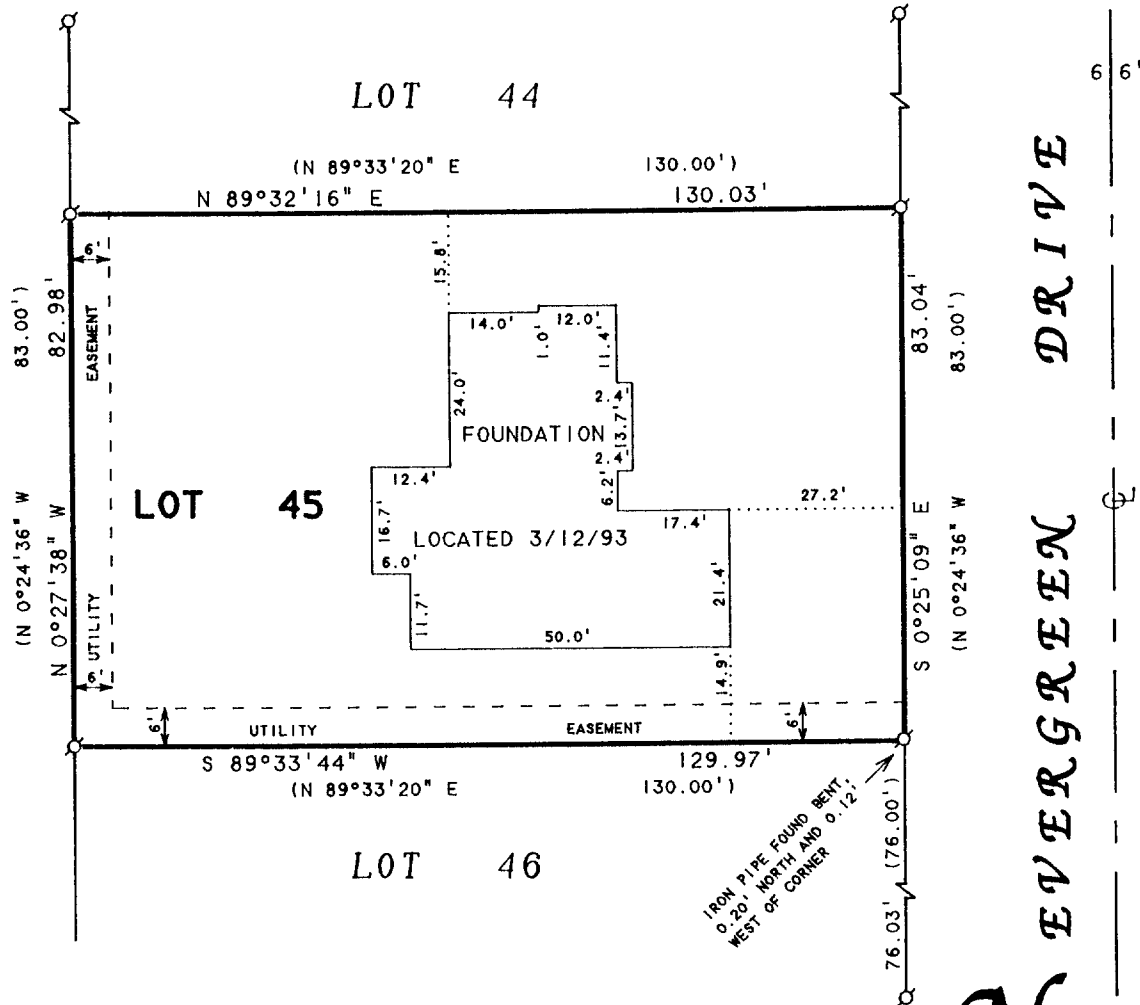


SCALE 1"=30'

LEGEND

Ø - IRON PIPE FOUND
() - RECORDED AS

ORDERED BY: DESCHNER BUILDING CONTRACTORS
3338 NORTH SHORE DRIVE
DELAHAN, WI 53115

NOTE: BEARINGS ARE REFERENCED TO THE
RECORDED SUBDIVISION PLAT.

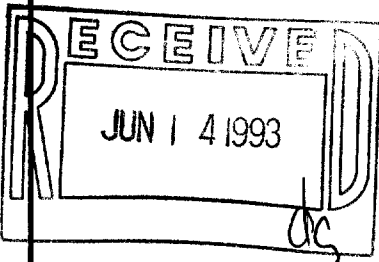

I HEREBY CERTIFY THAT I HAVE SURVEYED THE ABOVE DESCRIBED PROPERTY AND THAT THE
ABOVE MAP IS A TRUE REPRESENTATION THEREOF AND SHOWS THE SIZE AND LOCATION OF
THE PROPERTY, ITS EXTERIOR BOUNDARIES, THE LOCATION OF ALL VISIBLE STRUCTURES
AND DIMENSIONS OF ALL PRINCIPAL BUILDINGS THEREON, BOUNDARY FENCES, APPARENT
EASEMENTS, ROADWAYS AND VISIBLE ENCROACHMENTS, IF ANY, TO THE BEST OF MY
KNOWLEDGE AND BELIEF.

THIS SURVEY IS MADE FOR THE USE OF THE PRESENT OWNERS OF THE PROPERTY, AND ALSO
THOSE WHO PURCHASE, MORTGAGE, OR GUARANTEE THE TITLE THERETO WITHIN ONE (1) YEAR
FROM DATE HEREON.

David F. Abell

DAVID F. ABELL
WISCONSIN REGISTERED LAND SURVEYOR, S-1596

March 15, 1993

DATE JOB NUMBER - 93029
NOTE: THIS IS NOT A CERTIFIED COPY UNLESS SEALED.

XWP-45

002-1251