


DUNHAM SURVEYING, S.C.
SURVEYING & SUBDIVIDING
DELAVER, WISCONSIN 53115

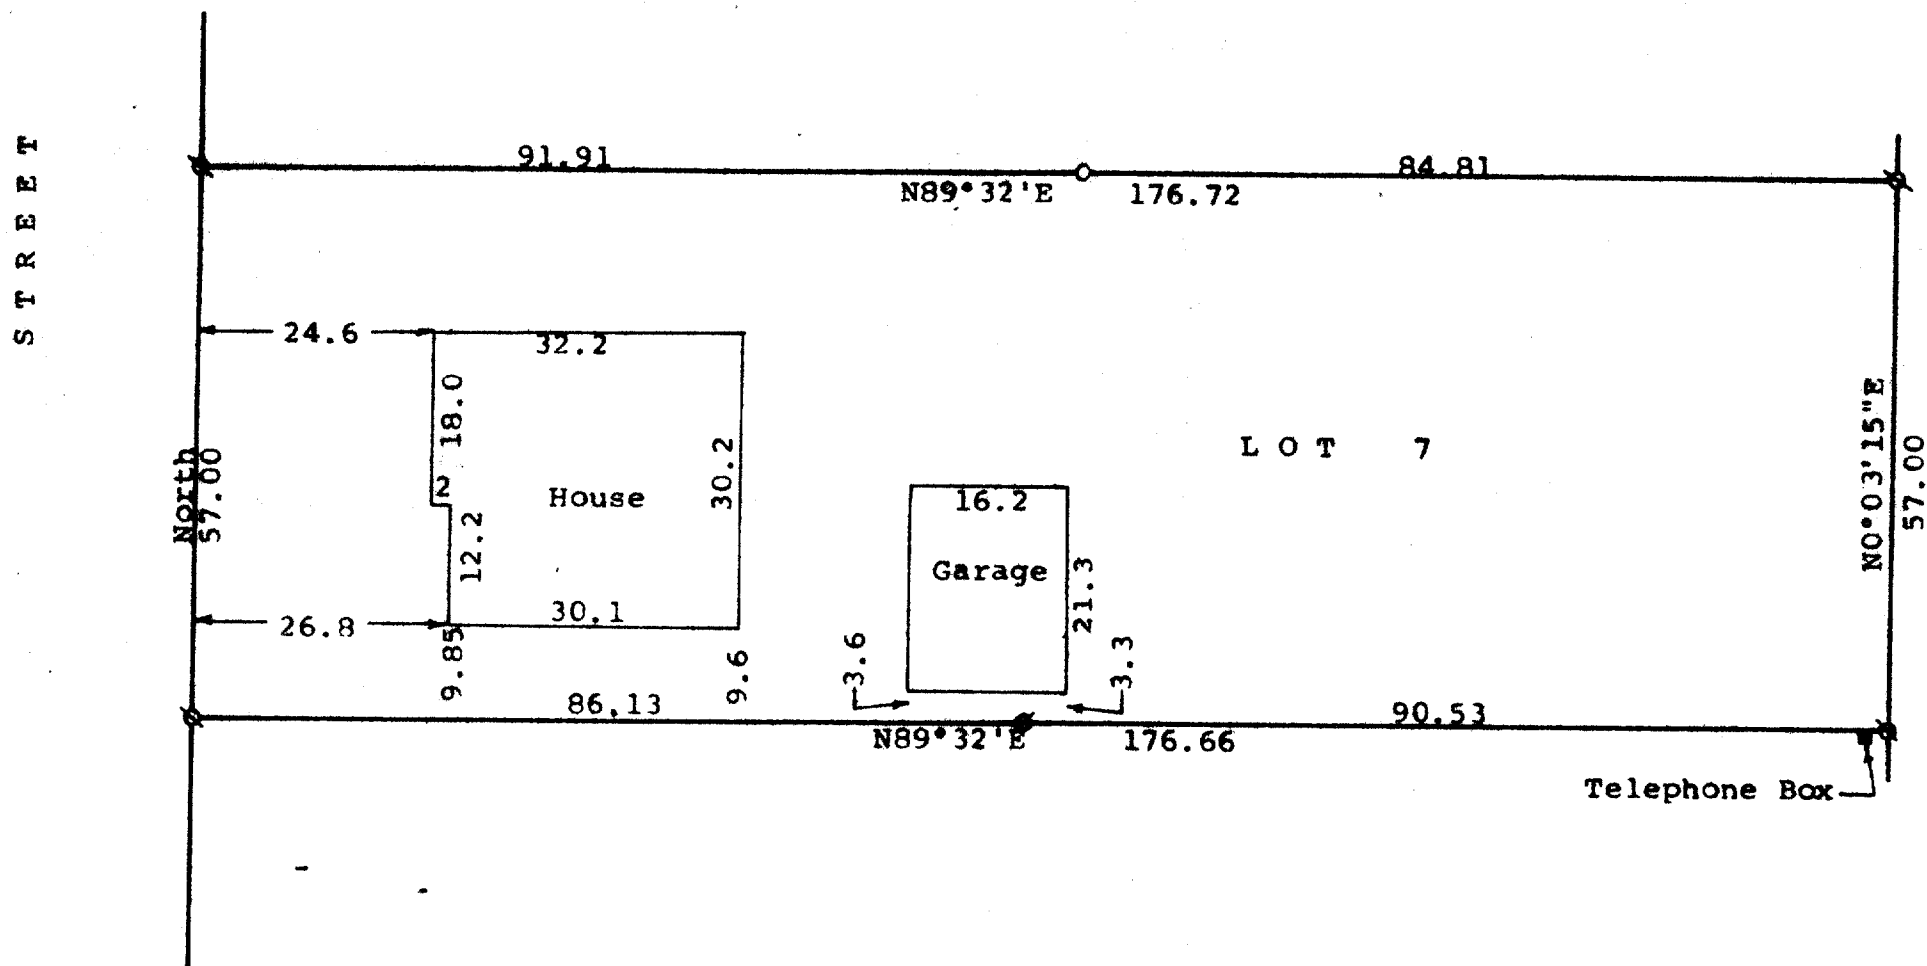

Scale - 1" = 20'
 N = 3/4" Iron Pipe Found
 Ø = 1/2" Iron Pipe Found
 O = 1/2" X 24" Iron Pipe Set
 Bearings referenced to the east line
 of Seventh Street with the assumed
 bearing of North.
 Survey ordered by:
 Orlo Brown, Personal Representative
 of the Estate of Ora A. Rice,
 Deceased
 Delavan, WI 53115



STATE OF WISCONSIN)
 COUNTY OF WALWORTH) SS

I, George T. Dunham, Surveyor, certify that I have surveyed the
 property described as follows:

Lot 7 in Block 1 of Fairview Heights, a subdivision located in
 the City of Delavan, Walworth County, Wisconsin, subject to
 easements of record.

and that the plat shown hereon is a correct representation thereof and shows
 the size and location of the property, its exterior boundaries, the location
 of all visible structures and dimensions of all principal buildings thereon,
 boundary fences, apparent easements, roadways and visible encroachments, if
 any, and that I have surveyed the property hereon described, according to the
 official records, to the best of my knowledge and belief.
 May 3, 1993

George T. Dunham
 George T. Dunham, Surveyor

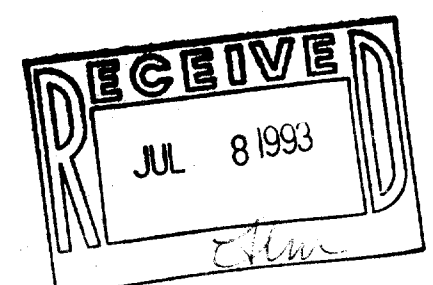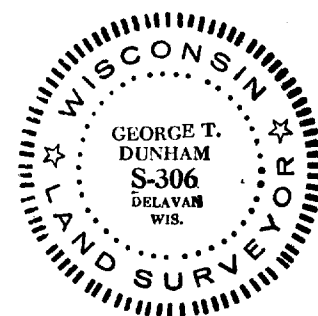

XFH-4

002-1266