
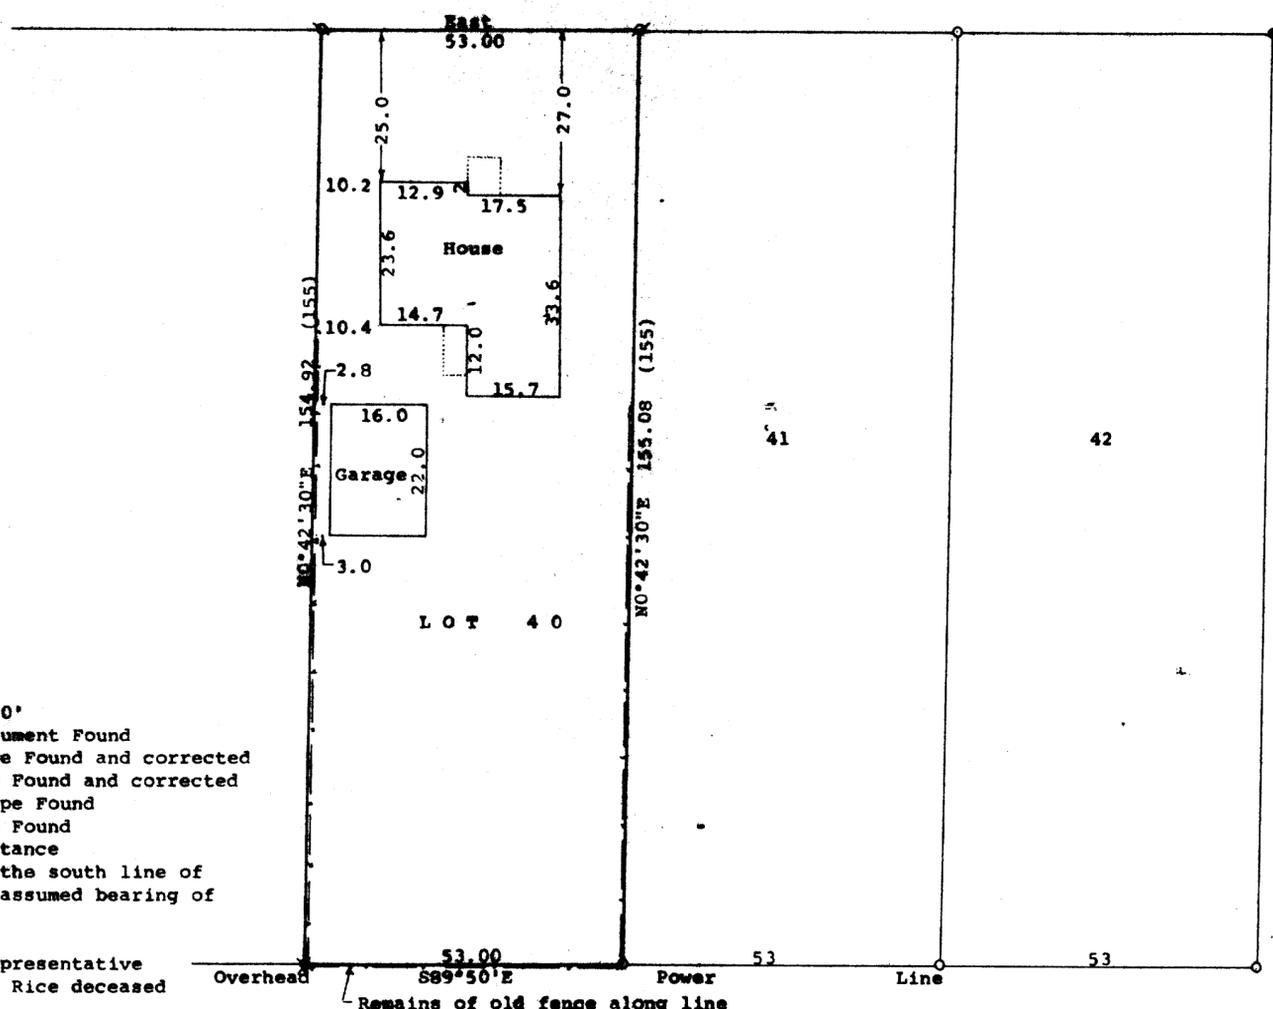
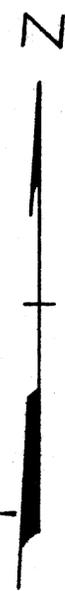


DUNHAM SURVEYING, S.C.

SURVEYING & SUBDIVISION
 DELAVAN, WISCONSIN 53115

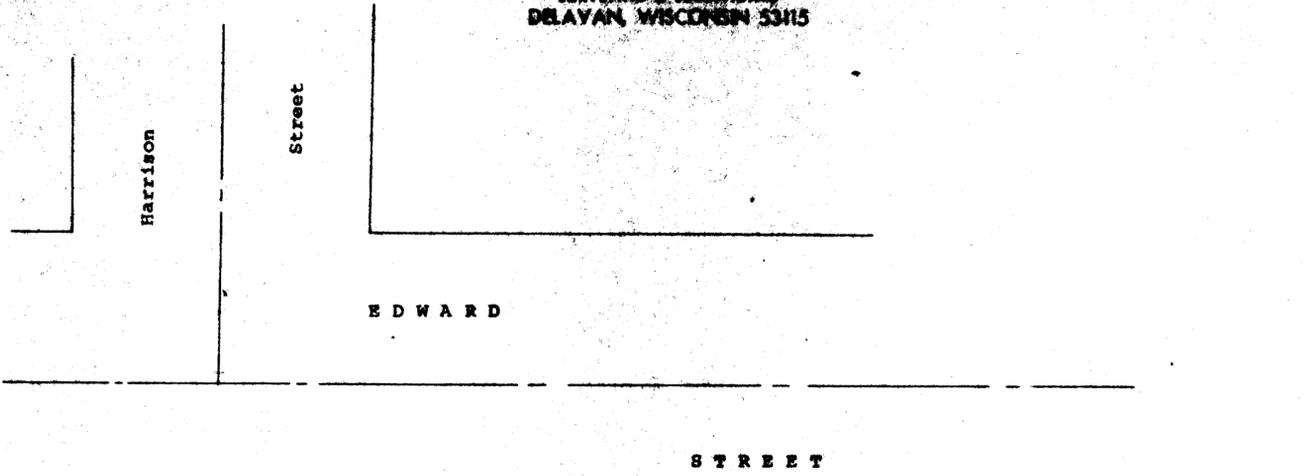

Scale - 1" = 20'

- = Concrete Monument Found
- ⊙ = 1 1/4" Iron Pipe Found and corrected
- ⊘ = 1" Iron Pipe Found and corrected
- ⊗ = 3/4" Iron Pipe Found
- = 1" Iron Pipe Found
- (0.00) = recorded distance

Bearings referenced to the south line of Edward Street with the assumed bearing of East

Survey ordered by:
 Orlo Brown, Personal Representative
 of the Estate of Ora A. Rice deceased
 Delavan, WI 53115

Overhead 53.00
 89°50'E
 Remains of old fence along line
 Power 53
 Line 53

STATE OF WISCONSIN) ss
 COUNTY OF WALWORTH)

I, George T. Dunham, Surveyor, certify that I have surveyed the property described as follows:

Lot 40, Tyrrell's Subdivision located in the City of Delavan, Walworth County, Wisconsin

and that the plat shown hereon is a correct representation thereof and shows the size and location of the property, its exterior boundaries, the location of all visible structures and dimensions of all principal buildings thereon, boundary fences, apparent easements, roadways and visible encroachments, if any, and that I have surveyed the property hereon described, according to the official records, to the best of my knowledge and belief.

April 26, 1993

George T. Dunham
 George T. Dunham, Surveyor

