


PLAT OF SURVEY

LOT 3 OF CERTIFIED SURVEY MAP NO. 1471
REC. IN VOL. 7 ON PG. 38 OF WAL. CTY. CSM'S
NE 1/4 OF THE SW 1/4 OF SEC. 17, T. 2 N., R. 16 E.
CITY OF DELAVAN, WALWORTH COUNTY, WI.

LEGEND

- = FOUND IRON REBAR STAKE
- = FOUND IRON PIPE STAKE
- = FOUND CONCRETE MONUMENT
- = RECORDED AS
- = UTILITY CONTROL BOX
- P.P. = POWER POLE
- L.P. = LIGHT POLE

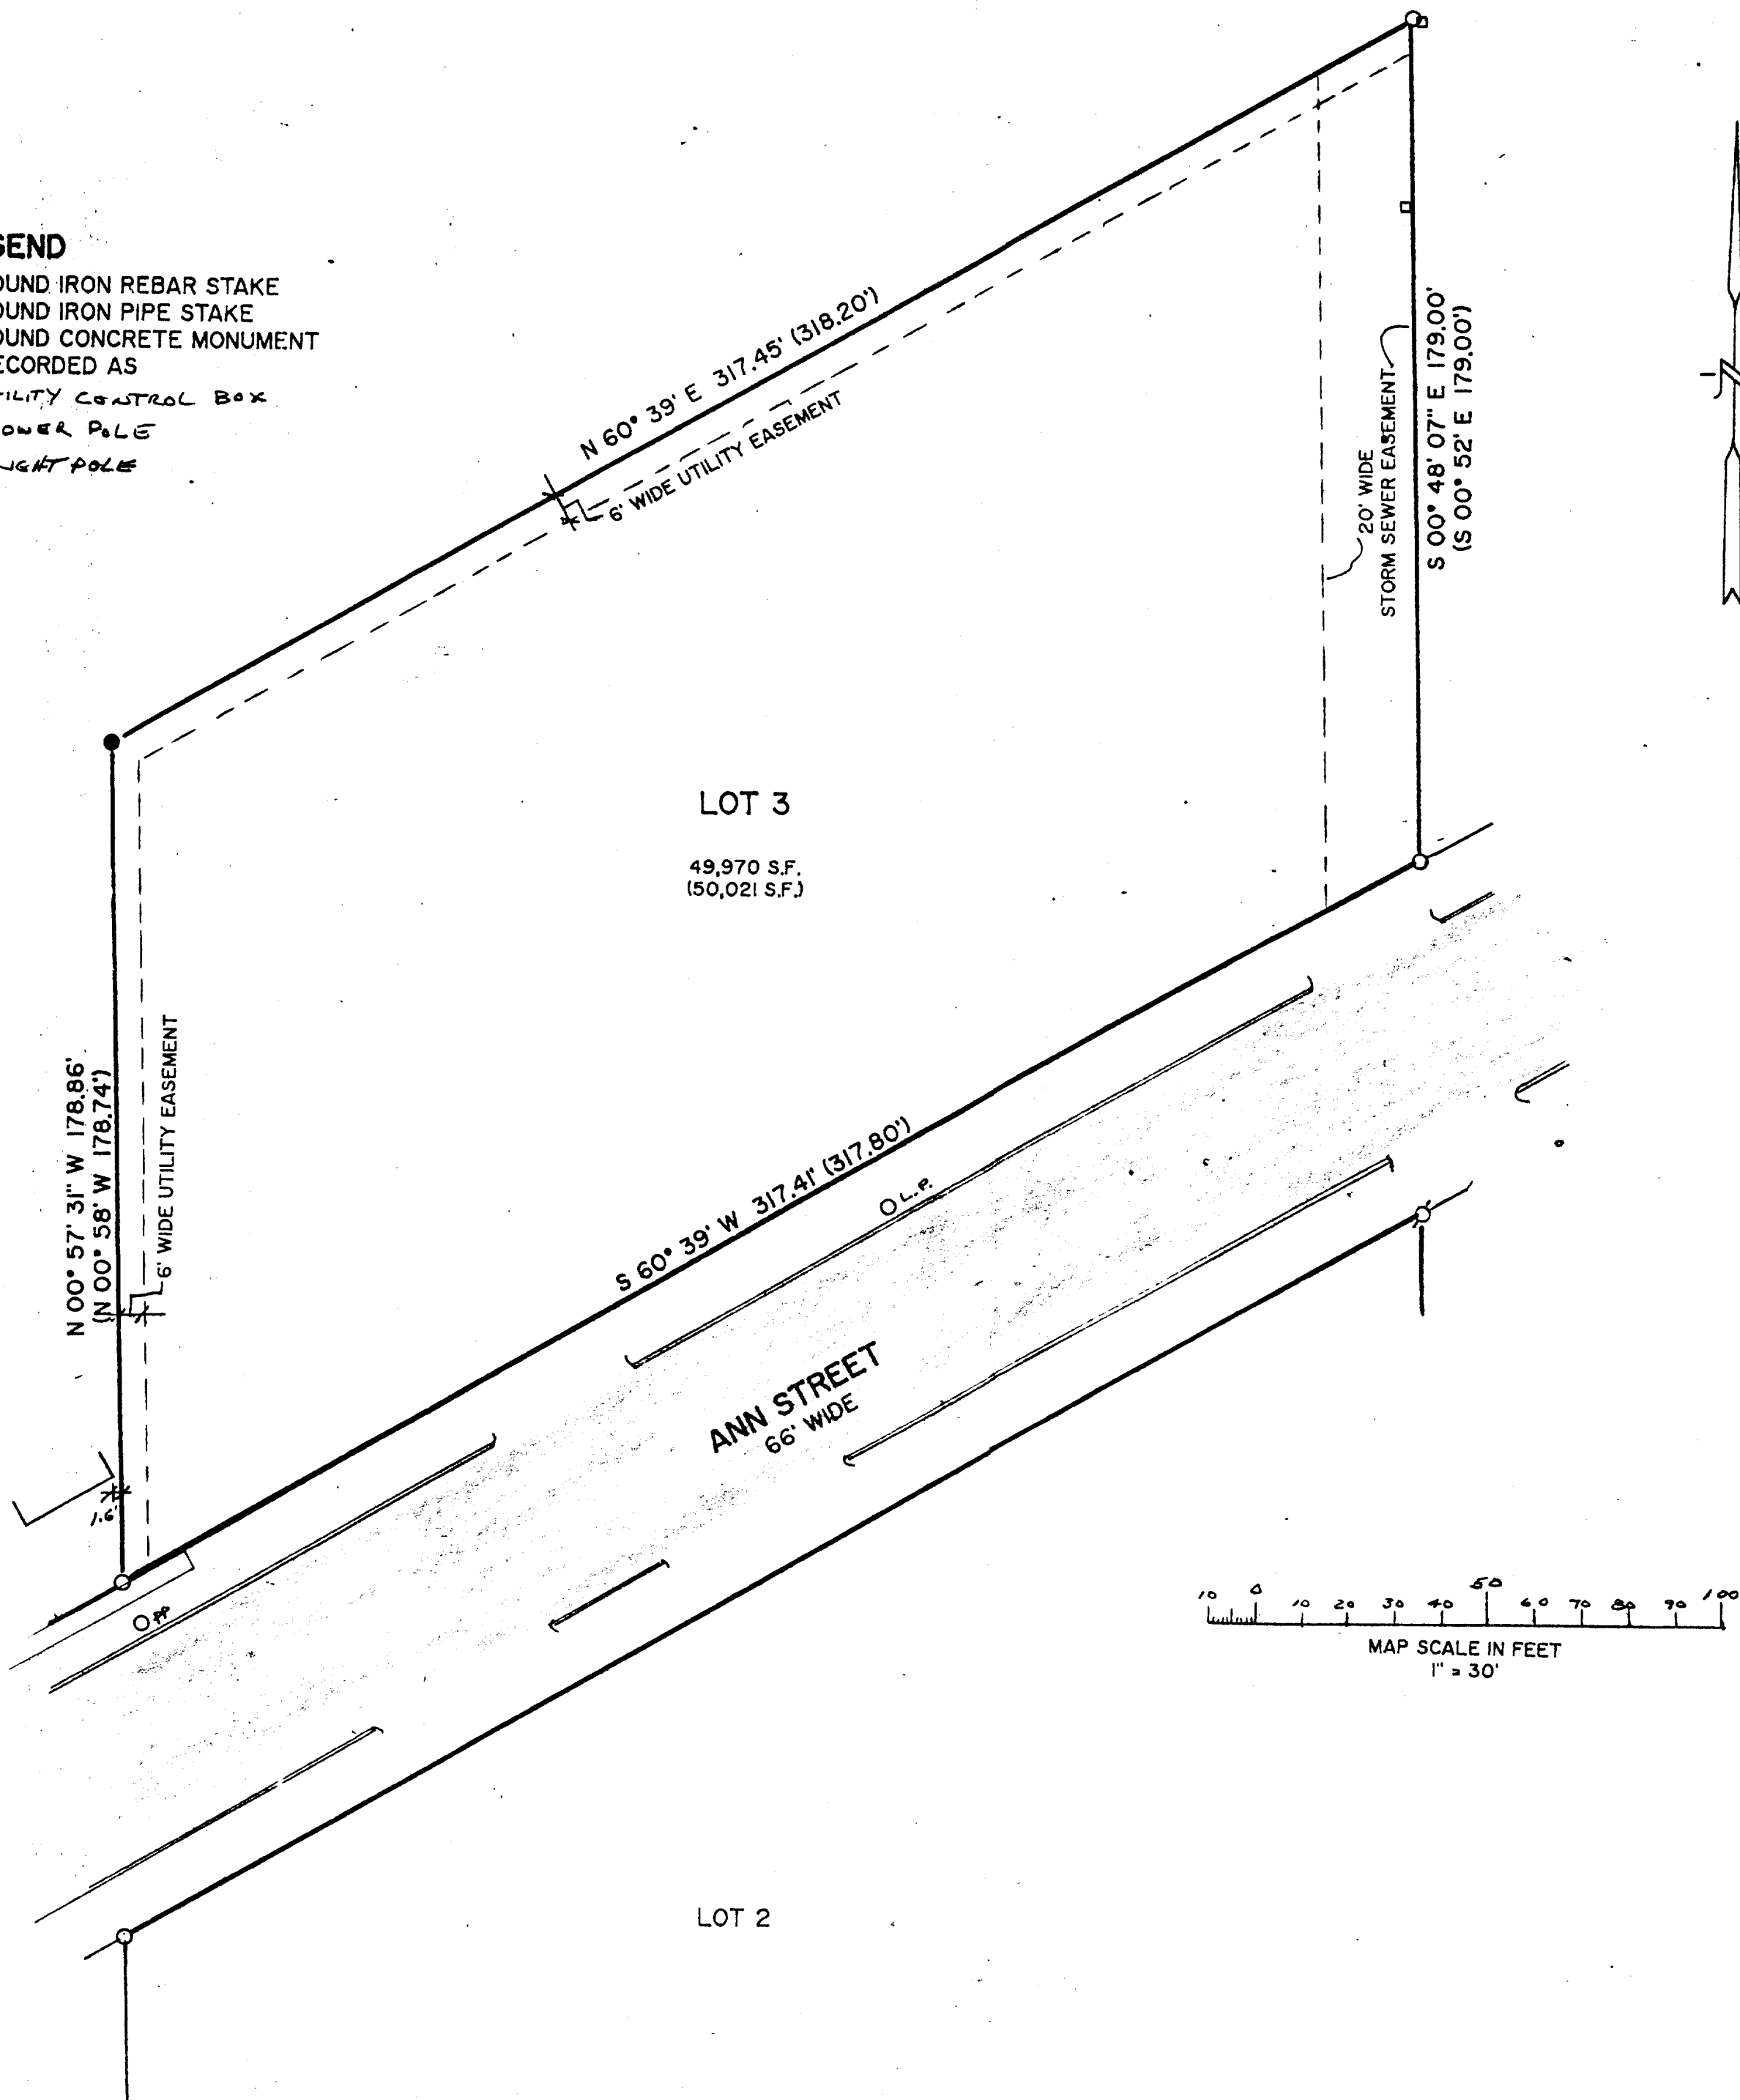


ASSIGNED ANN ST. ROW
S 60° 39' W
PER PLAT OF RECORD

MAP SCALE IN FEET
1" = 30'

NOTE: COPIES OF THIS MAP TO WHICH THE FOLLOWING CERTIFICATE WILL APPLY ARE BLUE LINE PRINTS SHOWING SURVEYOR'S ORIGINAL SEAL AND SIGNATURE IN BLACK INK. COPIES BY ANY OTHER MEANS MAY HAVE ALTERATIONS WHICH DO NOT REPRESENT THE SURVEYOR'S WORK PRODUCT.

I HEREBY CERTIFY THAT THIS PLAT OF SURVEY IS A TRUE AND ACCURATE REPRESENTATION OF THE BOUNDARY LINES OF THE SUBJECT PARCEL AND SHOWS THE SIZE AND LOCATION OF ALL BUILDINGS ON THE PARCEL SHOWN HEREON, TO THE BEST OF MY PROFESSIONAL KNOWLEDGE AND BELIEF. THIS SURVEY IS MADE FOR THE USE OF THE PRESENT OWNERS OF THE PROPERTY, AND ALSO THOSE WHO PURCHASE, MORTGAGE, OR GUARANTEE THE TITLE THERETO WITHIN ONE YEAR FROM THE DATE HEREOF.

DATED: 07/06/93
PETER S. GORDON RLS 2101

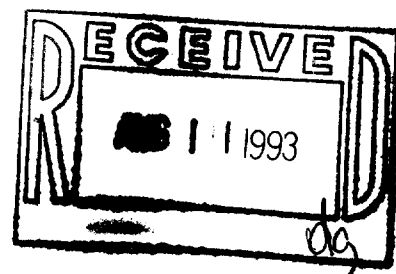

WORK ORDERED BY: ED ACHEL BORG INSTRUMENTS

FARRIS, HANSEN & ASSOCIATES, INC.
Engineering, Architecture, Surveying
7 Ridgway Court P.O. Box 437
ELKHORN, WISCONSIN 53121
Office: (414) 723-2098
Fax: (414) 723-5886

REVISIONS

PROJECT NO.
2518.93
DATE
07/06/93
SHEET NO.
1 OF 1

002-1284