

McDOWELL 82.50' WIDE *STREET*

66.41'

STREET

82.50' WIDE

MAN


LOT 4 AND 6 FEET OFF THE NORTH SIDE OF
LOT 5 IN BLOCK 7 OF THE ORIGINAL PLAT
OF THE CITY OF DELAVAN, WALWORTH COUNTY,
WISCONSIN.

 $\mathcal{N}$ 

SCALE 1" = 30'

LEGEND

- ♂ - IRON PIPE FOUND
 ■ - CONCRETE MONUMENT FOUND
 ■ - SQUARE IRON BAR FOUND
 ○ - IRON ROD SET
 △ - UTILITY POLE
 ———— - OVERHEAD UTILITY LINES
 CS - CONCRETE STOOP
 X—X—X - WOOD FENCE
 () - RECORDED AS

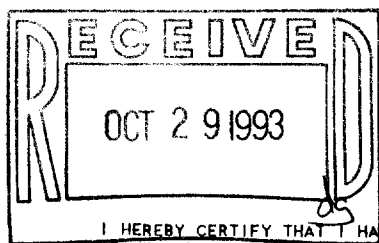

I HEREBY CERTIFY THAT I HAVE SURVEYED THE ABOVE DESCRIBED PROPERTY AND THAT THE ABOVE MAP IS A TRUE REPRESENTATION THEREOF AND SHOWS THE SIZE AND LOCATION OF THE PROPERTY, ITS EXTERIOR BOUNDARIES, THE LOCATION OF ALL VISIBLE STRUCTURES AND DIMENSIONS OF ALL PRINCIPAL BUILDINGS THEREON, BOUNDARY FENCES, APPARENT EASEMENTS, ROADWAYS AND VISIBLE ENCROACHMENTS, IF ANY, TO THE BEST OF MY KNOWLEDGE AND BELIEF.

THIS SURVEY IS MADE FOR THE USE OF THE PRESENT OWNERS OF THE PROPERTY, AND ALSO THOSE WHO PURCHASE, MORTGAGE, OR GUARANTEE THE TITLE THERETO WITHIN ONE (1) YEAR FROM DATE HEREON.

David F. Bell

DAVID F. ABELL
WISCONSIN REGISTERED LAND SURVEYOR. S-1596

August 30, 1993

DATE _____ JOB NUMBER - 93178
NOTE: THIS IS NOT A CERTIFIED COPY UNLESS SEALED.

ORDERED BY: CENTURY 21-SKANDIA REALTY
312 S. 7th STREET
DELAVAN, WI. 53115