


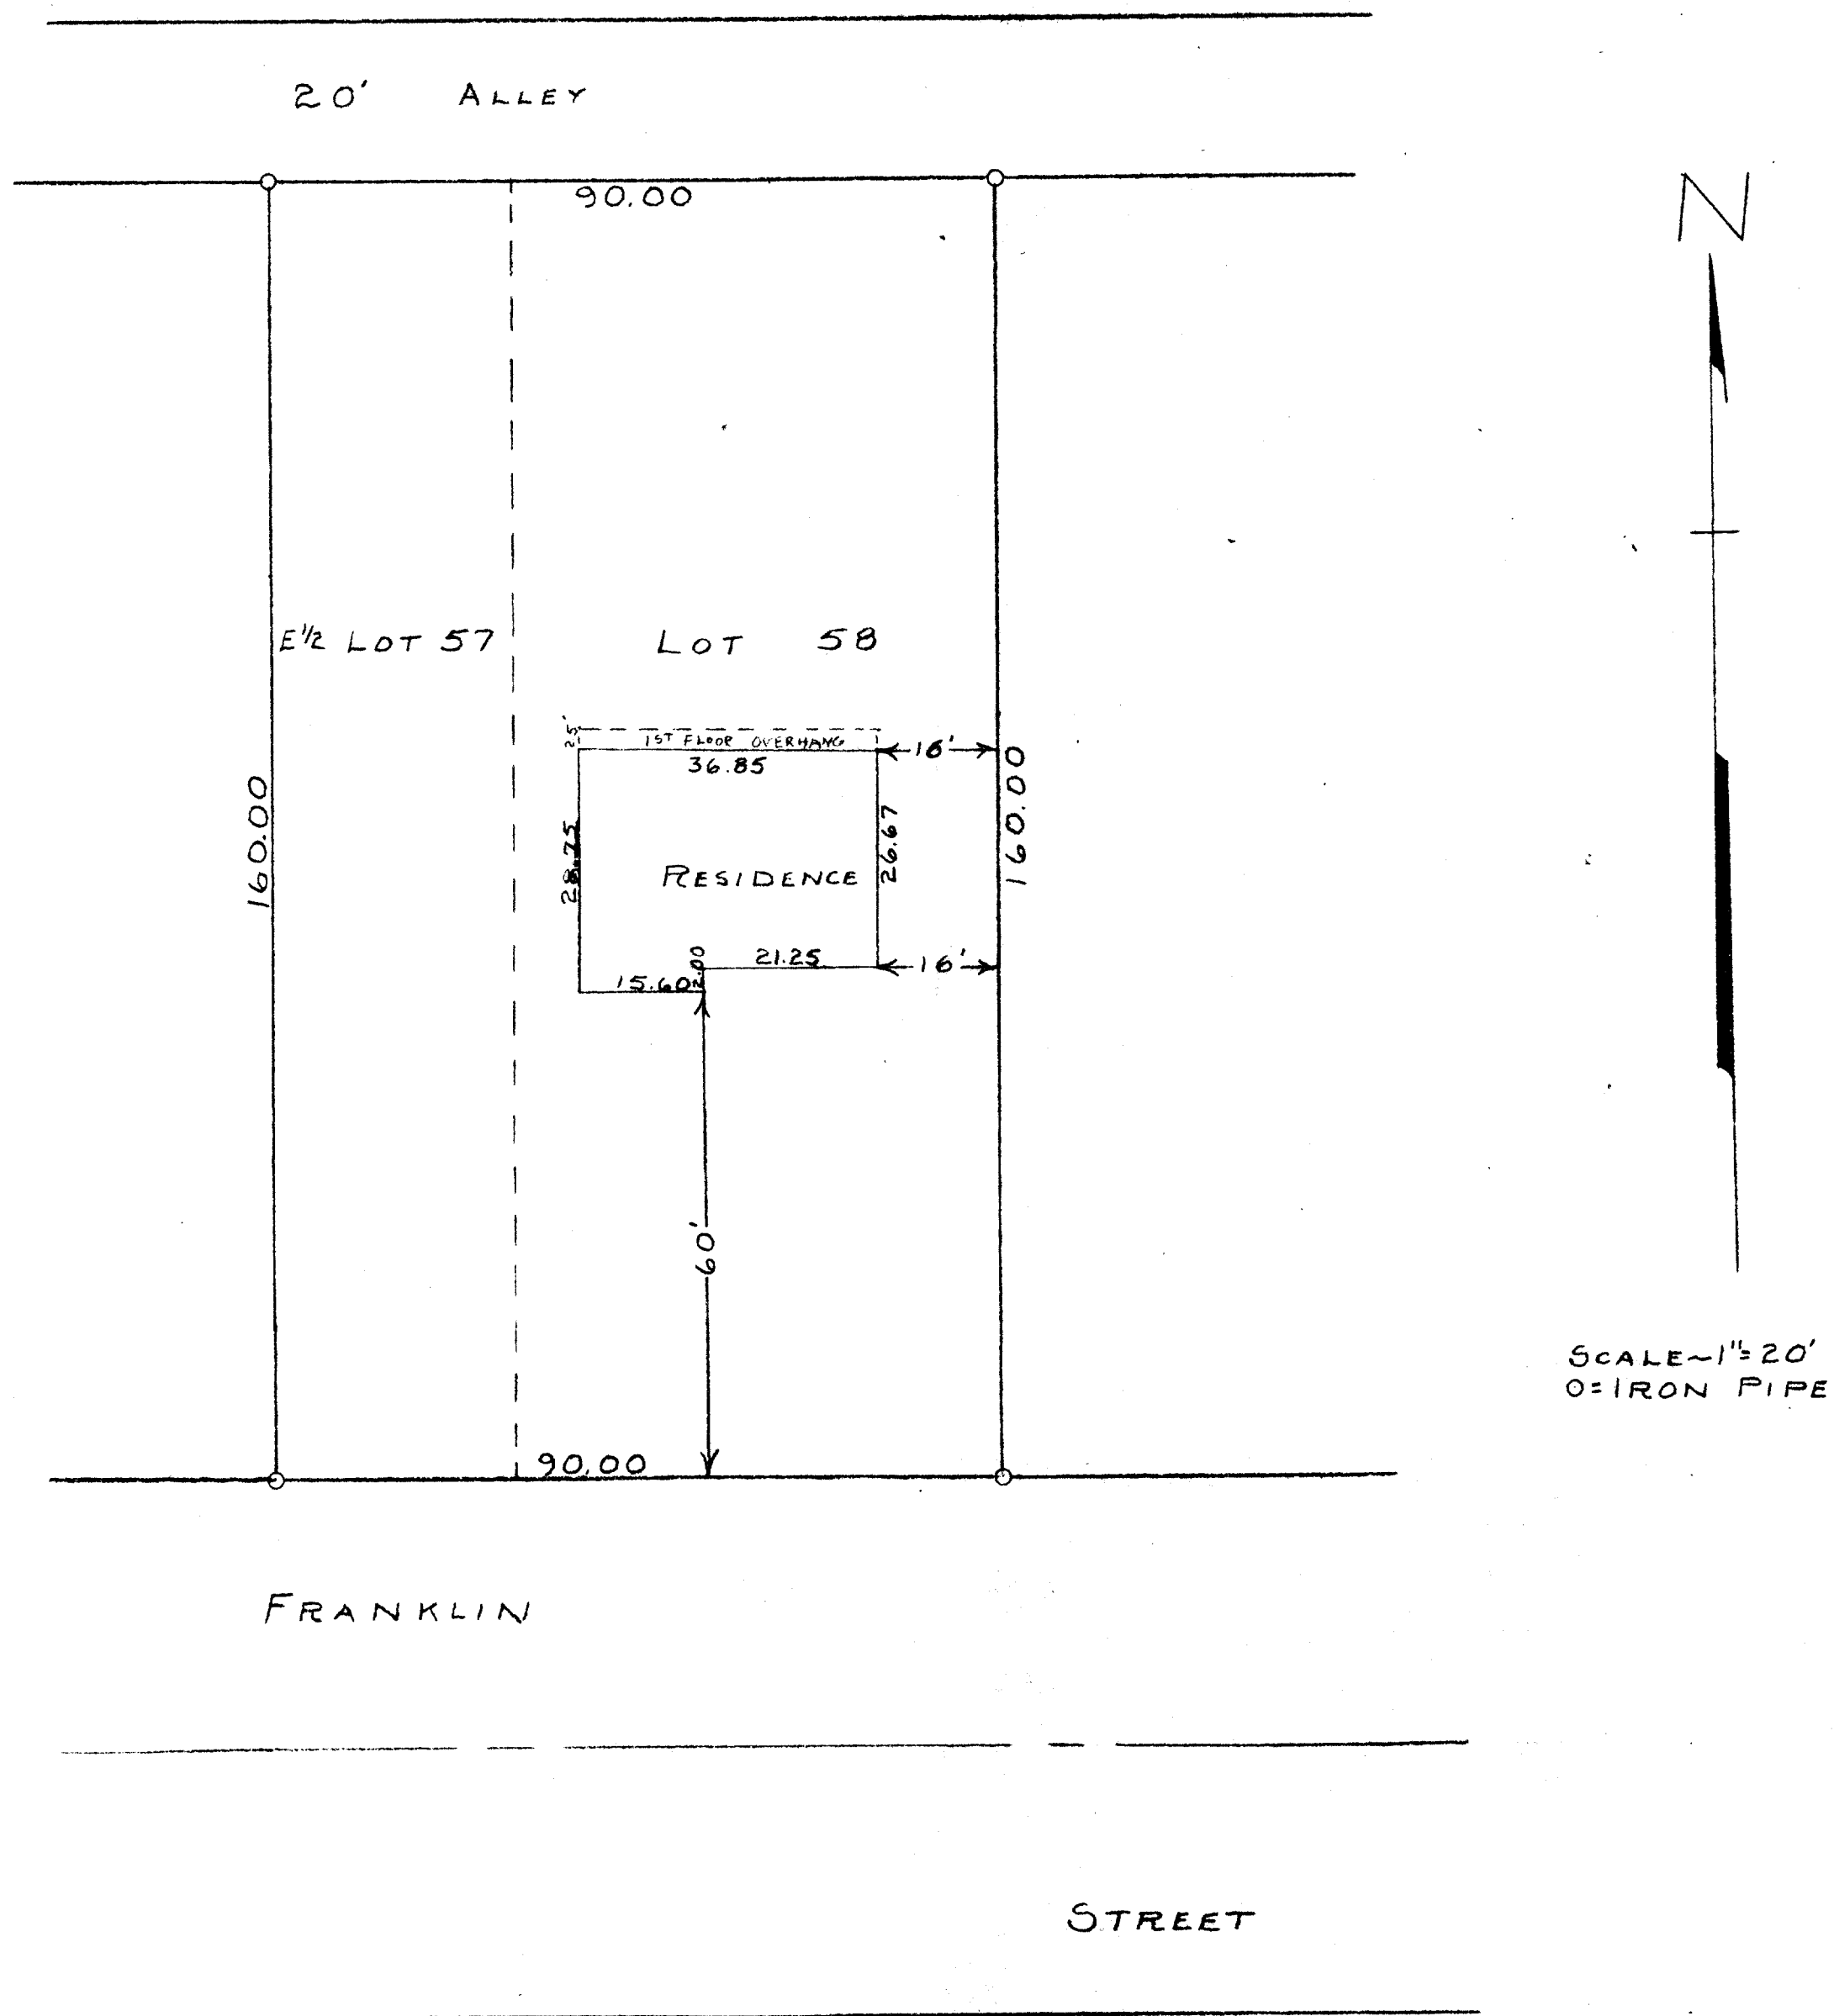

STATE OF WISCONSIN)^{ss}
 WALWORTH COUNTY)

I, GEORGE T. DUNHAM, DO HEREBY CERTIFY THAT I HAVE SURVEYED THE
 PROPERTY DESCRIBED AS FOLLOWS:

LOT 58 AND THE EAST 1/2 OF LOT 57, MAR-DEL ESTATES LOCATED
 IN THE CITY OF DELAVAN, WALWORTH COUNTY, WISCONSIN.

AND THAT THE PLAT SHOWN ABOVE IS A CORRECT REPRESENTATION OF THE
 PROPERTY LINES AND OF THE IMPROVEMENTS LOCATED THEREON.

JAN. 5, 1959

REVISED JUNE 24, 1959

George T. Dunham
 GEORGE T. DUNHAM, SURVEYOR
 DELAVAN, WISCONSIN

2-130