


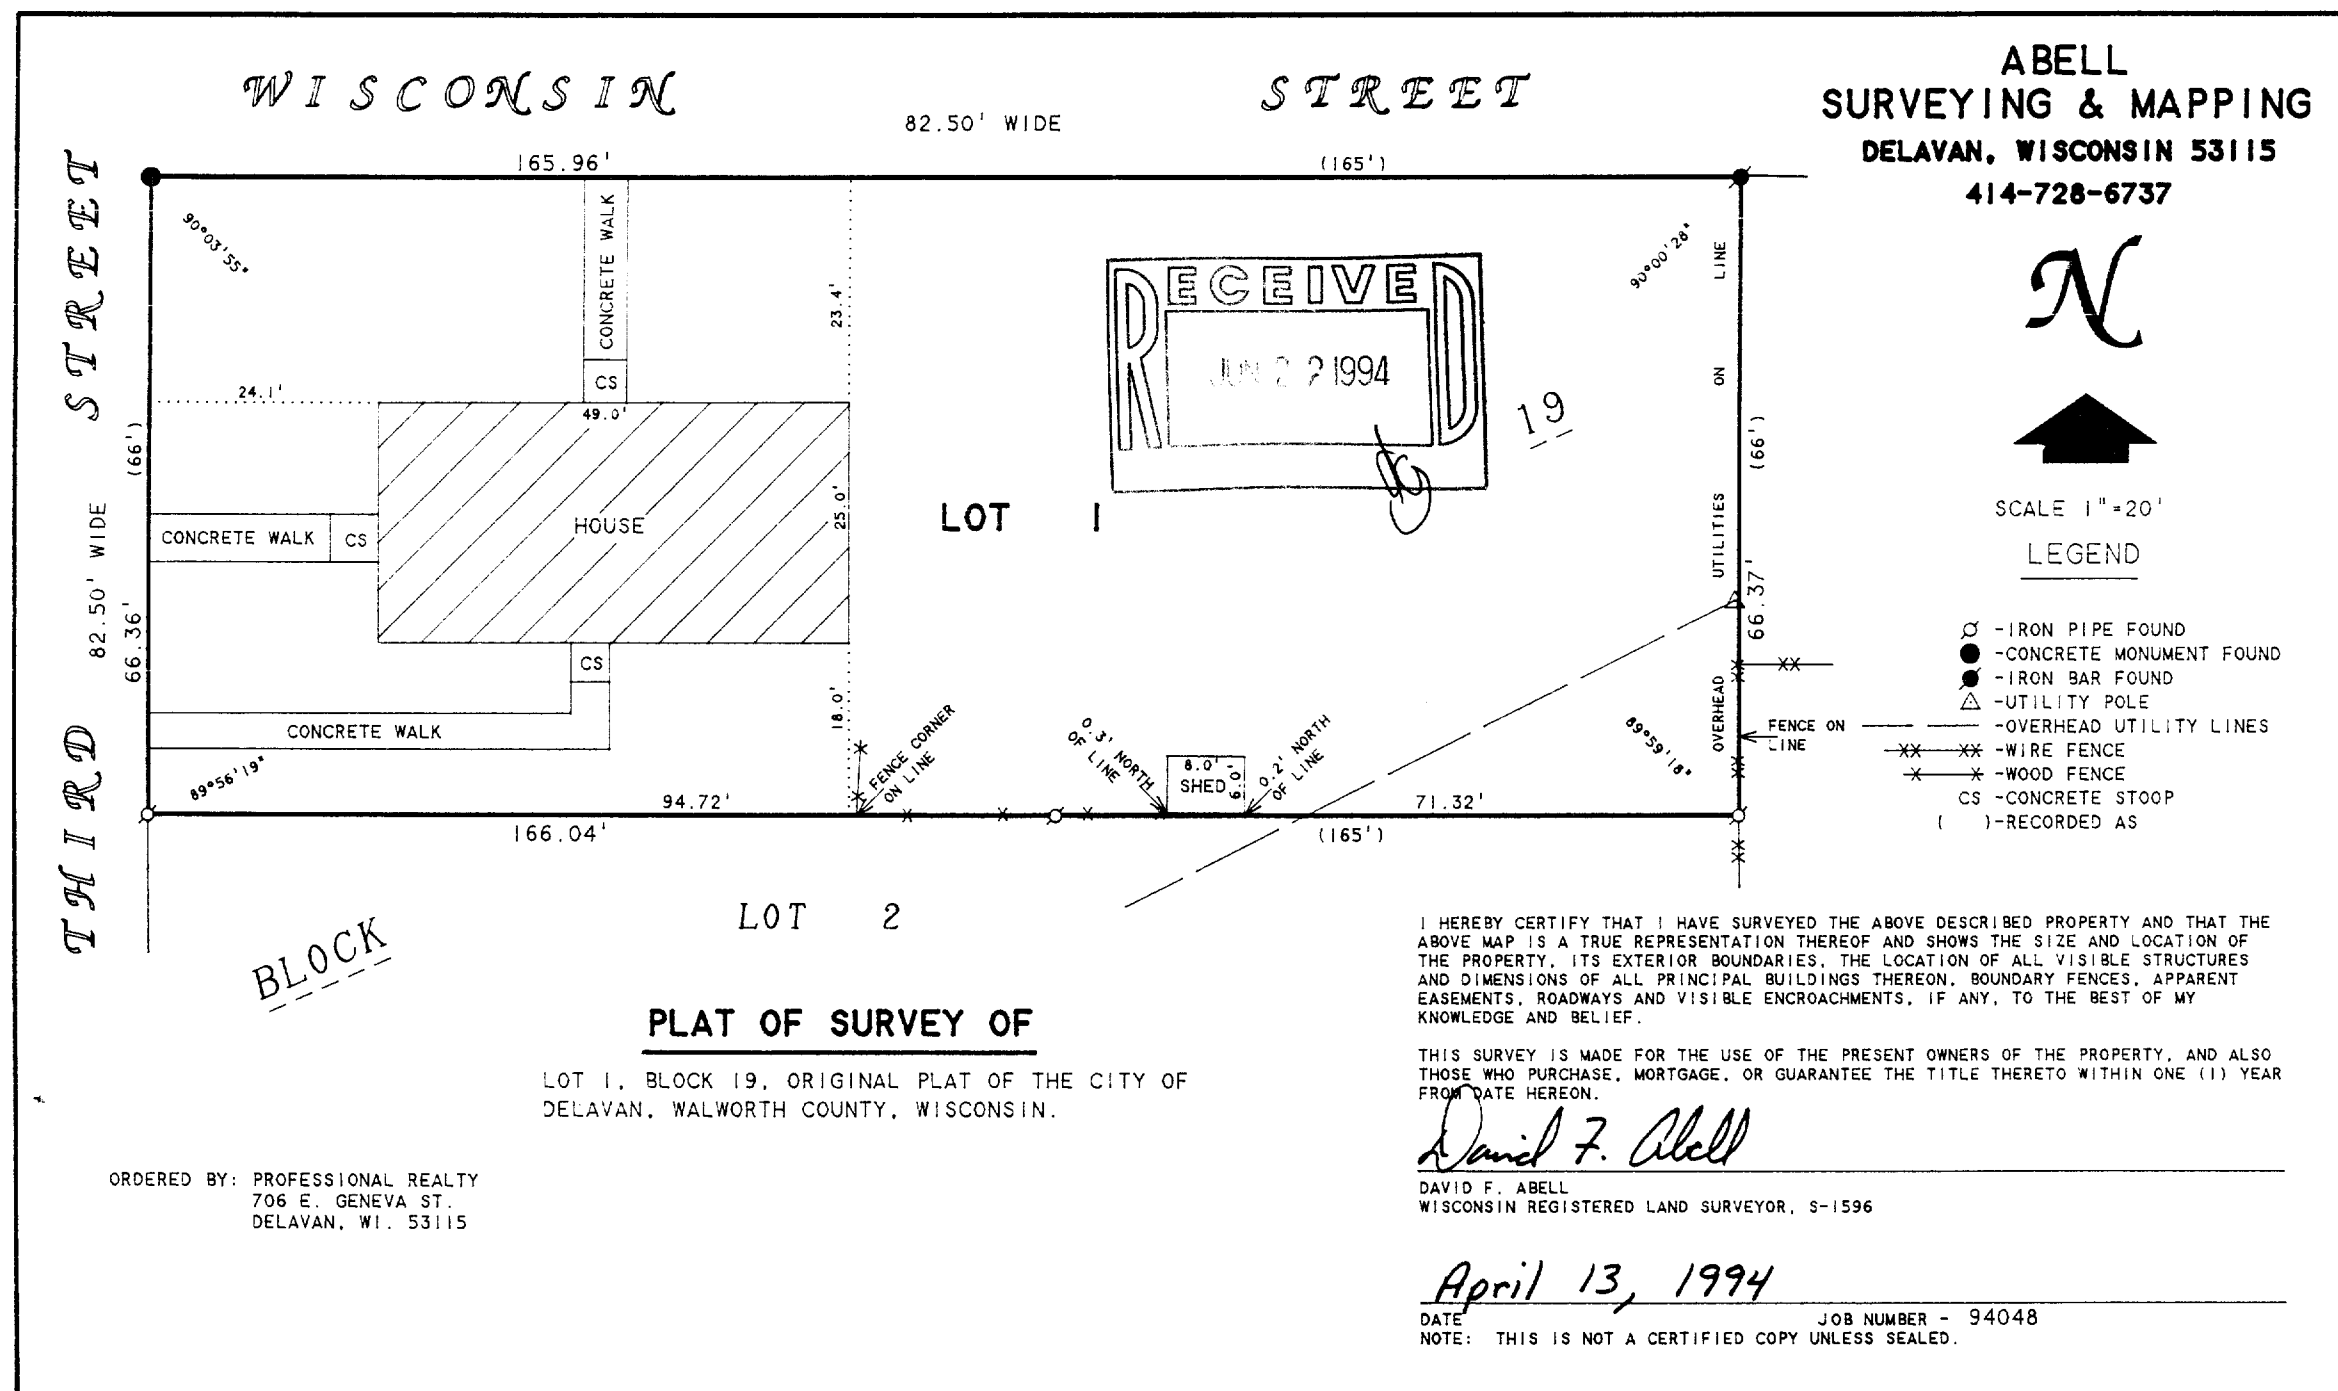

XOP-198

882-1352