


PLAT OF SURVEY

of

Lot 3, Block 2 of Elmhurst Addition to the City of
Delavan, Walworth County, Wisconsin.

Surveyed for: State Bank of the Lakes
440 Lake Street P.O. Box 369
Antioch, Illinois. 60002

Bearings referenced to
previous surveys.

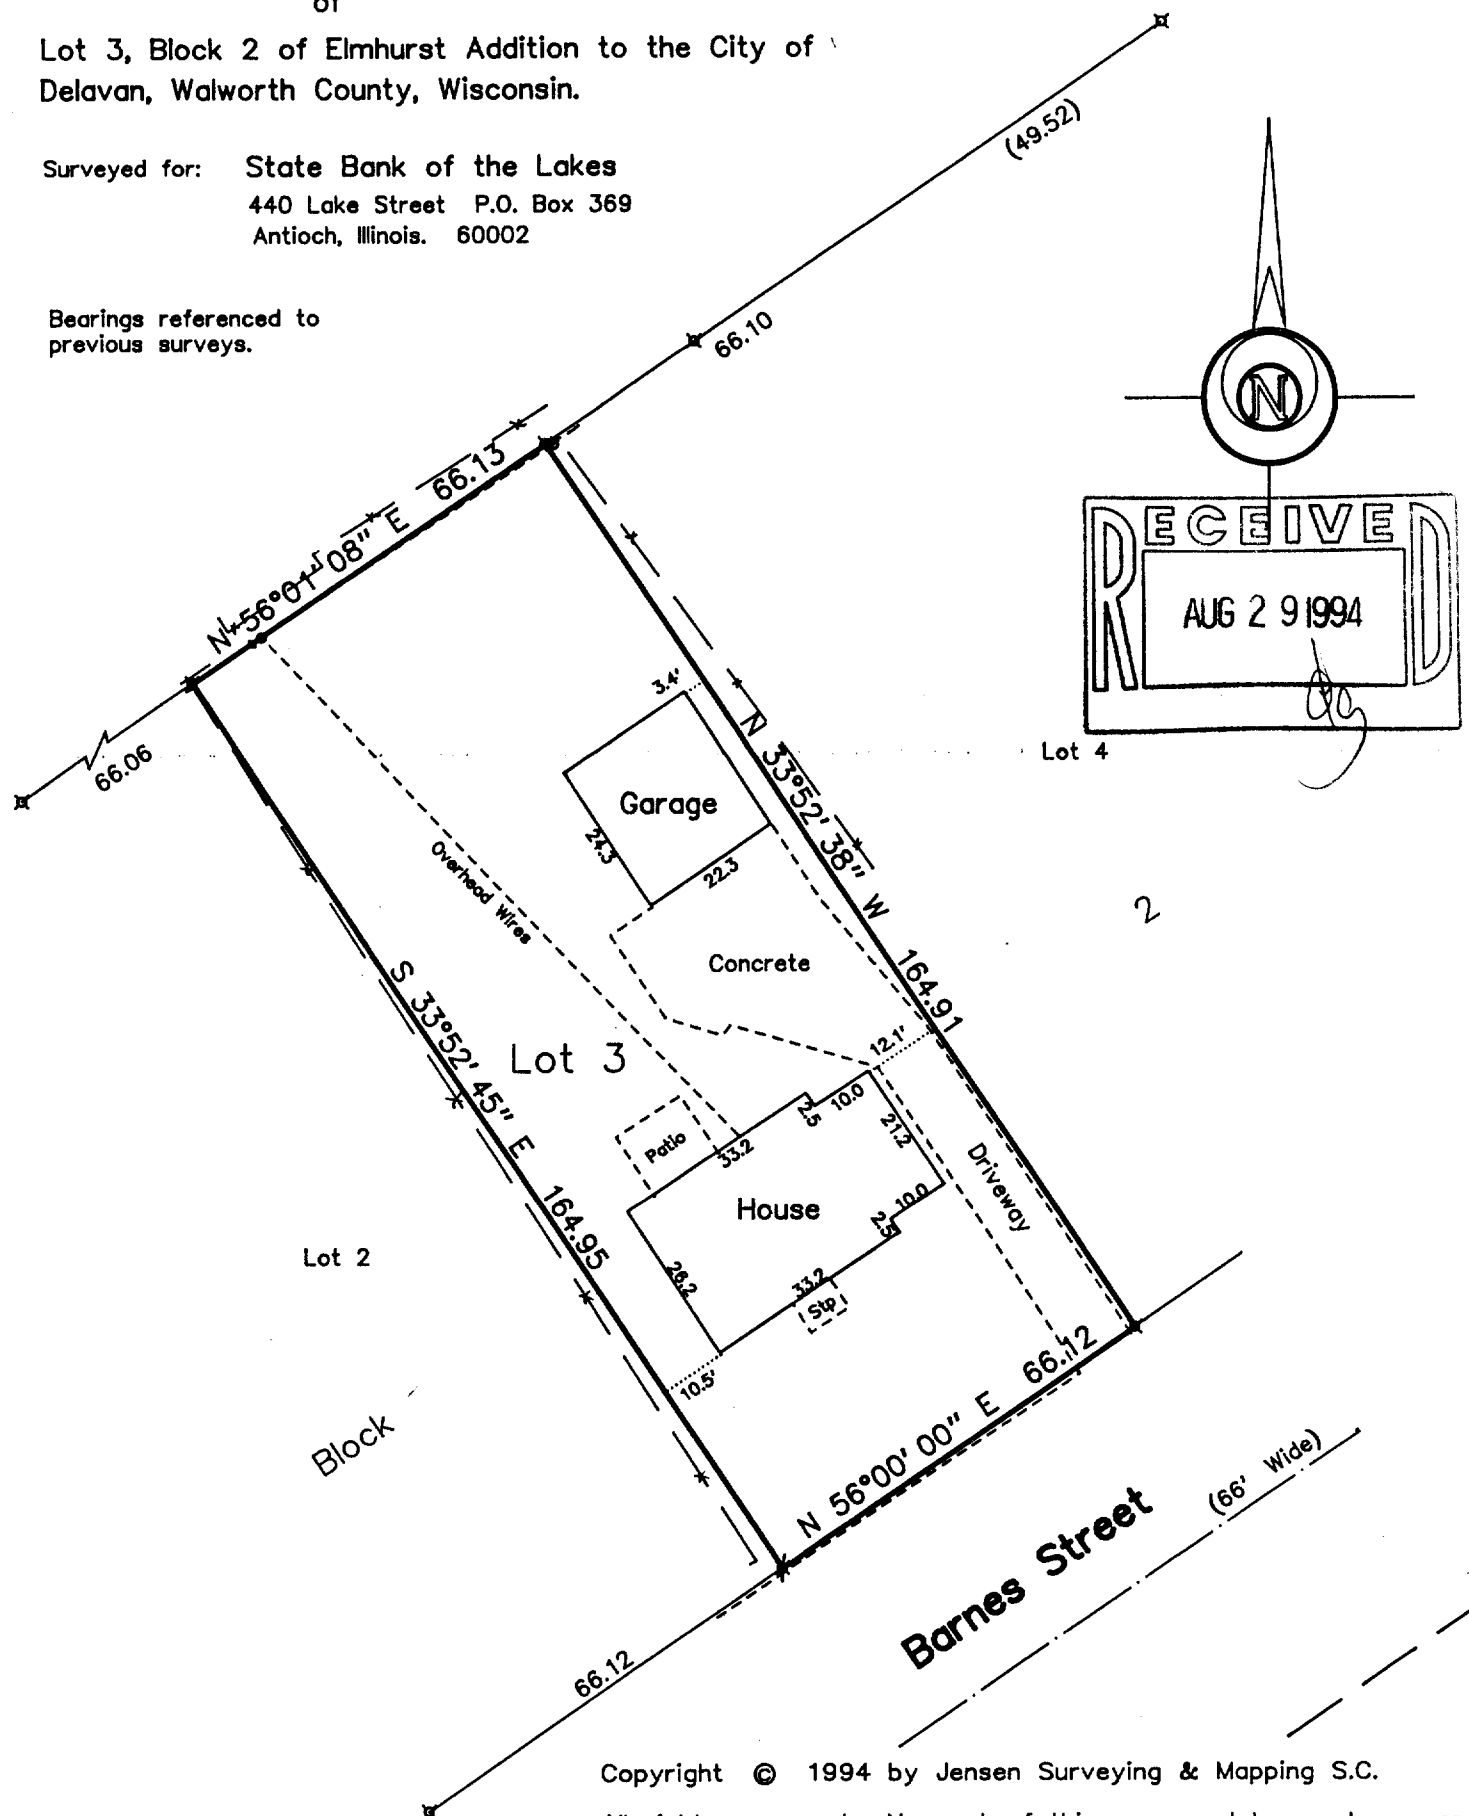

All rights reserved. No part of this survey plat may be reproduced or transmitted in any form by any means — graphic, electronic, or mechanical, including photocopying, tracing, or information storage and retrieval systems — without permission in writing from Thomas P.A. Jensen, Jensen Surveying & Mapping S.C..

I, Douglas G. Olson, Wisconsin Registered Land Surveyor, do hereby certify that this survey was performed by me, or under my direction in full compliance with the owner's / agent's instructions and Chapter A-E 7 of the Wisconsin Administrative Code "Minimum Standards for Property Surveys"; and that this map is an accurate representation thereof to the best of my knowledge and belief.

NOTE: This survey plat is not certified
unless signed and sealed in red ink.

Douglas G. Olson

R.L.S. 2093

Legend

- Found iron pipe
- Set iron rod, 3/4"
- () Recorded as dimension
- concrete surface
- Fence
- Utility pole
- Utility pedestal

JENSEN SURVEYING & MAPPING S.C.

45 South Wisconsin Street P.O. Box 322

Elkhorn, Wisconsin. 53121

Telephone & Facsimile (414) 723-3434


Mapping date: January 24, 1994

Revisions:

Sheet 1 of 1 Sheets

Job Reference number:

Scale: 1" = 30'

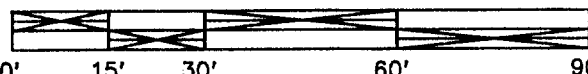

002-1357 1994.002