


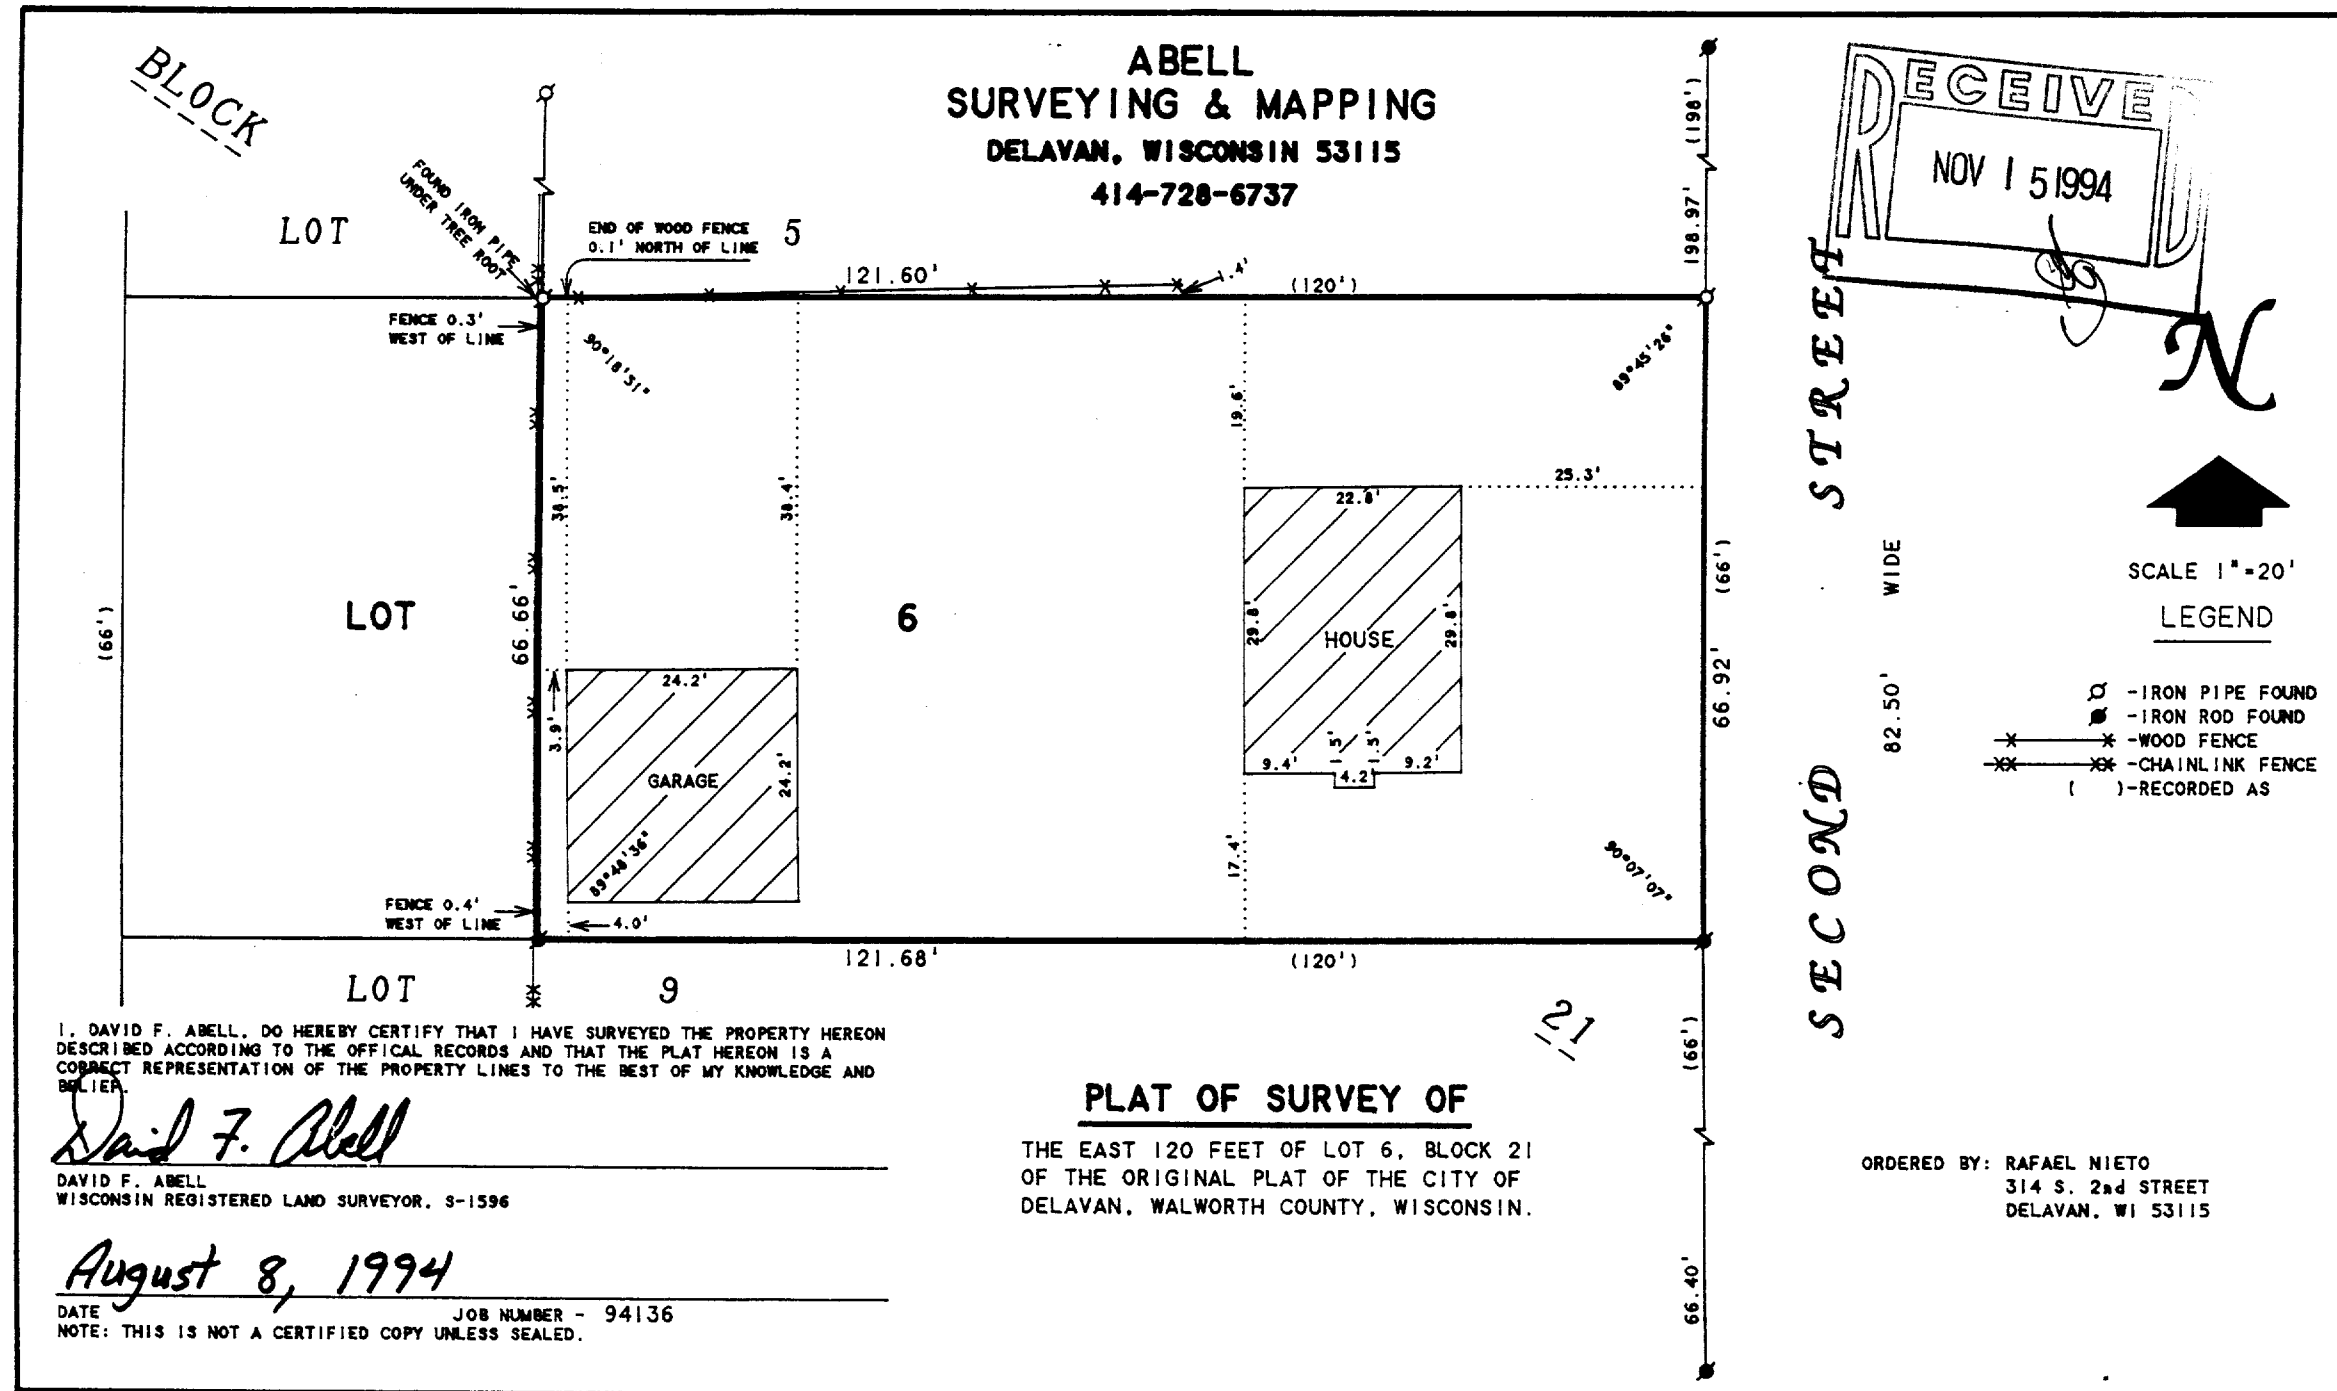

XOP-220

002-1367