

DUNHAM SURVEYING, S.C.
SURVEYING & ENGINEERING
DELAVER, WISCONSIN 53115

CENTER STREET

N

Alley

11.0
10.7
8.2

1.5

1.0

1.6

333.19'E
175.8

Garage

24.1

16.2

11.8

12.2

20.5

10.1

16.1

3

20.8

16.0

18.7

50.20

N61°40'E

18.7

26.2

29.2

20.2

1.5

112.60

N33°12'40"W

1.5

1.0

1.6

1.5

1.5

Scale - 1" = 20'

⊗ = Iron Pipe-3/4" Found

● = Concrete Monument Found

○ = 3/4" bent iron pipe found, pulled & reset

--- = fence line

Bearings referenced to the northwesterly line of Wisconsin Street with the assumed bearing of N61°40'E

October 1993 survey ordered by:

Brent Flikkema

312 1/2 Sputh 2nd Street

Delavan, WI 53115

⊗ = 1" Iron Pipe Found

STATE OF WISCONSIN) ss
COUNTY OF WALWORTH)

I, George T. Dunham, Surveyor, certify that I have surveyed the property described as follows:

Lot 16 in Block 4 of Converse's Subdivision located in the City of Delavan, Walworth County, Wisconsin,



and the above map is a true representation thereof and shows the size and location of the property, its exterior boundaries, the location and dimensions of all structures thereon, fences, apparent easements and roadways and encroachments, if any.

April 12, 1978

Updated and recertified to this

20th day of October, 1993

George T. Dunham
George T. Dunham, Surveyor

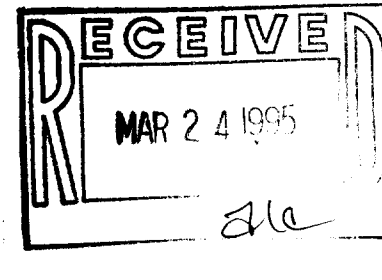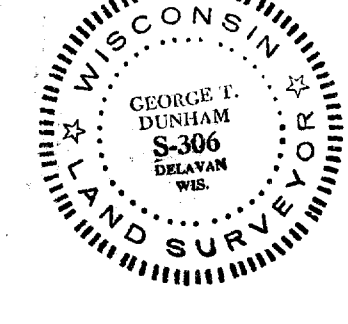

KS-39

002-1394

2-600