


DUNHAM SURVEYING, S. C.

**SURVEYING & SUBDIVIDING
DELAVAN, WISCONSIN 53115**

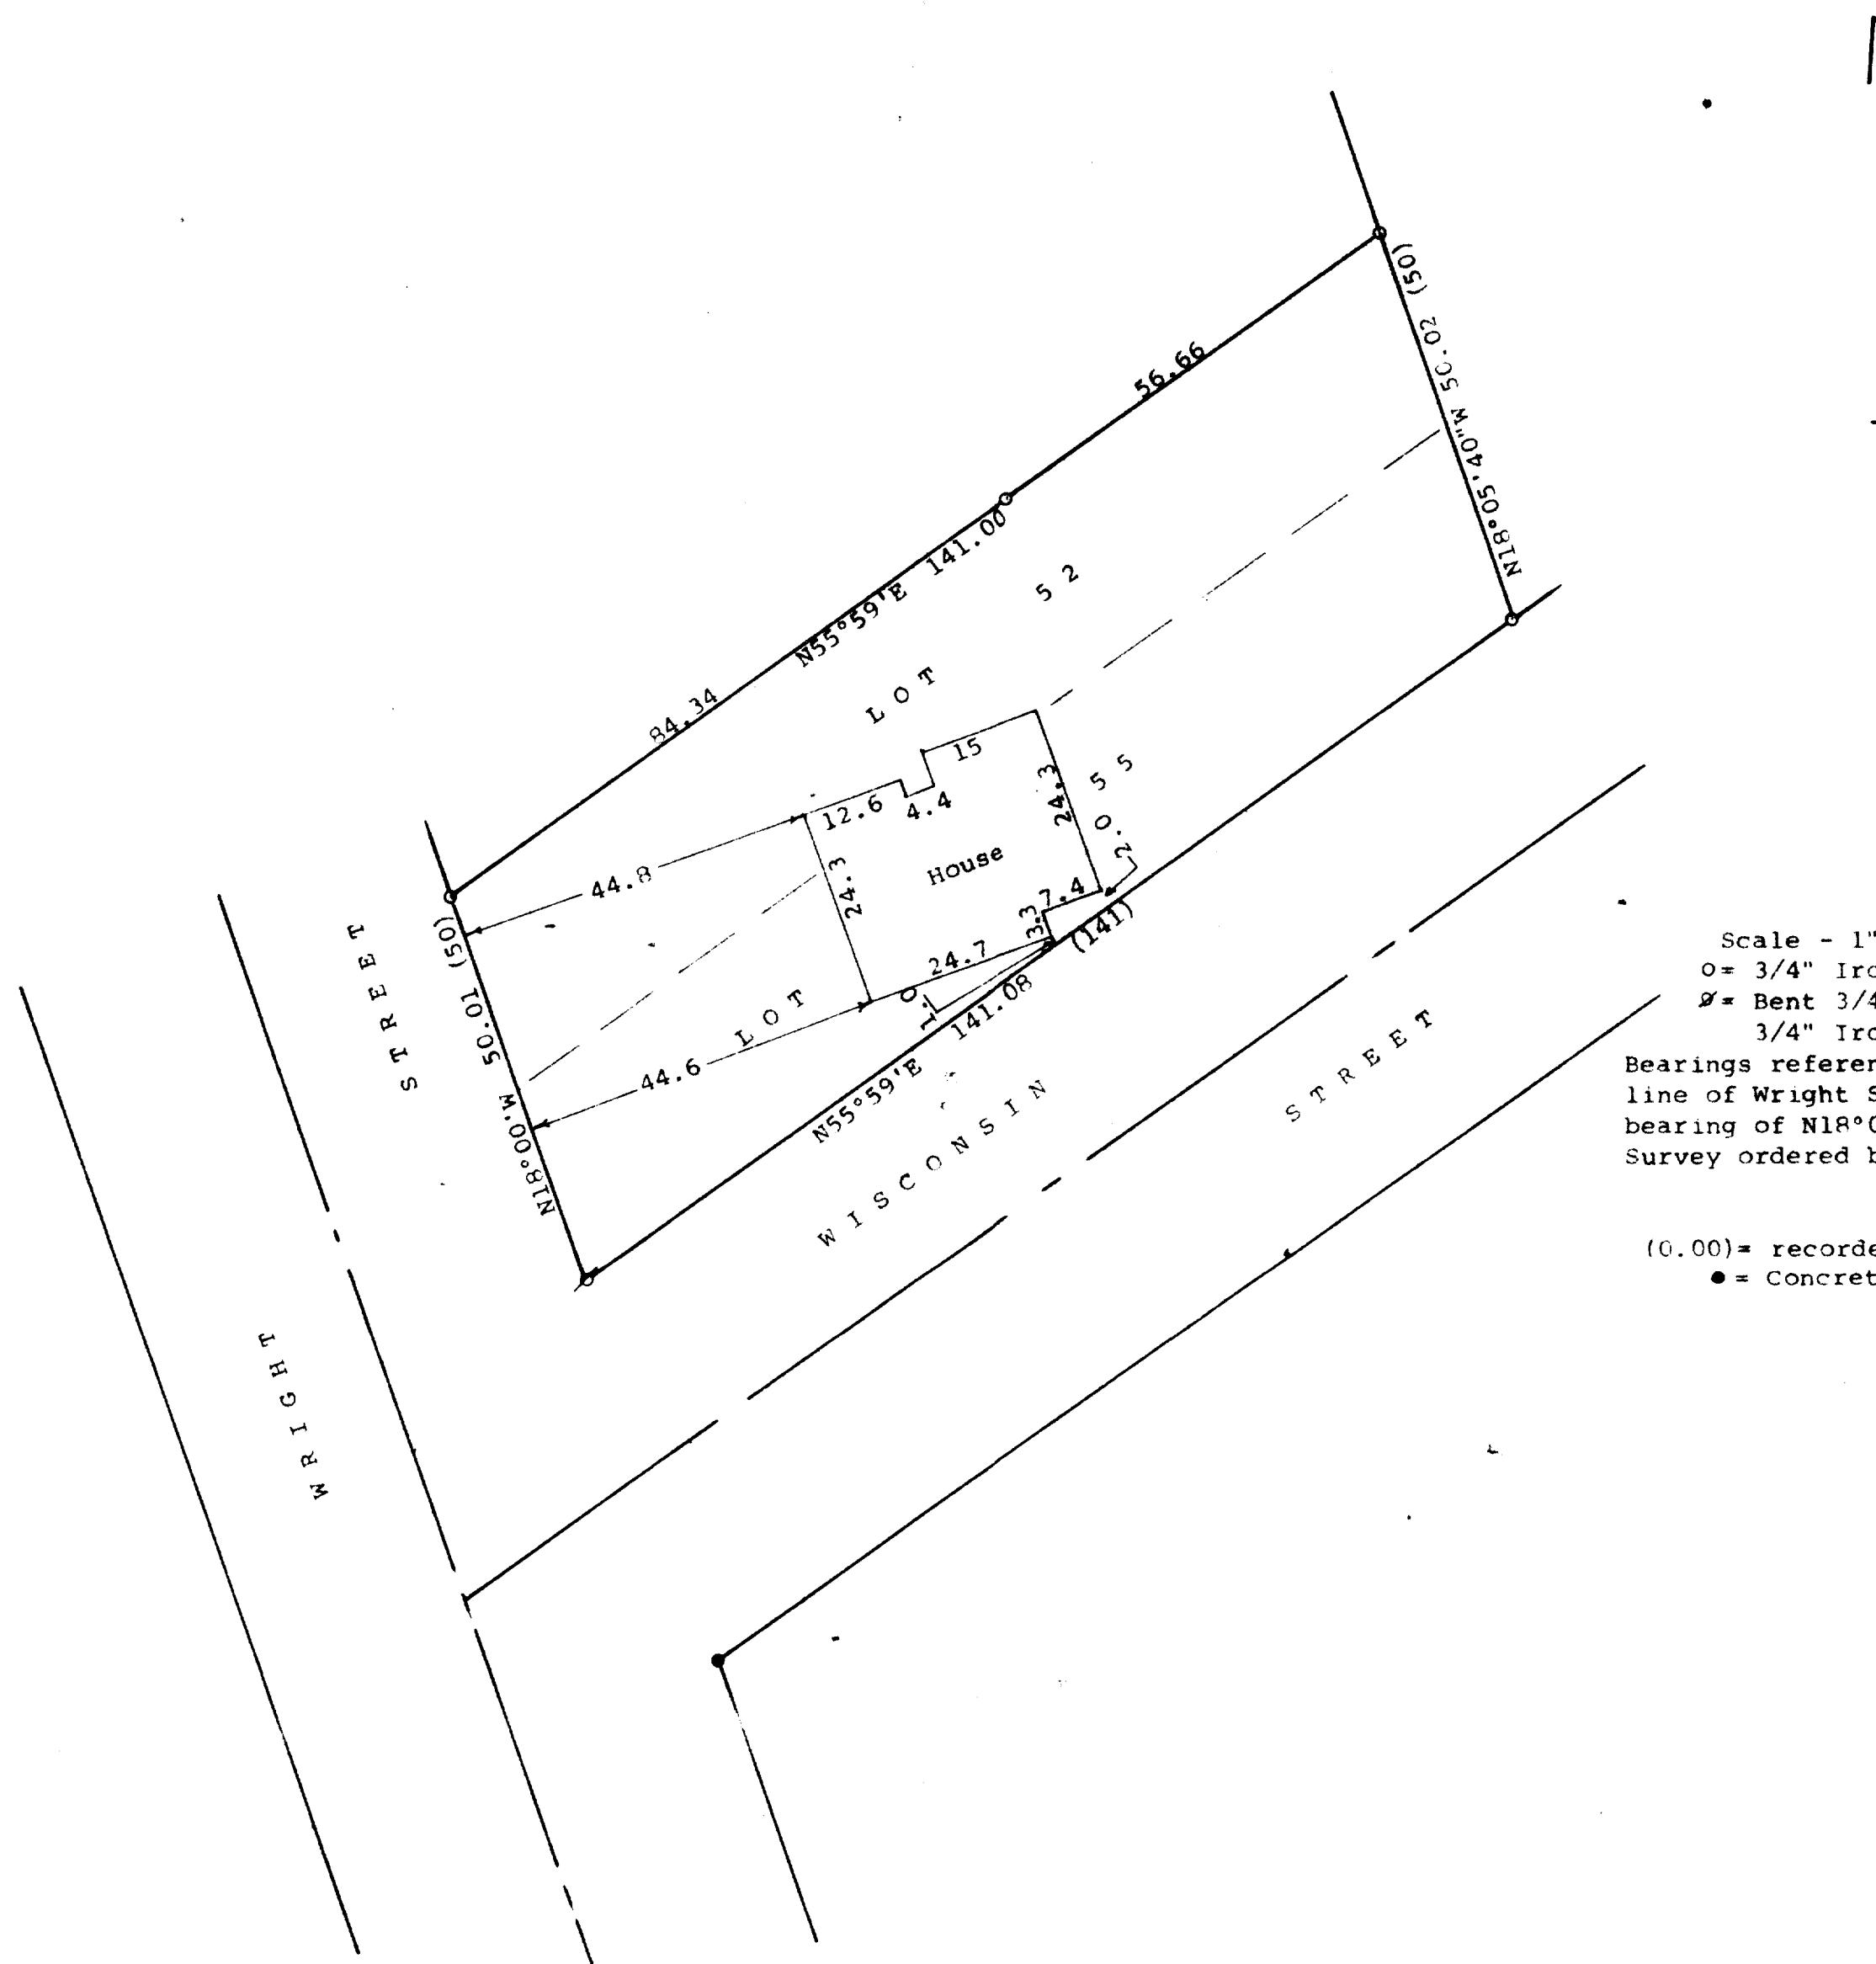

STATE OF WISCONSIN) ss
COUNTY OF WALWORTH)



I, George T. Dunham, Surveyor, certify that I have surveyed the property described as follows:

Lots 52 and 55 in Block 1 of Delaview Subdivision located in the Northeast $\frac{1}{4}$ of Section 17, T 2 N, R 16 E, City of Delavan, Walworth County, Wisconsin

Walworth County, Wisconsin
and that the plat whosn hereon is a correct representation thereof and shows the size and location of the property, its exterior boundaries, the location of all visible structures and dimensions of all principal buildings thereon, boundary fences, apparent easements, roadways and visible encroachments, if any, and that I have surveyed the property hereon described, according to the official records, to the best of my knowledge and belief.

Official records
October 21, 1994

George E. Dunham
George E. Dunham SURVEYOR

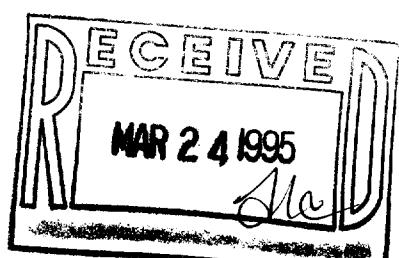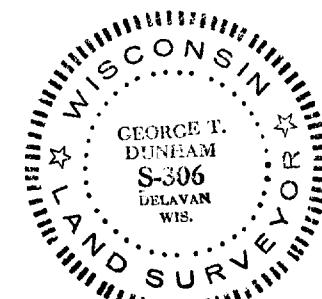

XO-19

ME 1020

002-1404