


DUNHAM SURVEYING, S.C.
SURVEYING & SUBDIVIDING
DELAVER, WISCONSIN 53115

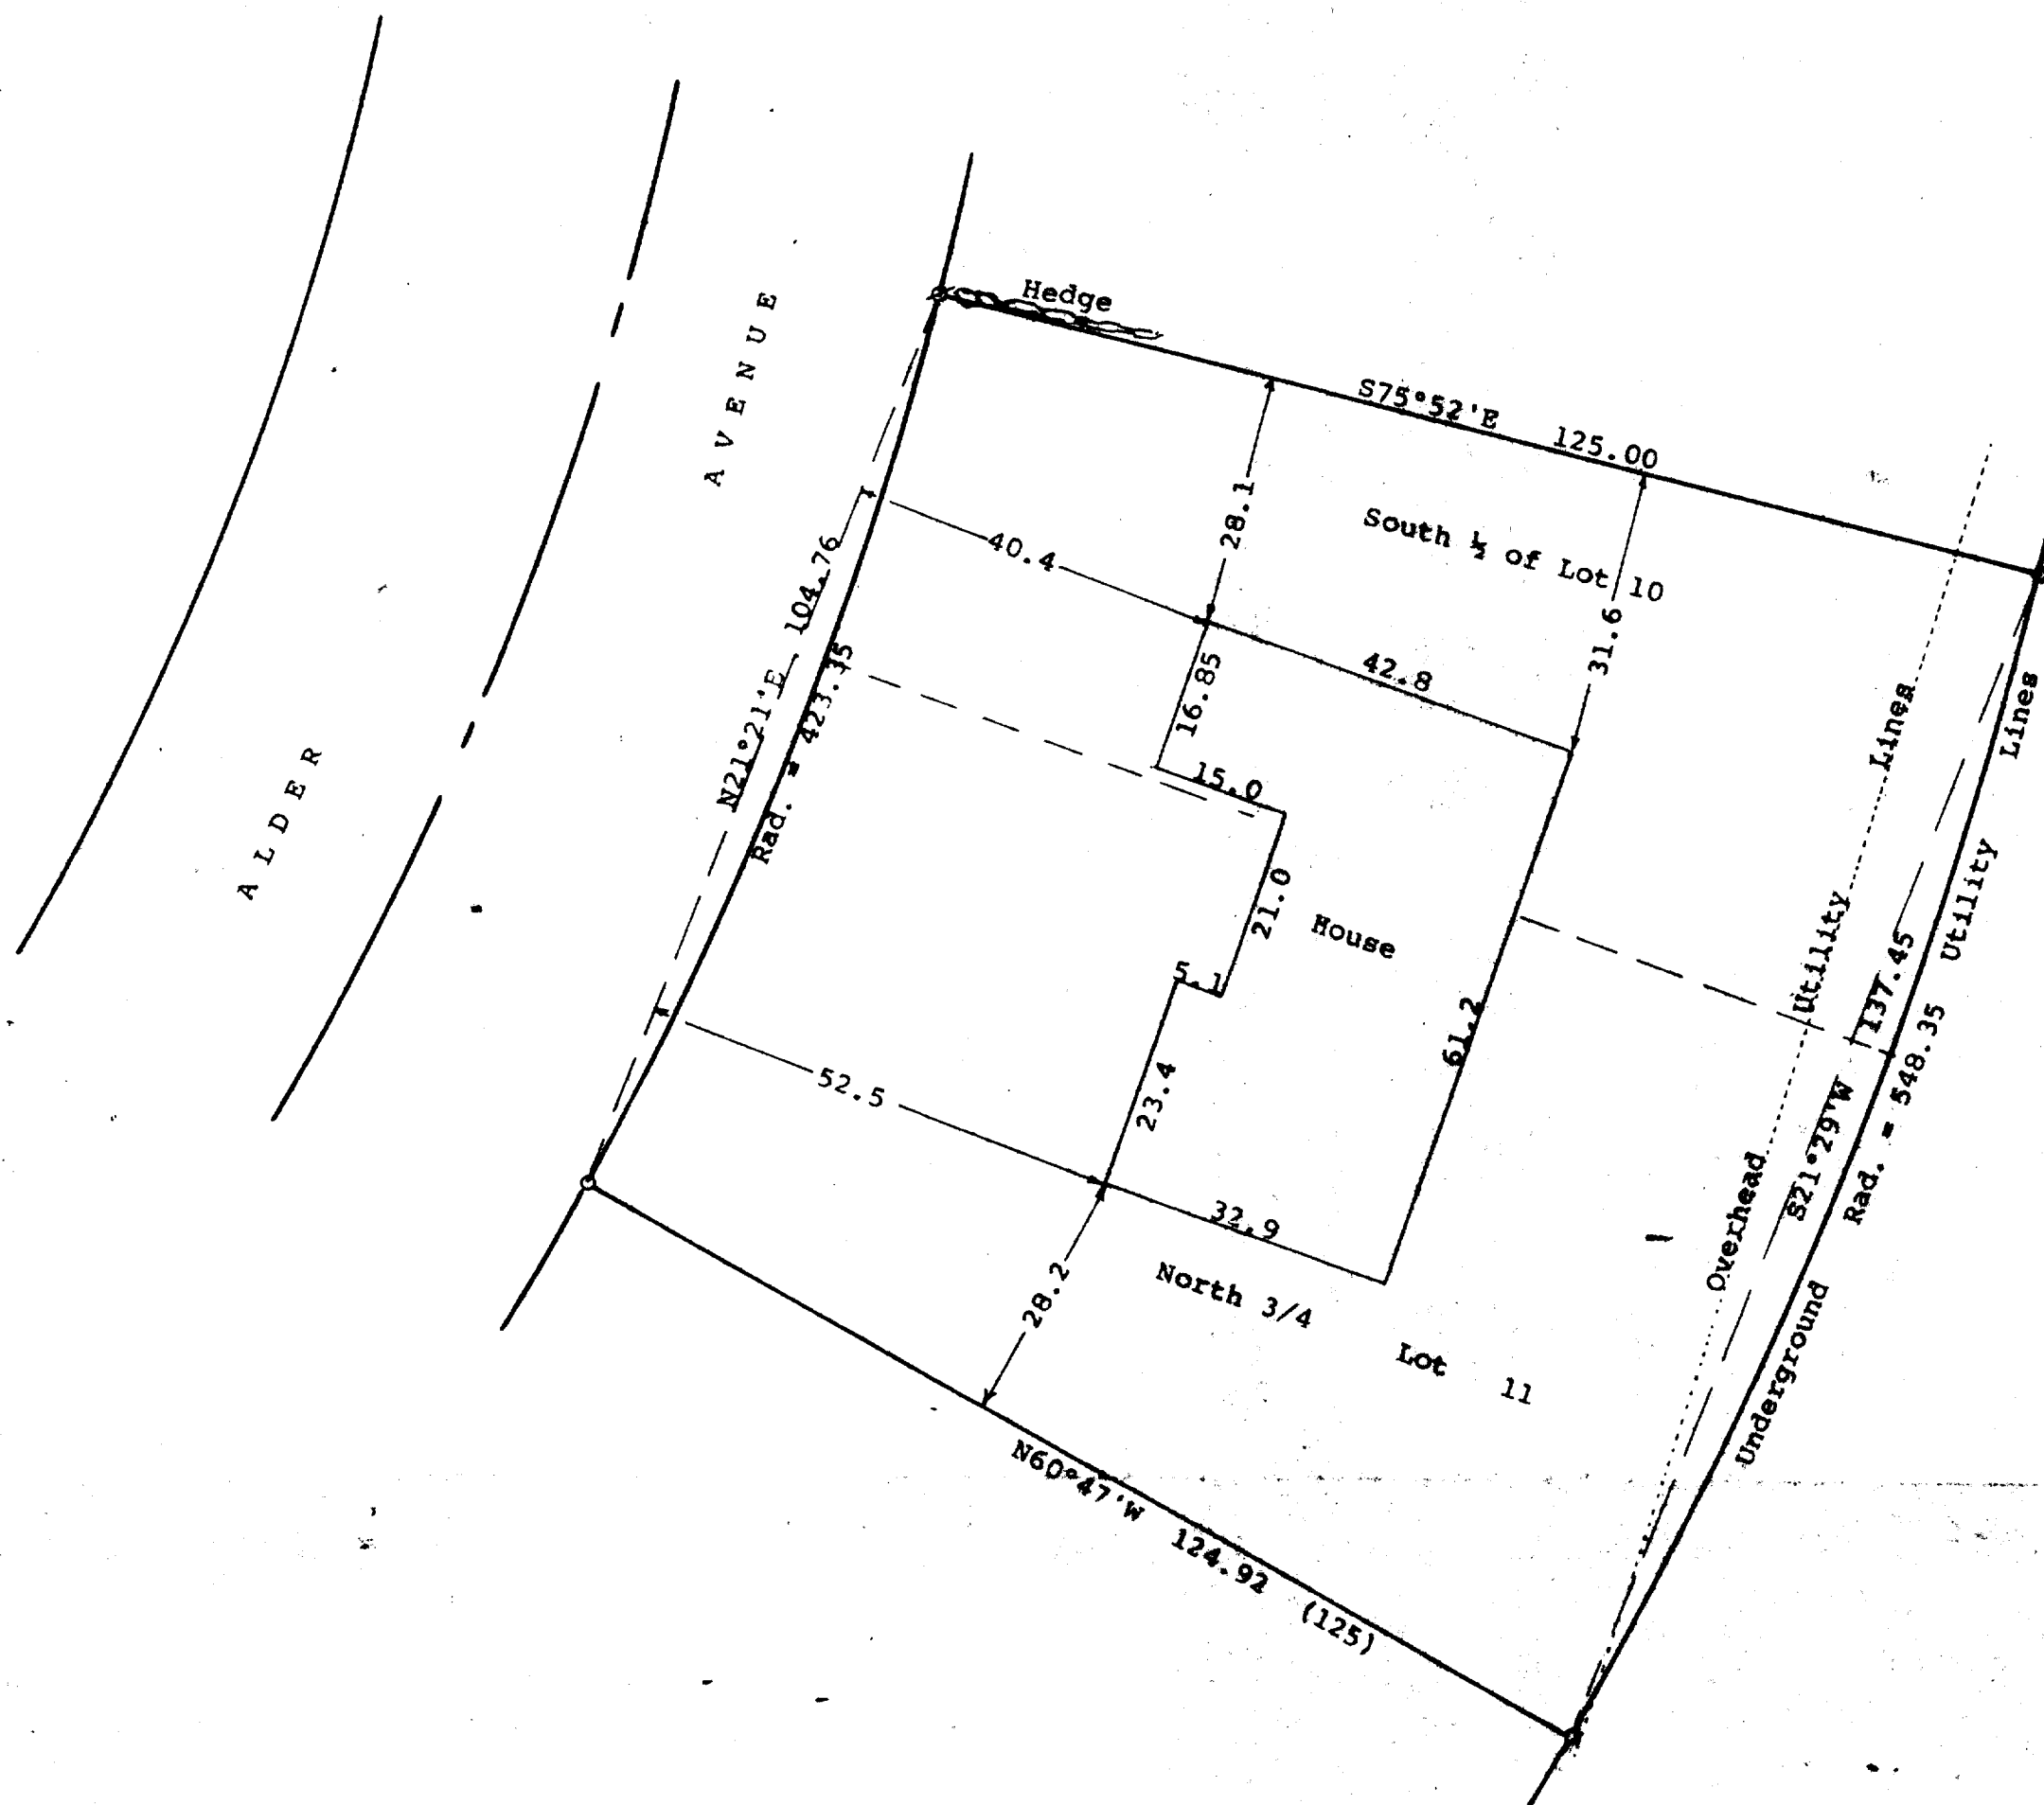

Scale - 1" = 20'
 ♂ = 1" Iron Pipe Found
 ○ = 1 1/4" Iron Pipe Found
 Bearings referenced to the southerly
 line of the North 3/4 of Lot 11, Block
 2, Allynhurst Subdivision-N60°47'W
 Owners: George T. and I. Maude Dunham
 725 Alder Avenue
 Delavan, WI 53115
 (0.00) = recorded distance



STATE OF WISCONSIN) SS
 COUNTY OF WALWORTH)

I, George T. Dunham, Surveyor, certify that I have surveyed the
 property described as follows:

The South 1/2 of Lot 10 and the North 3/4 of Lot 11, Block 2 of
 Allynhurst Subdivision located in the City of Delavan, Walworth
 County, Wisconsin.

and that the plat shown hereon is a correct representation thereof and shows
 the size and location of the property, its exterior boundaries, the location
 of all visible structures and dimensions of all principal buildings thereon,
 boundary fences, apparent easements, roadways and visible encroachments, if
 any, and that I have surveyed the property hereon described, according to the
 official records, to the best of my knowledge and belief.
 June 15, 1994

George T. Dunham
 George T. Dunham, Surveyor

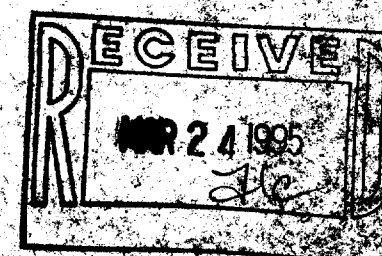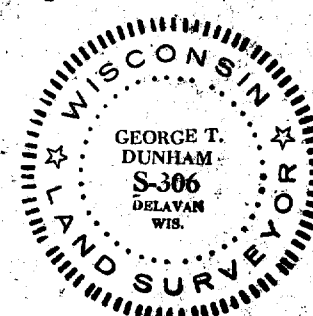

145-17
 1407