


DUNHAM SURVEYING, S.C.
SURVEYING & ENGINEERING
DELAVER, WISCONSIN 53115

SOUTH THIRD STREET

STREET

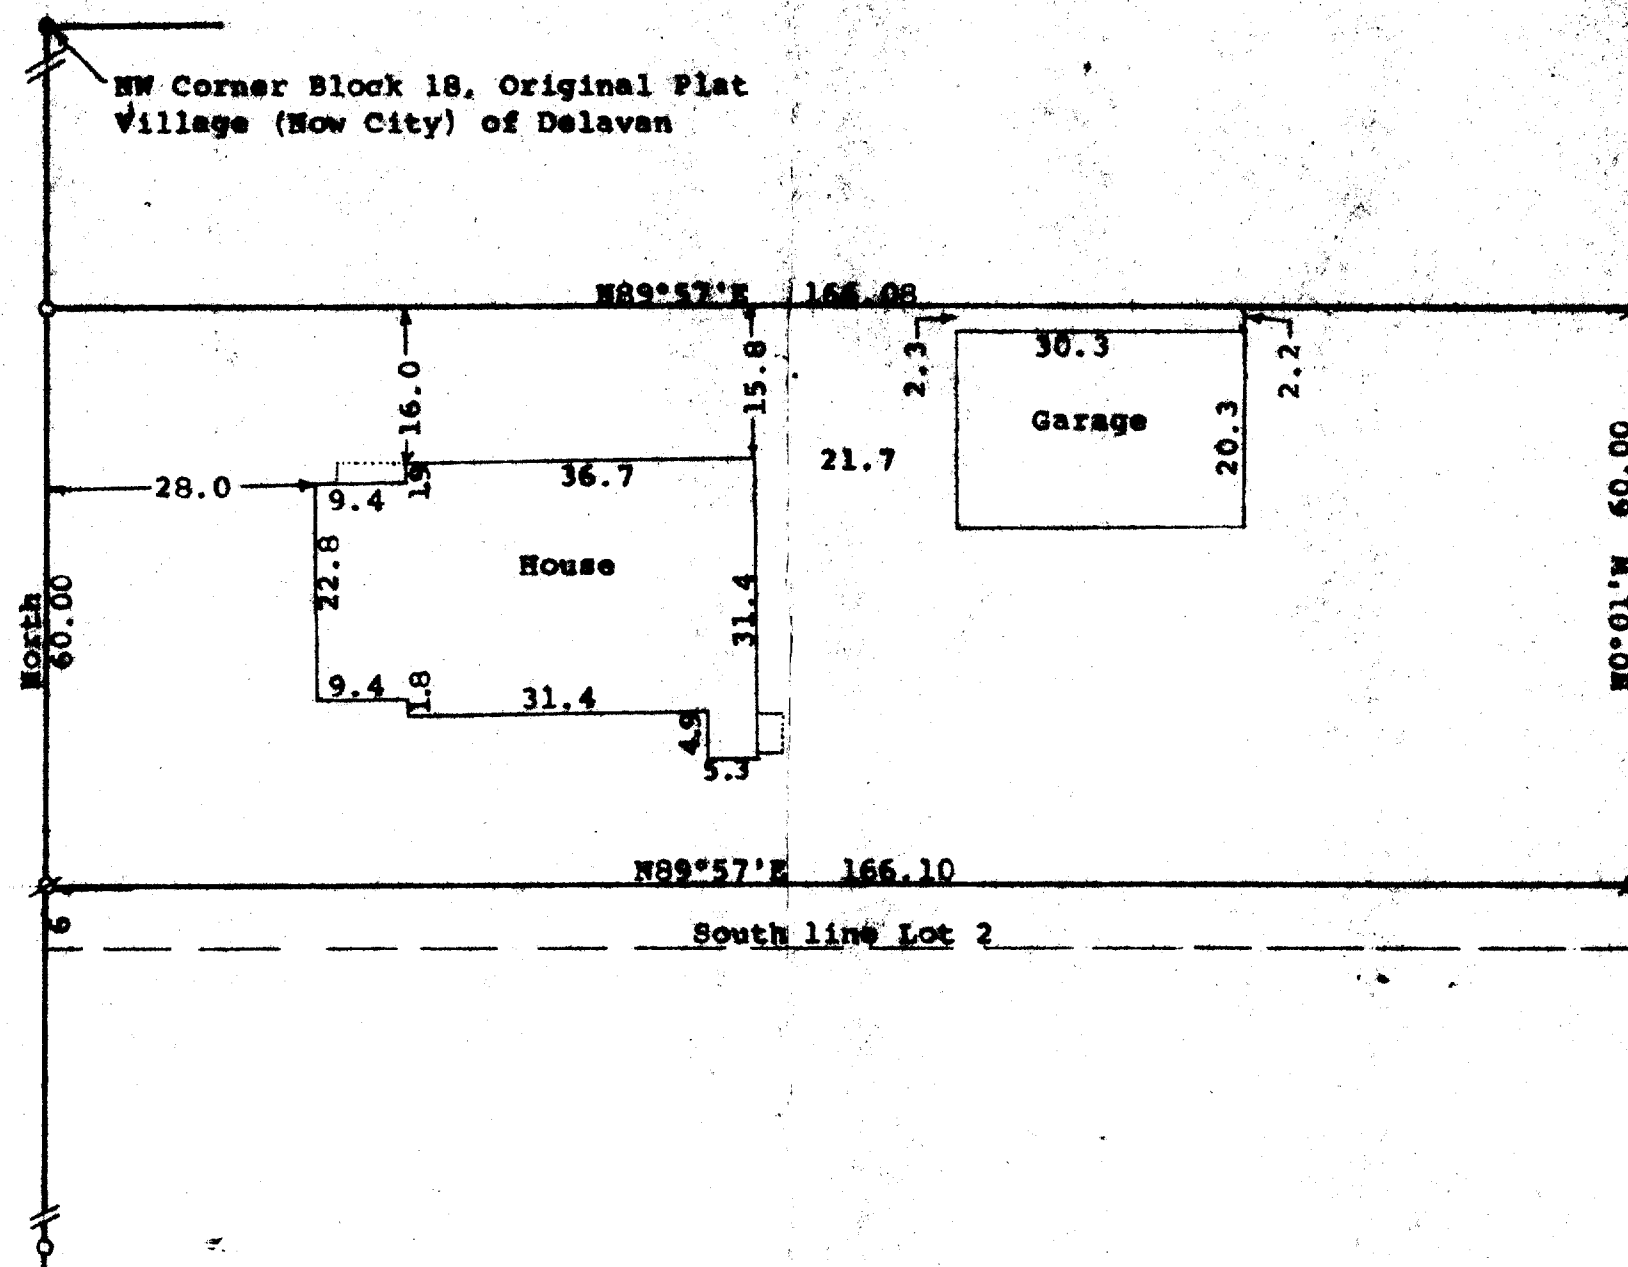

N

Scale - 1" = 20'

- = Concrete Monument Found
- Ø = 3/4" Iron Pipe Found
- = 3/4" X 24" Iron Pipe Set
- = Fence Line

Bearings referenced to the east line of South Third Street with the assumed bearing of North.

Survey ordered by: The Rauland Agency
118 Kenosha Street
Walworth, WI 53184

STATE OF WISCONSIN) SS
COUNTY OF WALWORTH)



I, George T. Dunham, Surveyor, certify that I have surveyed the property described as follows:

All that part of Lot 2 in Block 18 of the Original Plat of the Village, (Now City) of Delavan, Walworth County, Wisconsin, described as follows: Beginning at a point on the west line of said lot, 6 feet north of the southwest corner; thence East parallel with the south line of said lot to the east line thereof; thence North 60 feet; thence west parallel with the south line of said lot to the west line of thereof; thence south on the west line of said lot 60 feet to the place of beginning.

and that the plat shown hereon is a correct representation thereof and shows the size and location of the property, its exterior boundaries, the location of all structures and dimensions of all principal buildings thereon, boundary fences, apparent easements, roads, and visible encroachments, if any, and that I have surveyed the property hereon described, according to the official records, to the best of my knowledge and belief.

November 11, 1993

George T. Dunham
George T. Dunham, Surveyor

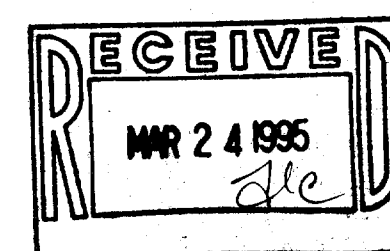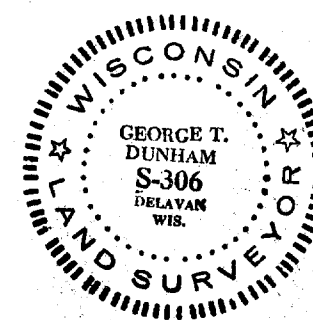

100-193

002-1411