


DUNHAM SURVEYING, S.C.
SURVEYING & MAPPING
DELAVER, WISCONSIN 53115

WASHINGTON

STREET

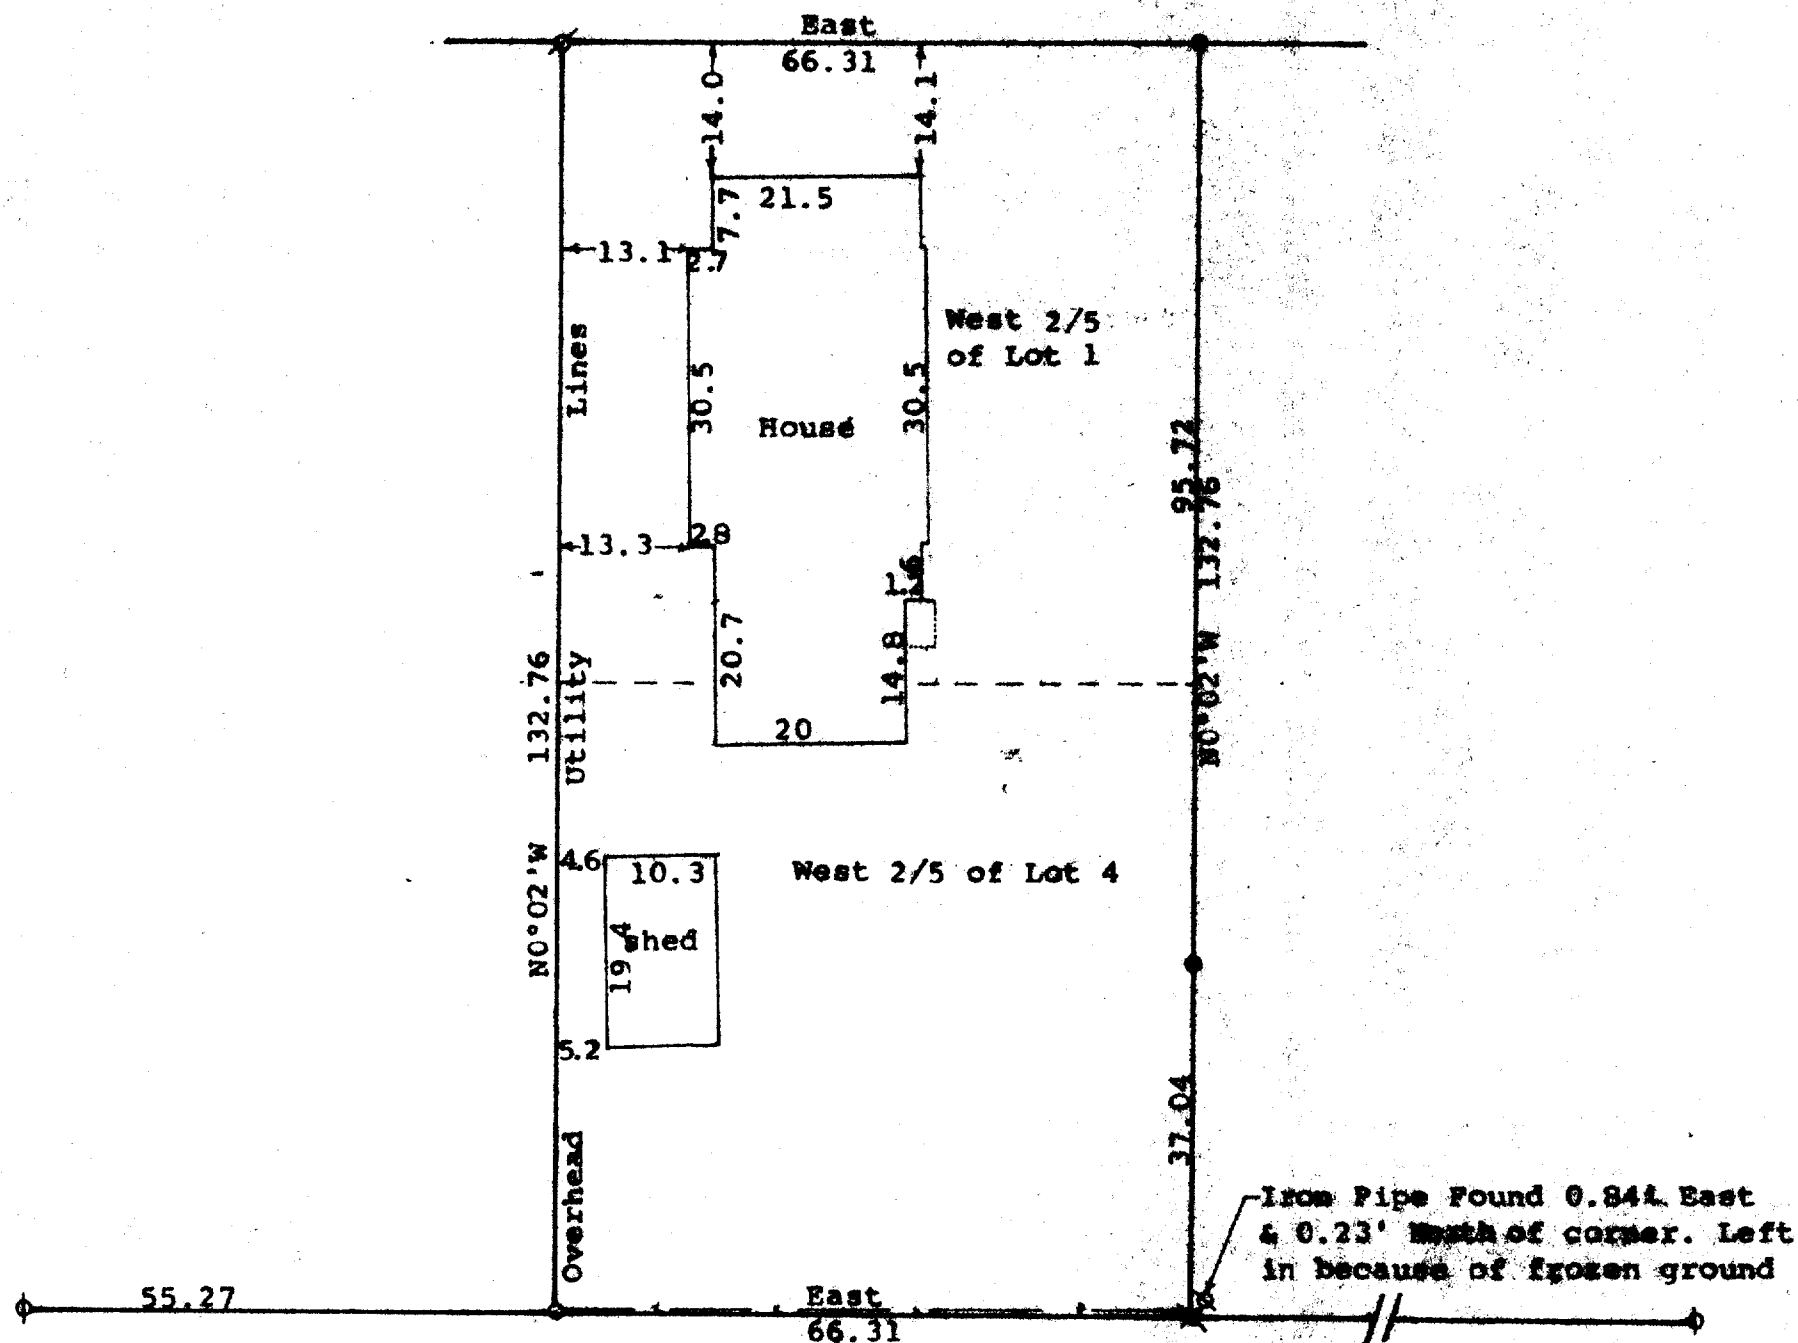

Scale - 1" = 20'

- = 5/8" Iron Rod Found
- = 1" Iron Pipe Found
- = 1 1/2" Iron Pipe Set
- ✕ = 3/4" Iron Pipe Set
- ⊗ = 1/2" Iron Pipe Found

Bearings referenced to the south line of Washington Street with the assumed bearing of East

Survey ordered by: RE-MAX GENEVA REALTY LTD
101 Broad Street
Lake Geneva, WI 53147

--- low fence line

⊗ = 3/4" Iron Pipe Found

STATE OF WISCONSIN)
COUNTY OF WALWORTH)



I, George T. Dunham, Surveyor, certify that I have surveyed the property described as follows:

The West 2/5 of Lots 1 and 4, all located in Block 5 in Passage, Aram, & Downie Addition to the City of Delavan, Walworth County, Wisconsin,

and that the plat shown hereon is a correct representation thereof and shows the size and location of the property, its exterior boundaries, the location of all visible structures and dimensions of all principal buildings thereon, boundary fences, apparent easements, roadways and visible encroachments, if any, and that I have surveyed the property hereon described, according to the official records, to the best of my knowledge and belief.

February 23, 1995

George T. Dunham
George T. Dunham, Surveyor

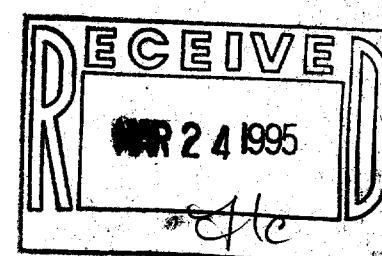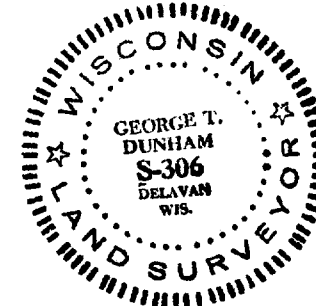

XP-71

002-1415