


DUNHAM SURVEYING, S.C.
SURVEYING & SUBDIVIDING
DELAVER, WISCONSIN 53115

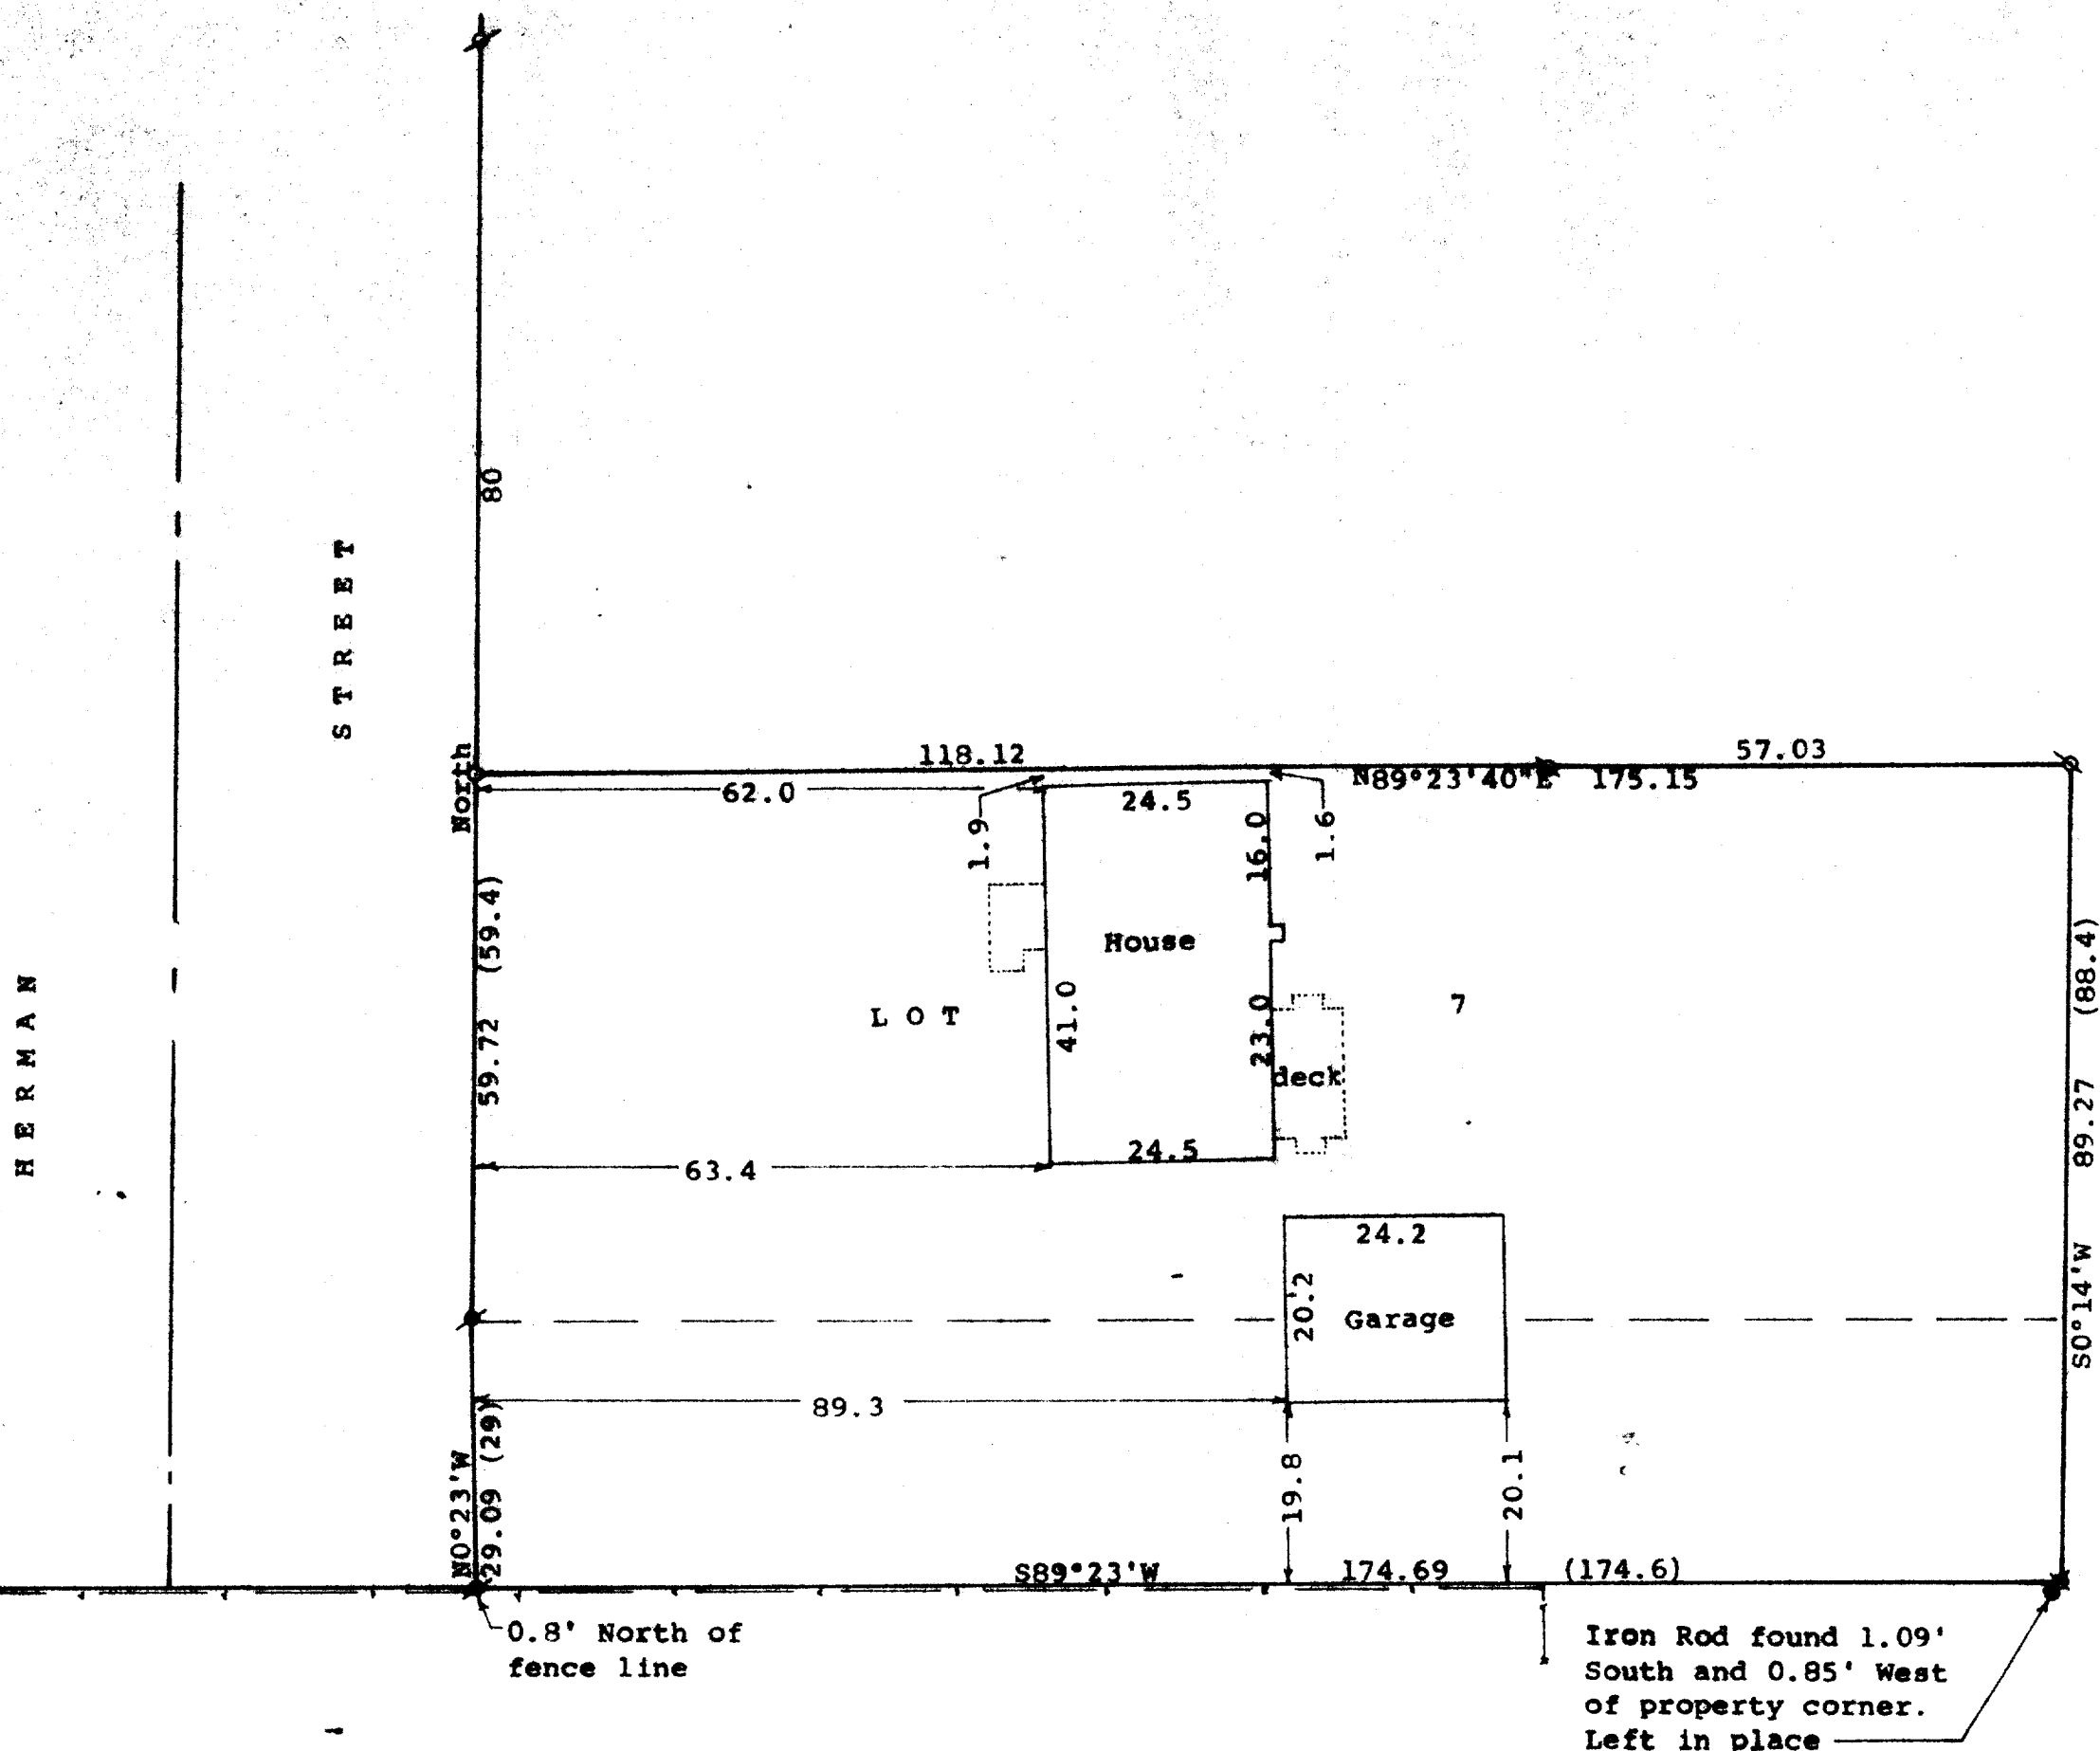

Scale - 1" = 20'

○ = 1/4" Iron Pipe Set

⊗ = 3/4" Iron Pipe Found

⊘ = 1 1/4" Iron Pipe Found

⊙ = 1" Iron Rod Found

● = 5/8" Iron Rod Found

⊗ = 3/4" Iron Pipe Set

(0.00) = recorded distance

Bearings referenced to the east line of Herman Street with the assumed bearing of North

Survey ordered by:

Century 21, Skandia Realty

312 South 7th Street

Delavan, WI 53115

— — — — — = fence line

STATE OF WISCONSIN) SS
COUNTY OF WALWORTH)



I, George T. Dunham, Surveyor, certify that I have surveyed the property described as follows:

Lot 7 in Block 7 of Fairview Heights, a subdivision located in the City of Delavan Walworth County, Wisconsin, together with a strip of land 29 feet in depth, North and South, immediately adjoining the southern boundary of the above described lot and extending the entire length.

and that the plat shown hereon is a correct representation thereof and shows the size and location of the property, its exterior boundaries, the location of all visible structures and dimensions of all principal buildings thereon, boundary fences, apparent easements, roadways and visible encroachments, if any, and that I have surveyed the property hereon described, according to the official records, to the best of my knowledge and belief.

February 20, 1995

George T. Dunham
George T. Dunham, Surveyor

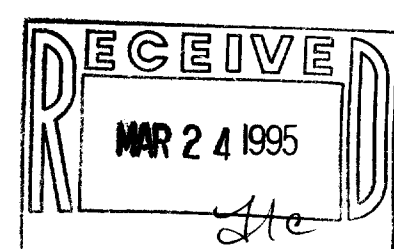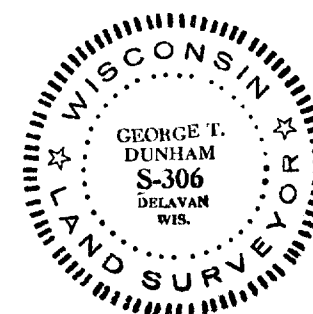

002-1416