


**ABELL
SURVEYING & MAPPING**
DELAVAN, WISCONSIN 53115
414-728-6737




SCALE 1" = 20'

LEGEND

- ⊙ - IRON PIPE FOUND
- BE - BASEMENT ENTRY
- WS - WOOD STOOP
- - OVERHEAD UTILITY LINES
- * - WOOD FENCE
- xx - WIRE FENCE
- () - RECORDED AS

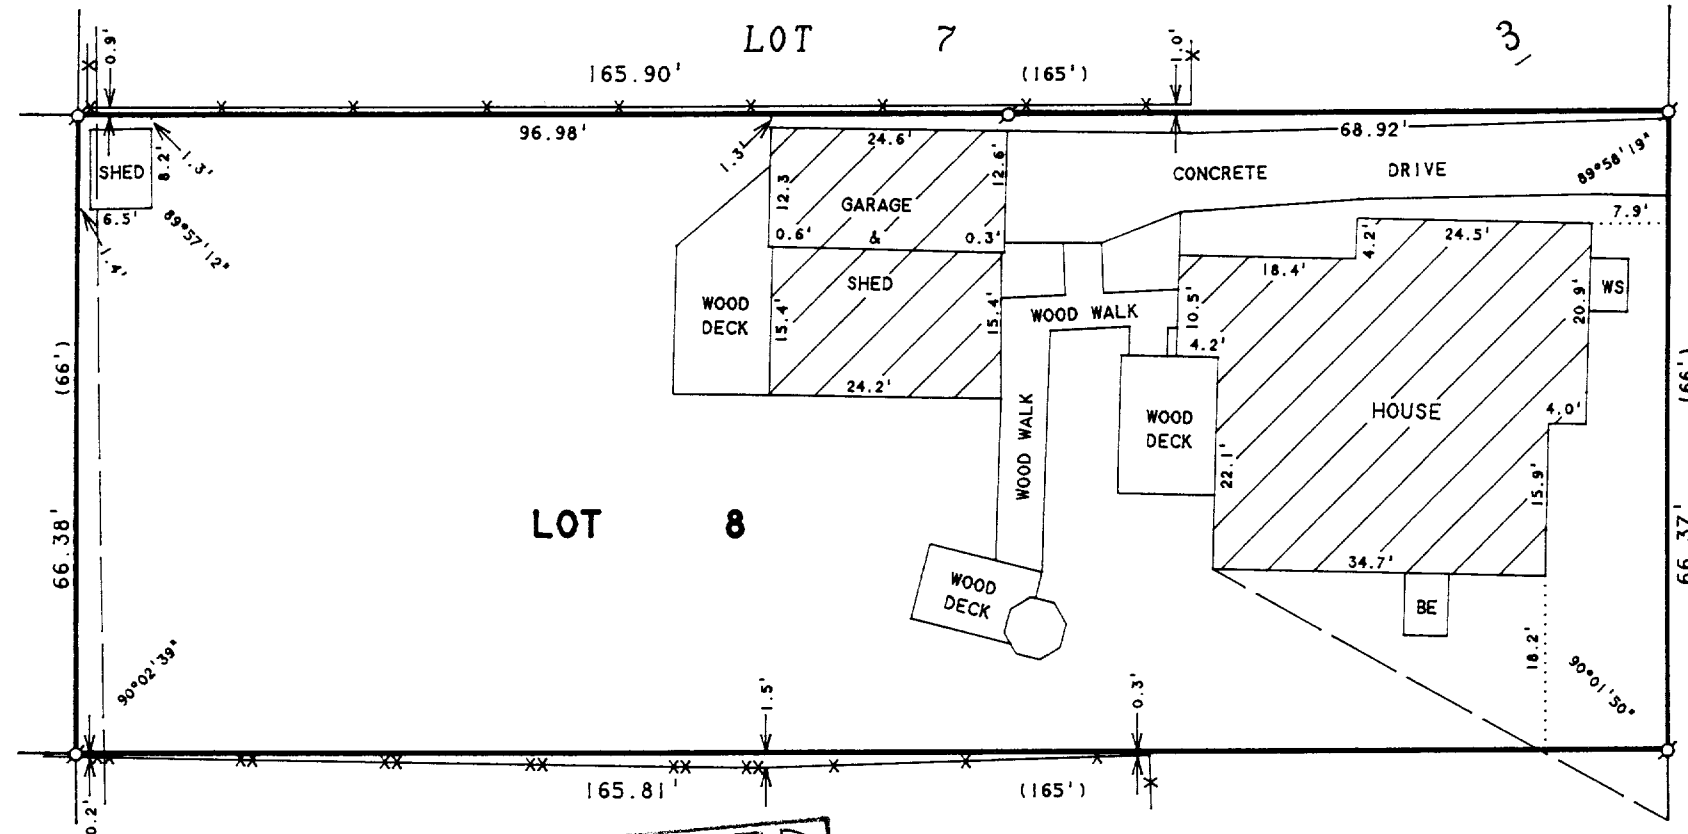

BLOCK

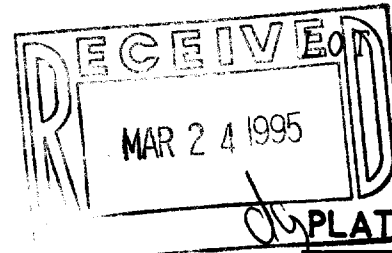

11

PLAT OF SURVEY OF

ORDERED BY: CENTURY 21-SKANDIA REALTY
312 S. 7th STREET
DELAVAN, WI. 53115

LOT 8, BLOCK 3, PASSAGE, ARAM & DOWNIE'S
ADDITION TO THE CITY OF DELAVAN, WALWORTH
COUNTY, WISCONSIN.

I HEREBY CERTIFY THAT I HAVE SURVEYED THE ABOVE DESCRIBED PROPERTY AND THAT THE ABOVE MAP IS A TRUE REPRESENTATION THEREOF AND SHOWS THE SIZE AND LOCATION OF THE PROPERTY, ITS EXTERIOR BOUNDARIES, THE LOCATION OF ALL VISIBLE STRUCTURES AND DIMENSIONS OF ALL PRINCIPAL BUILDINGS THEREON, BOUNDARY FENCES, APPARENT EASEMENTS, ROADWAYS AND VISIBLE ENCROACHMENTS, IF ANY, TO THE BEST OF MY KNOWLEDGE AND BELIEF.

THIS SURVEY IS MADE FOR THE USE OF THE PRESENT OWNERS OF THE PROPERTY, AND ALSO THOSE WHO PURCHASE, MORTGAGE, OR GUARANTEE THE TITLE THERETO WITHIN ONE (1) YEAR FROM DATE HEREON.

David F. Abell

DAVID F. ABELL
WISCONSIN REGISTERED LAND SURVEYOR, S-1596

March 1, 1995

DATE: _____ JOB NUMBER - 95010
NOTE: THIS IS NOT A CERTIFIED COPY UNLESS SEALED.

XP-35

002-1426