



PHOENIX STREET

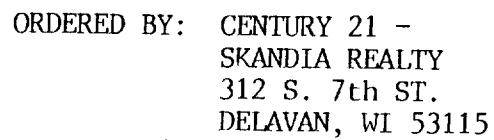

LOT 8, BLOCK 3, SARA A. PHOENIX ADDITION,  
CITY OF DELAVAN, WALWORTH COUNTY, WISCONSIN.

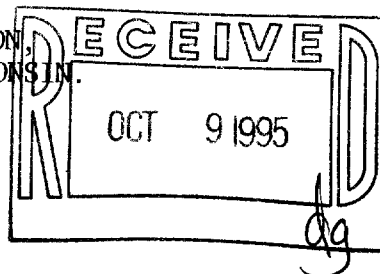

o - IRON PIPE FOUND  
o - UTILITY PED  
-x- WIRE FENCE  
( ) - RECORDED AS  
BE - BASEMENT ENTRY

FROM DATE HEREON.

*David F. Abell*

DAVID F. ABELL  
WISCONSIN REGISTERED LAND SURVEYOR. S-1596

April 18, 1995

DATE 7/11/75 JOB NUMBER - 95028  
NOTE: THIS IS NOT A CERTIFIED COPY UNLESS SEALED.