



ABELL
SURVEYING & MAPPING
 DELAVAN, WISCONSIN 53115
 414-728-6737

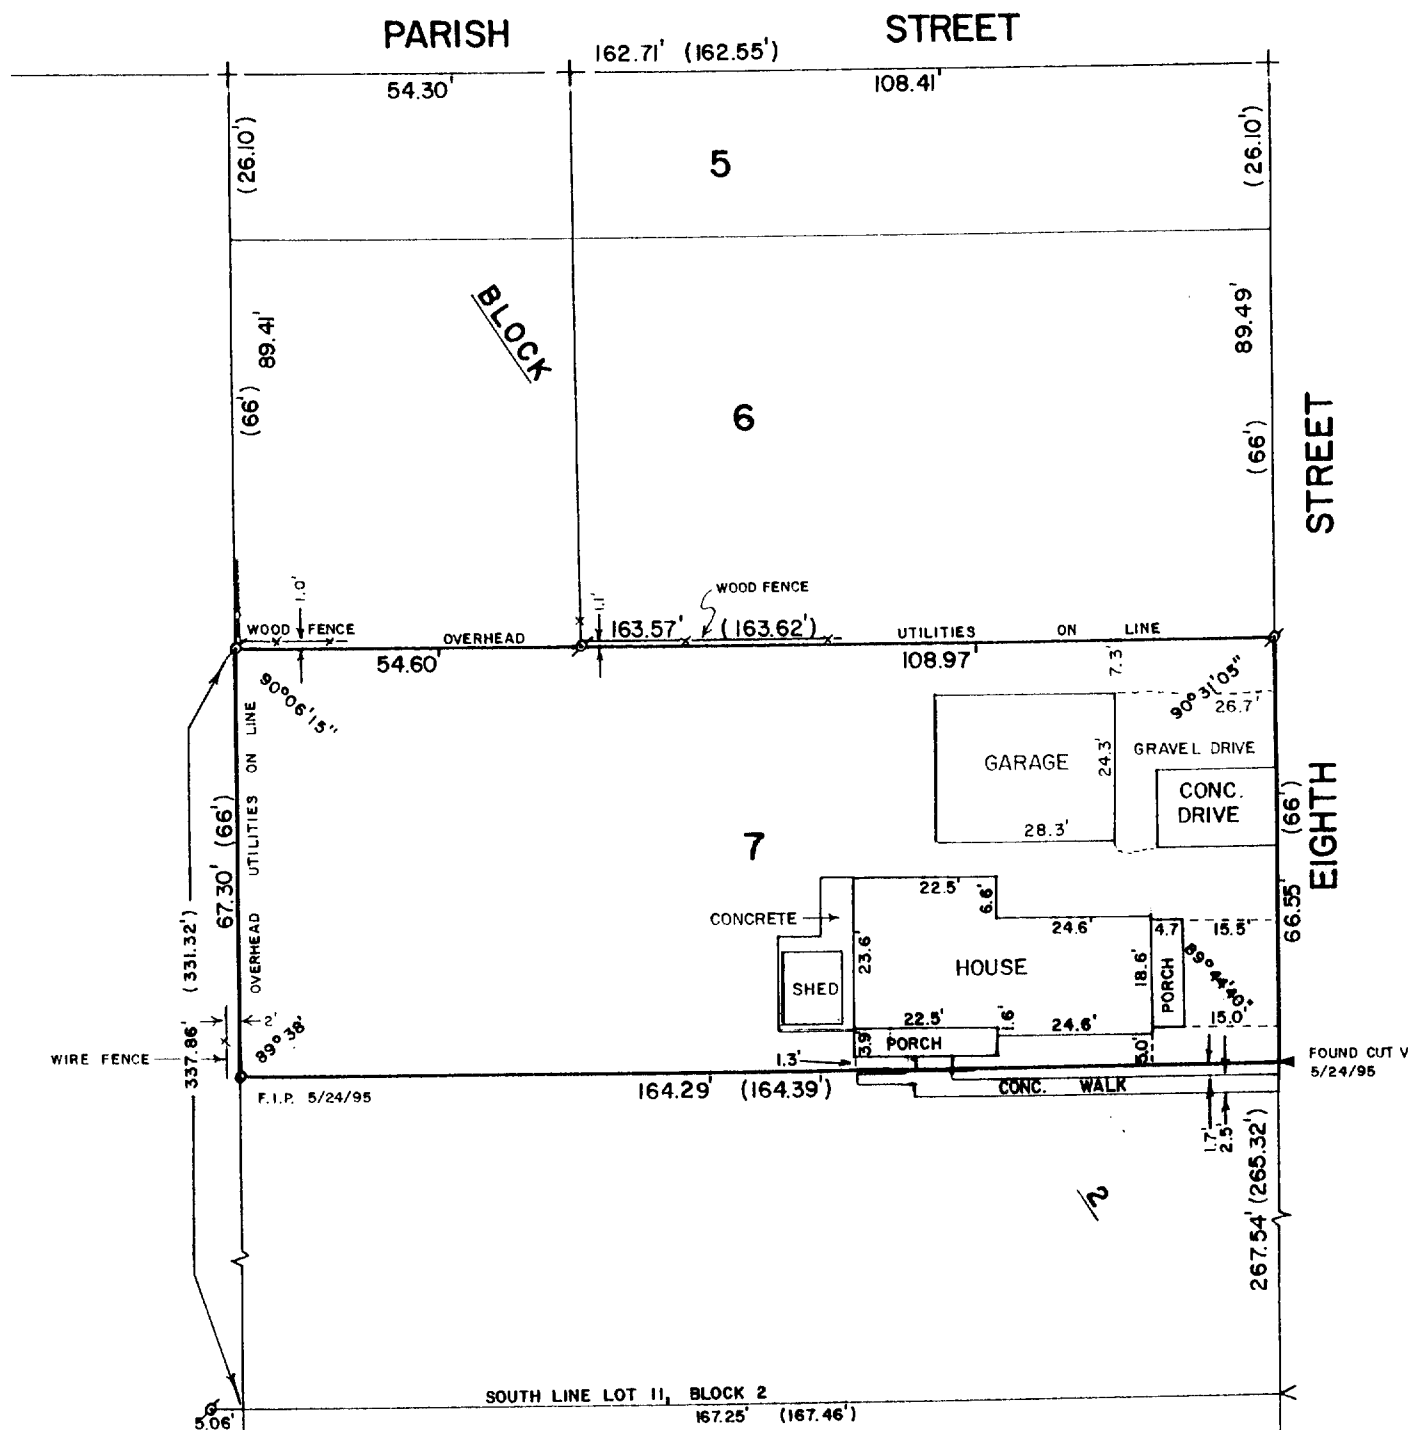

PLAT OF SURVEY OF

LOT 7, BLOCK 2 OF J. B. DEVENDORF'S ADDITION TO THE
 VILLAGE (NOW CITY) OF DELAVAN, WALWORTH COUNTY,
 WISCONSIN.

REVISED: MAY 25, 1995
 ORDERED BY: CENTURY 21 - SKANDIA REALTY
 312 S. 7th ST.
 DELAVAN, WI 53115

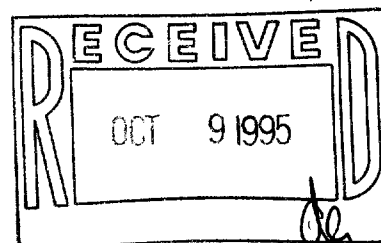

SCALE - 1"=30'

LEGEND

- o - IRON PIPE FOUND
- o - IRON PIPE SET
- + - CUT CROSS IN CONCRETE FOUND
- < - CUT V IN CONCRETE FOUND
- ▲ - CUT V IN WEST EDGE OF CONCRETE WALK PLACED
- () - RECORDED DISTANCES

I, DAVID F. ABELL, DO HEREBY CERTIFY
 THAT I HAVE SURVEYED THE PROPERTY
 HEREON DESCRIBED ACCORDING TO THE
 OFFICIAL RECORDS AND THAT THE PLAT
 HEREON IS A CORRECT REPRESENTATION
 OF THE PROPERTY LINES TO THE BEST OF
 MY KNOWLEDGE AND BELIEF.

David F. Abell
 DAVID F. ABELL
 WISCONSIN REGISTERED LAND SURVEYOR, S-1596

DATE *January 13, 1987* JOB NUMBER - 87003
 NOTE: THIS IS NOT A CERTIFIED COPY UNLESS SEALED.

NDE-16

002-1463