



ABELL
SURVEYING & MAPPING
DEHAVAN, WISCONSIN 53115
414-728-6737

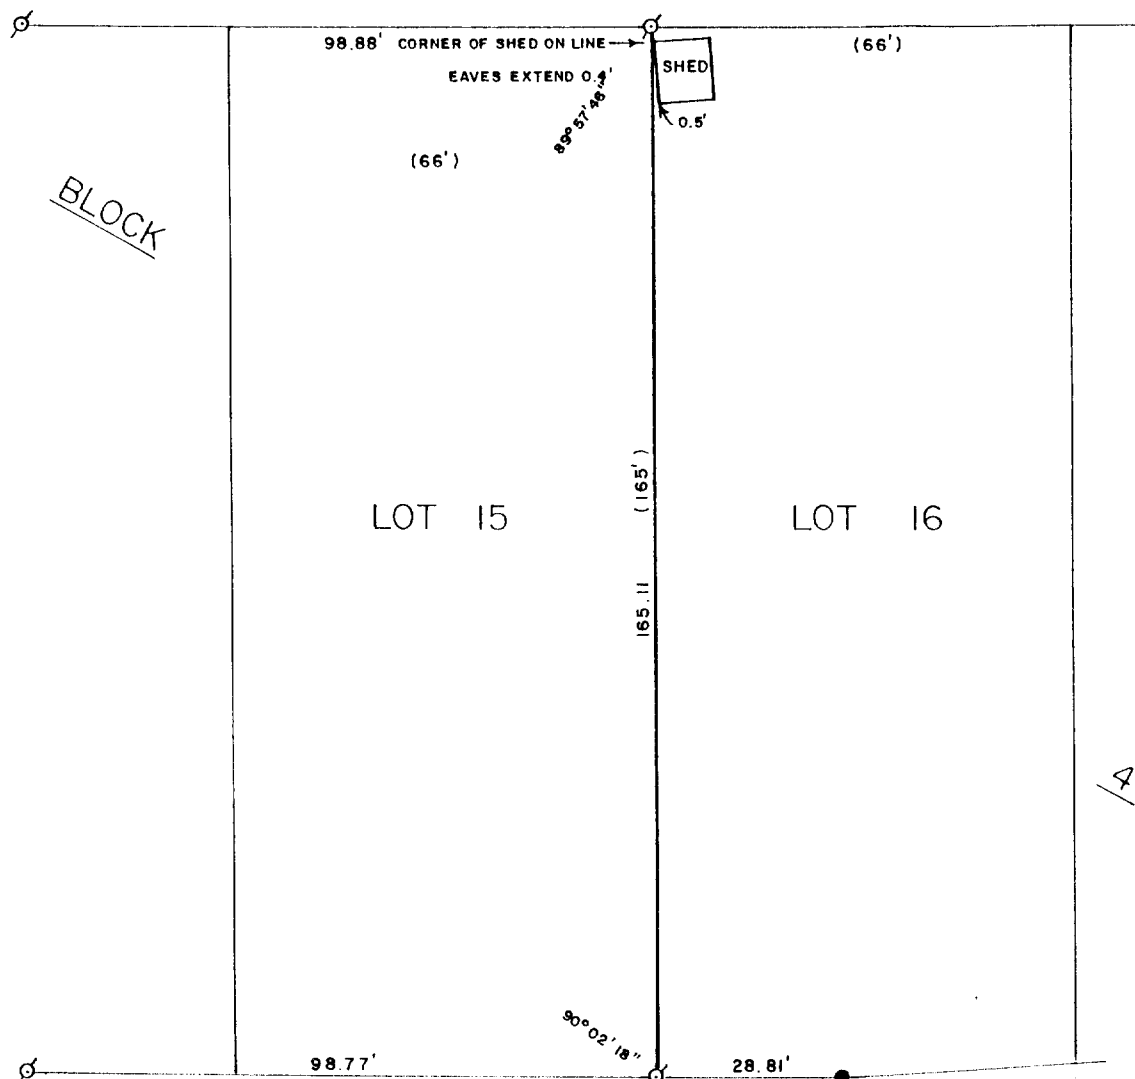

RACINE STREET

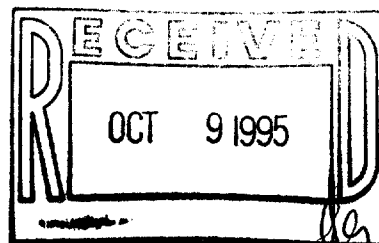

PLAT OF SURVEY OF

THE WEST LINE OF LOT 16, BLOCK 4, ELMHURST
SUBDIVISION, CITY OF DELAVAN, WALWORTH
COUNTY, WISCONSIN

ORDERED BY: CLAIR LAW OFFICE
P.O. BOX 445
DEHAVAN, WI 53115



SCALE - 1"=30'

LEGEND

- ⊙ - IRON PIPE FOUND
- - IRON ROD FOUND
- () - RECORDED AS

I, DAVID F. ABELL, DO HEREBY CERTIFY
THAT I HAVE SURVEYED THE PROPERTY
HEREON DESCRIBED ACCORDING TO THE
OFFICIAL RECORDS AND THAT THE PLAT
HEREON IS A CORRECT REPRESENTATION
OF THE PROPERTY LINES TO THE BEST OF
MY KNOWLEDGE AND BELIEF.

David F. Abell
DAVID F. ABELL

WISCONSIN REGISTERED LAND SURVEYOR, S-1596

May 10, 1995
DATE

JOB NUMBER - 95039

NOTE: THIS IS NOT A CERTIFIED COPY UNLESS SEALED.

XE4-44

002-1471