


DUNHAM & RASMUSSEN
SURVEYING & ENGINEERING
DELAVAN, WISCONSIN

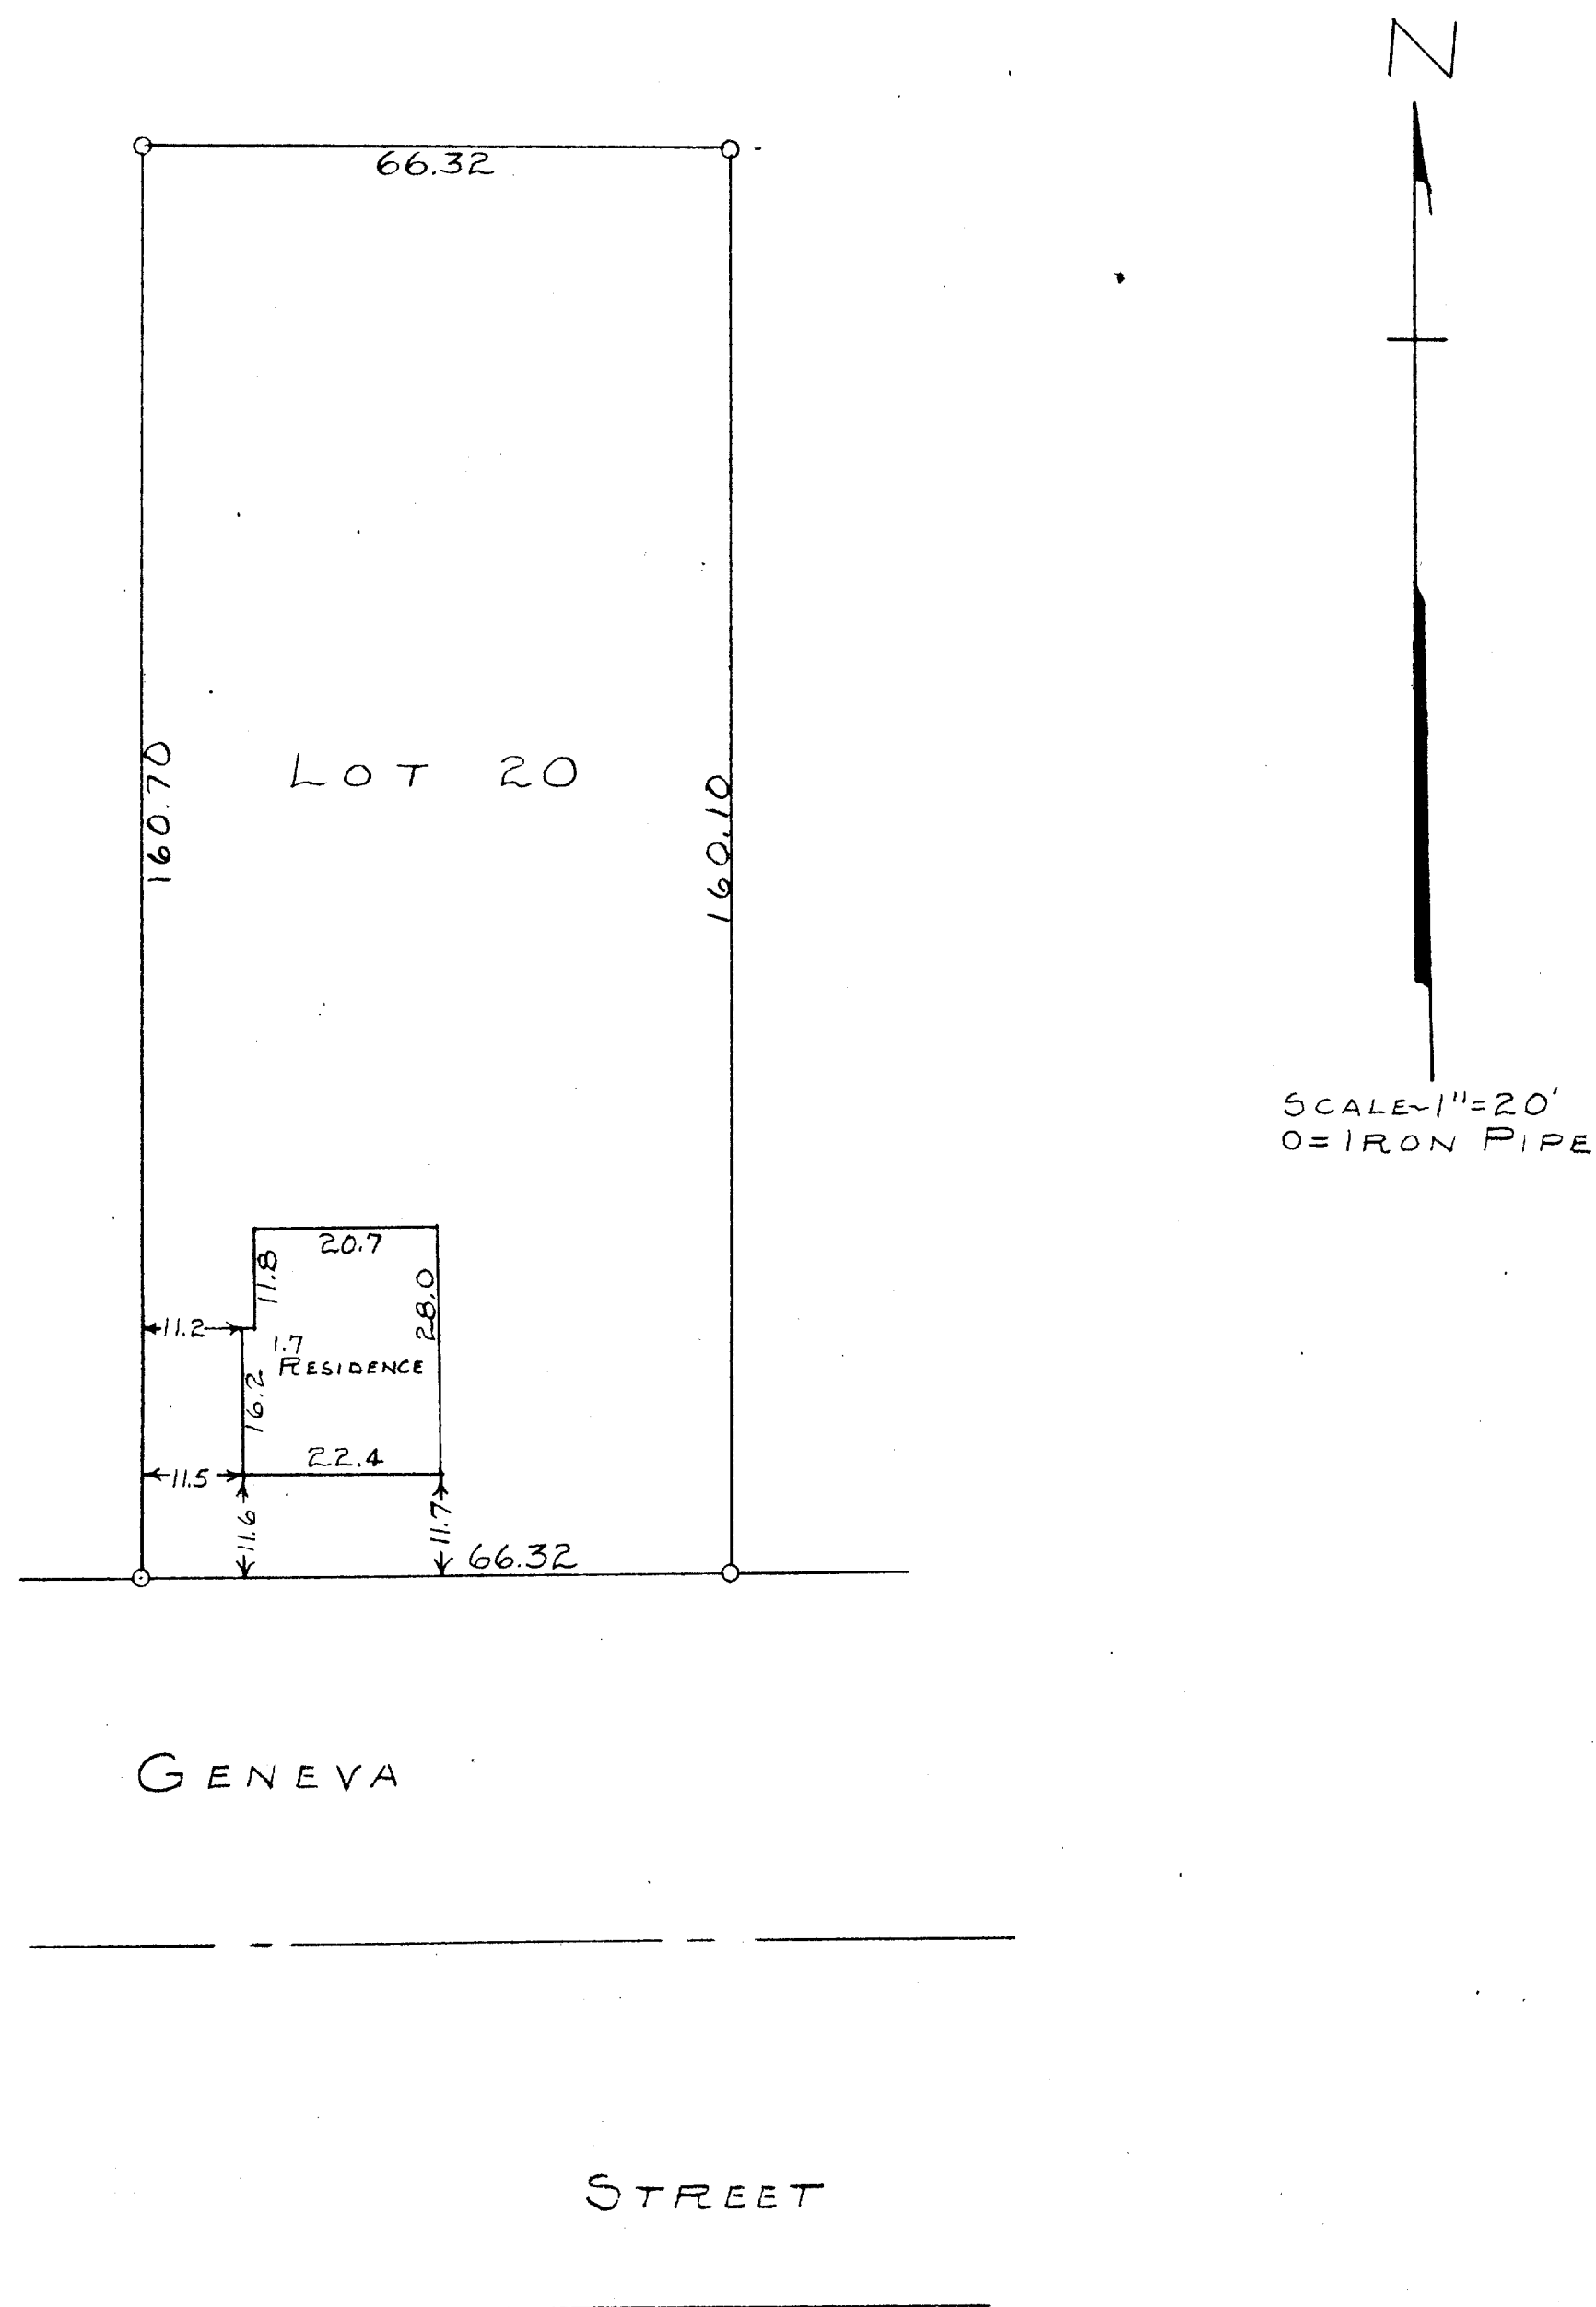

STATE OF WISCONSIN) SS
WALWORTH COUNTY)

I, George T. Dunham, do hereby certify that I have surveyed the property described as follows,

Lot 20, Block 4 of Passage, Aram and Downie Addition to the City of Delavan, Walworth County, Wisconsin.

and that the plat shown above is a correct representation of the property lines and of the improvements located thereon.

May 13, 1960

George T. Dunham
George T. Dunham, Surveyor