

ABERNATHY and ASSOCIATES

Kenneth B. Abernathy Jr.

Wisconsin Registered Land Surveyor S-1594

Rt. 3, Box 273
Elkhorn, Wisconsin 53121
Phone: (414) 723-4260 (office)
(414) 723-7209 (FAX)

PLAT OF SURVEY


LOT 6 OF BLOCK 3 OF CHESTNUT RIDGE
SUBDIVISION WEST LOCATED IN THE SOUTHEAST
1/4 OF THE SOUTHWEST 1/4 AND THE
NORTHEAST 1/4 OF THE SOUTHWEST 1/4 OF
SECTION 13, TOWN 2 NORTH, RANGE 15 EAST,
CITY OF DELAVAN, WALWORTH COUNTY,
WISCONSIN.

ORDERED BY: BROOKSTONE HOMES
4450 MILTON AVE. SUITE 206
JANESVILLE, WI. 53546

JOB REFERENCE NO. 112-02-006
P.O. # 7391 DATED 2/7/96


NOTE:

WOOD STAKES OR 60 PENNY SPIKES HAVE BEEN PLACED AT
BUILDING CORNERS. BUILDER IS TO VERIFY DIMENSIONS
WHICH HAVE BEEN ROUNDED TO THE NEAREST TENTH OF A
FOOT TO INSURE PROPER PLAN INTERPRETATION AND
CONTACT THIS OFFICE IMMEDIATELY IF ANY DISCREPANCY
EXISTS.

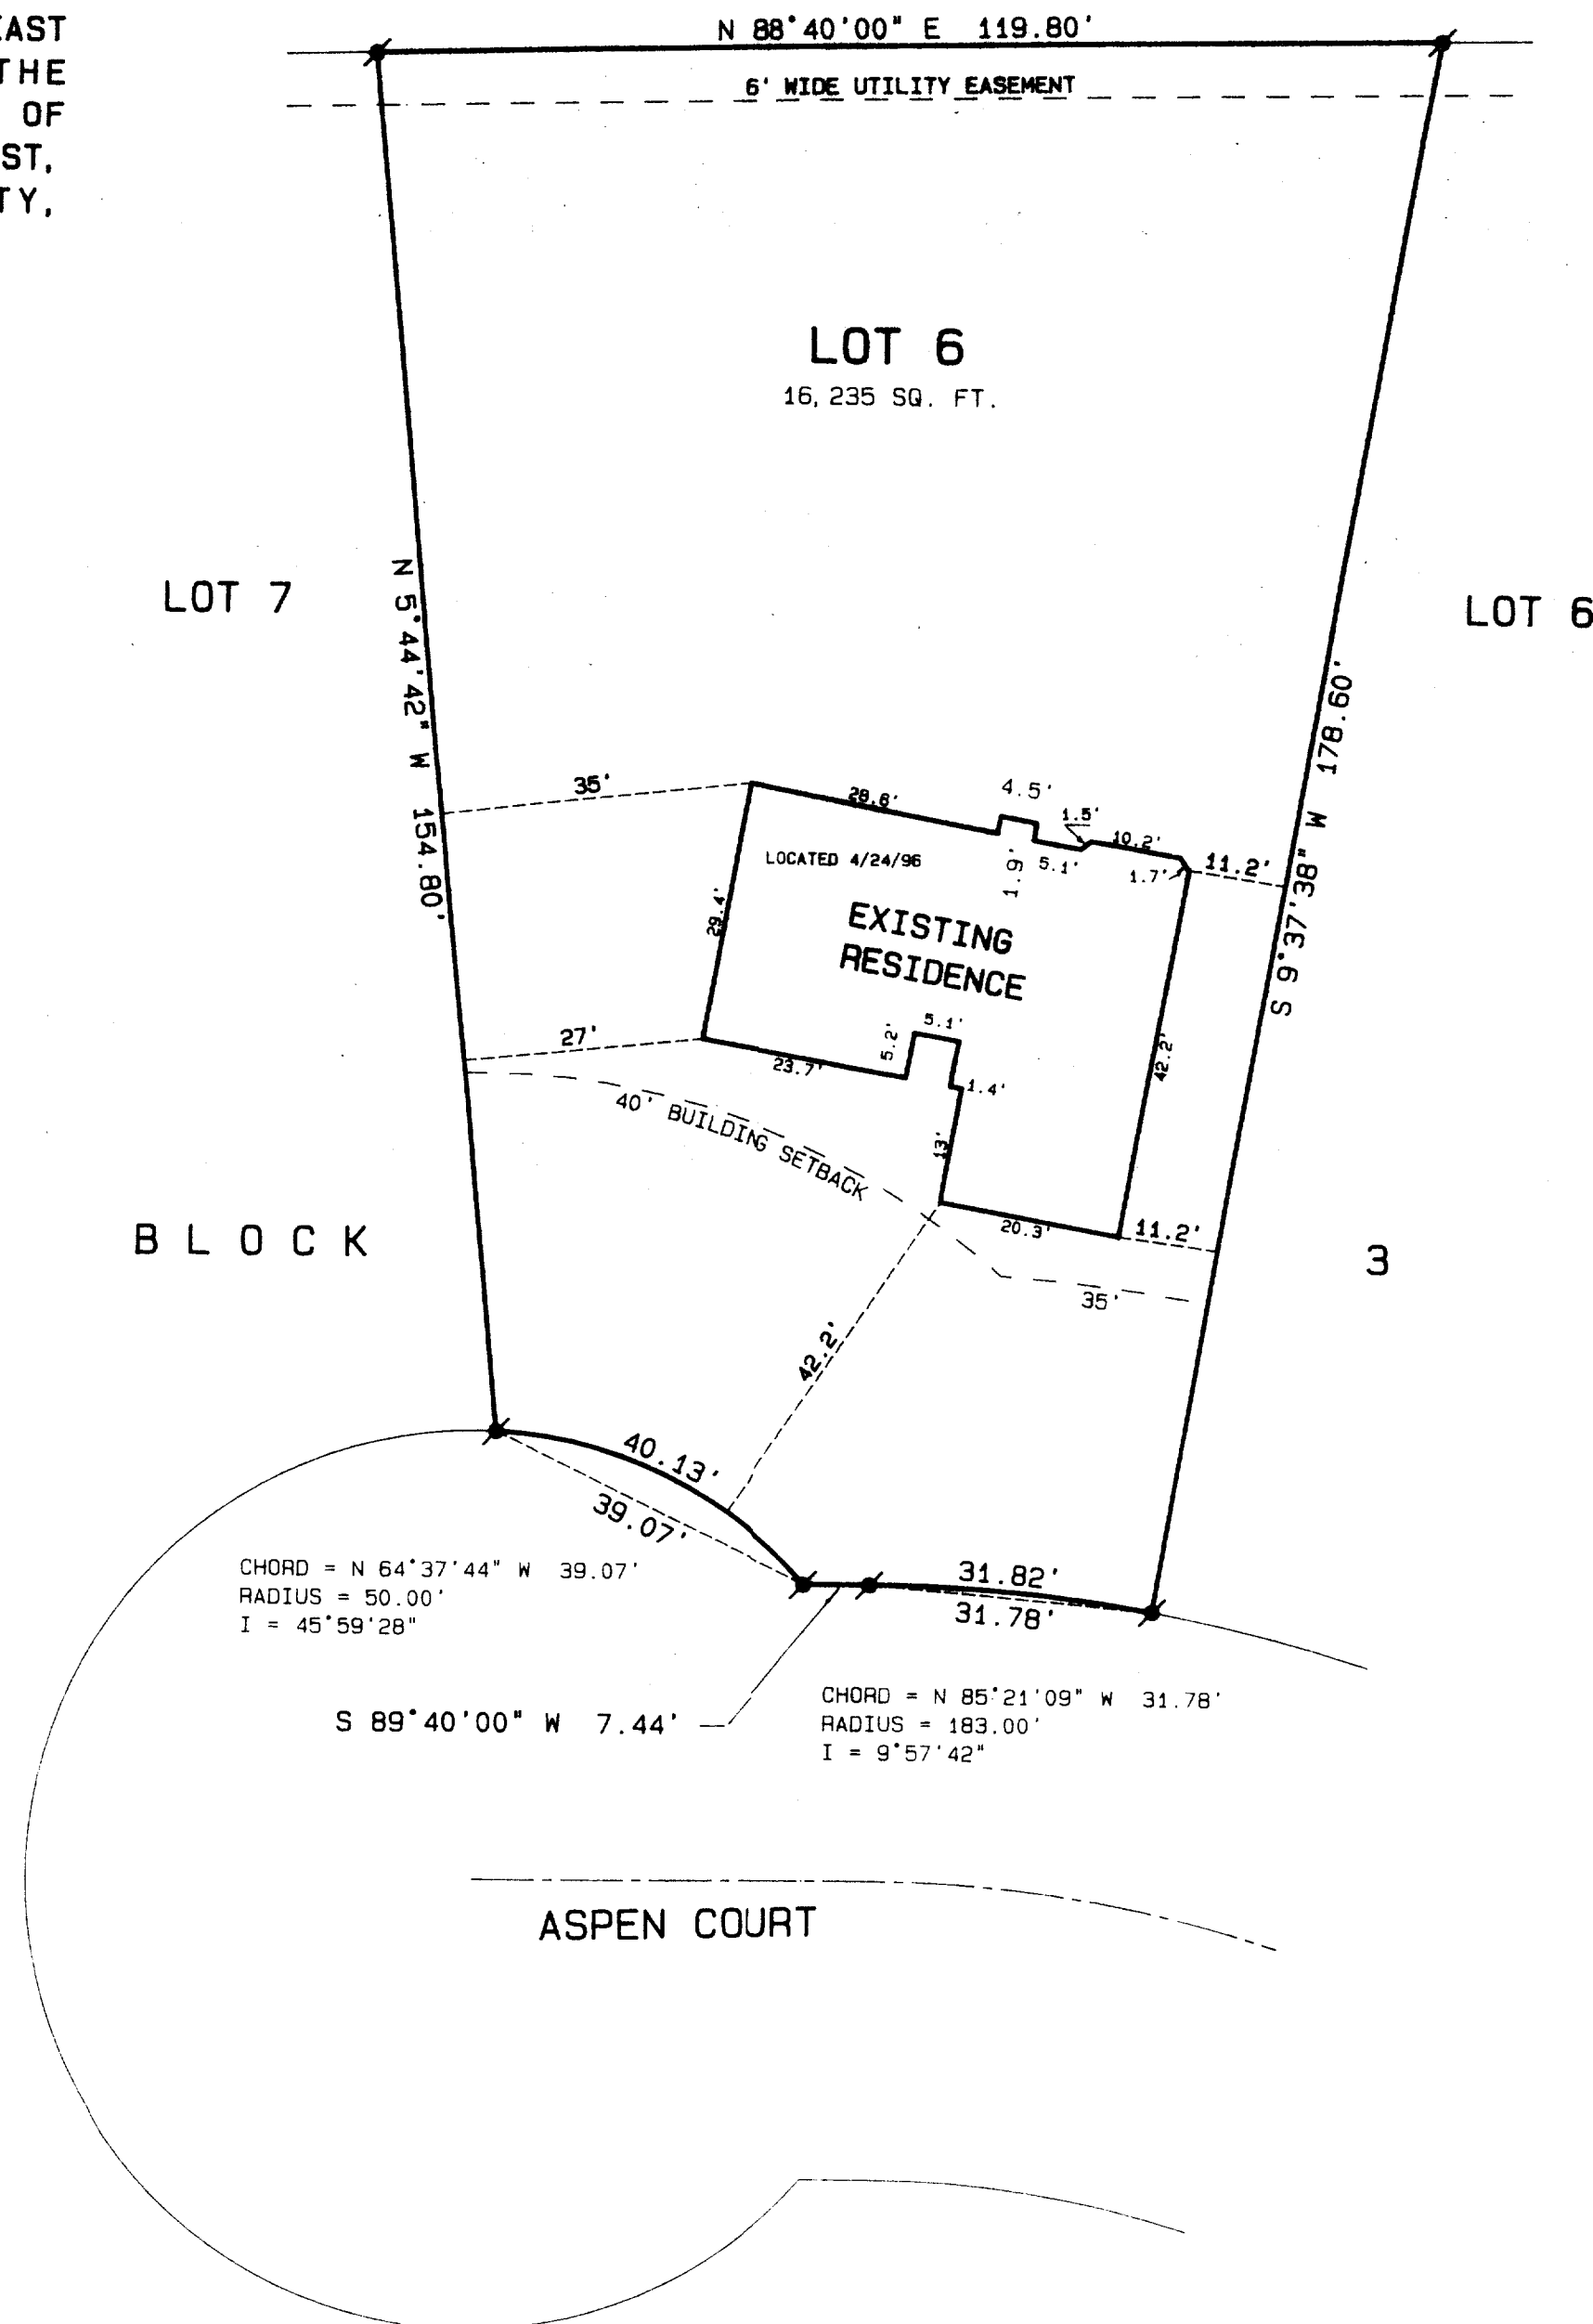

Legend

- FOUND IRON PIPE
- FOUND IRON ROD
- FOUND BRASS CAPPED MONUMENT
- FOUND CONCRETE MONUMENT
- CHISEL CUT IN CONCRETE
- SET IRON ROD, 24" LONG, WEIGHING 1.5 LBS./LINEAL FT., 3/4" DIA.
- SET IRON ROD, 30" LONG, WEIGHING 4.5 LBS./LINEAL FT., 1-11/16" DIA.
- RECORDED AS DIMENSION
- EXISTING FENCE

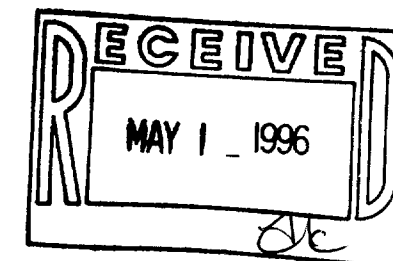

SCALE: 1" = 20 FEET



AS BUILT REVISION 4/25/96

KENNETH B. ABERNATHY, JR.
WISCONSIN REGISTERED LAND SURVEYOR,
S-1594

Date: 2-20-96 Job No. 96.205

XCRW-15

002-1504