


DUNHAM SURVEYING, S.C.
SURVEYING & SUBDIVIDING
DELAVER, WISCONSIN 53115

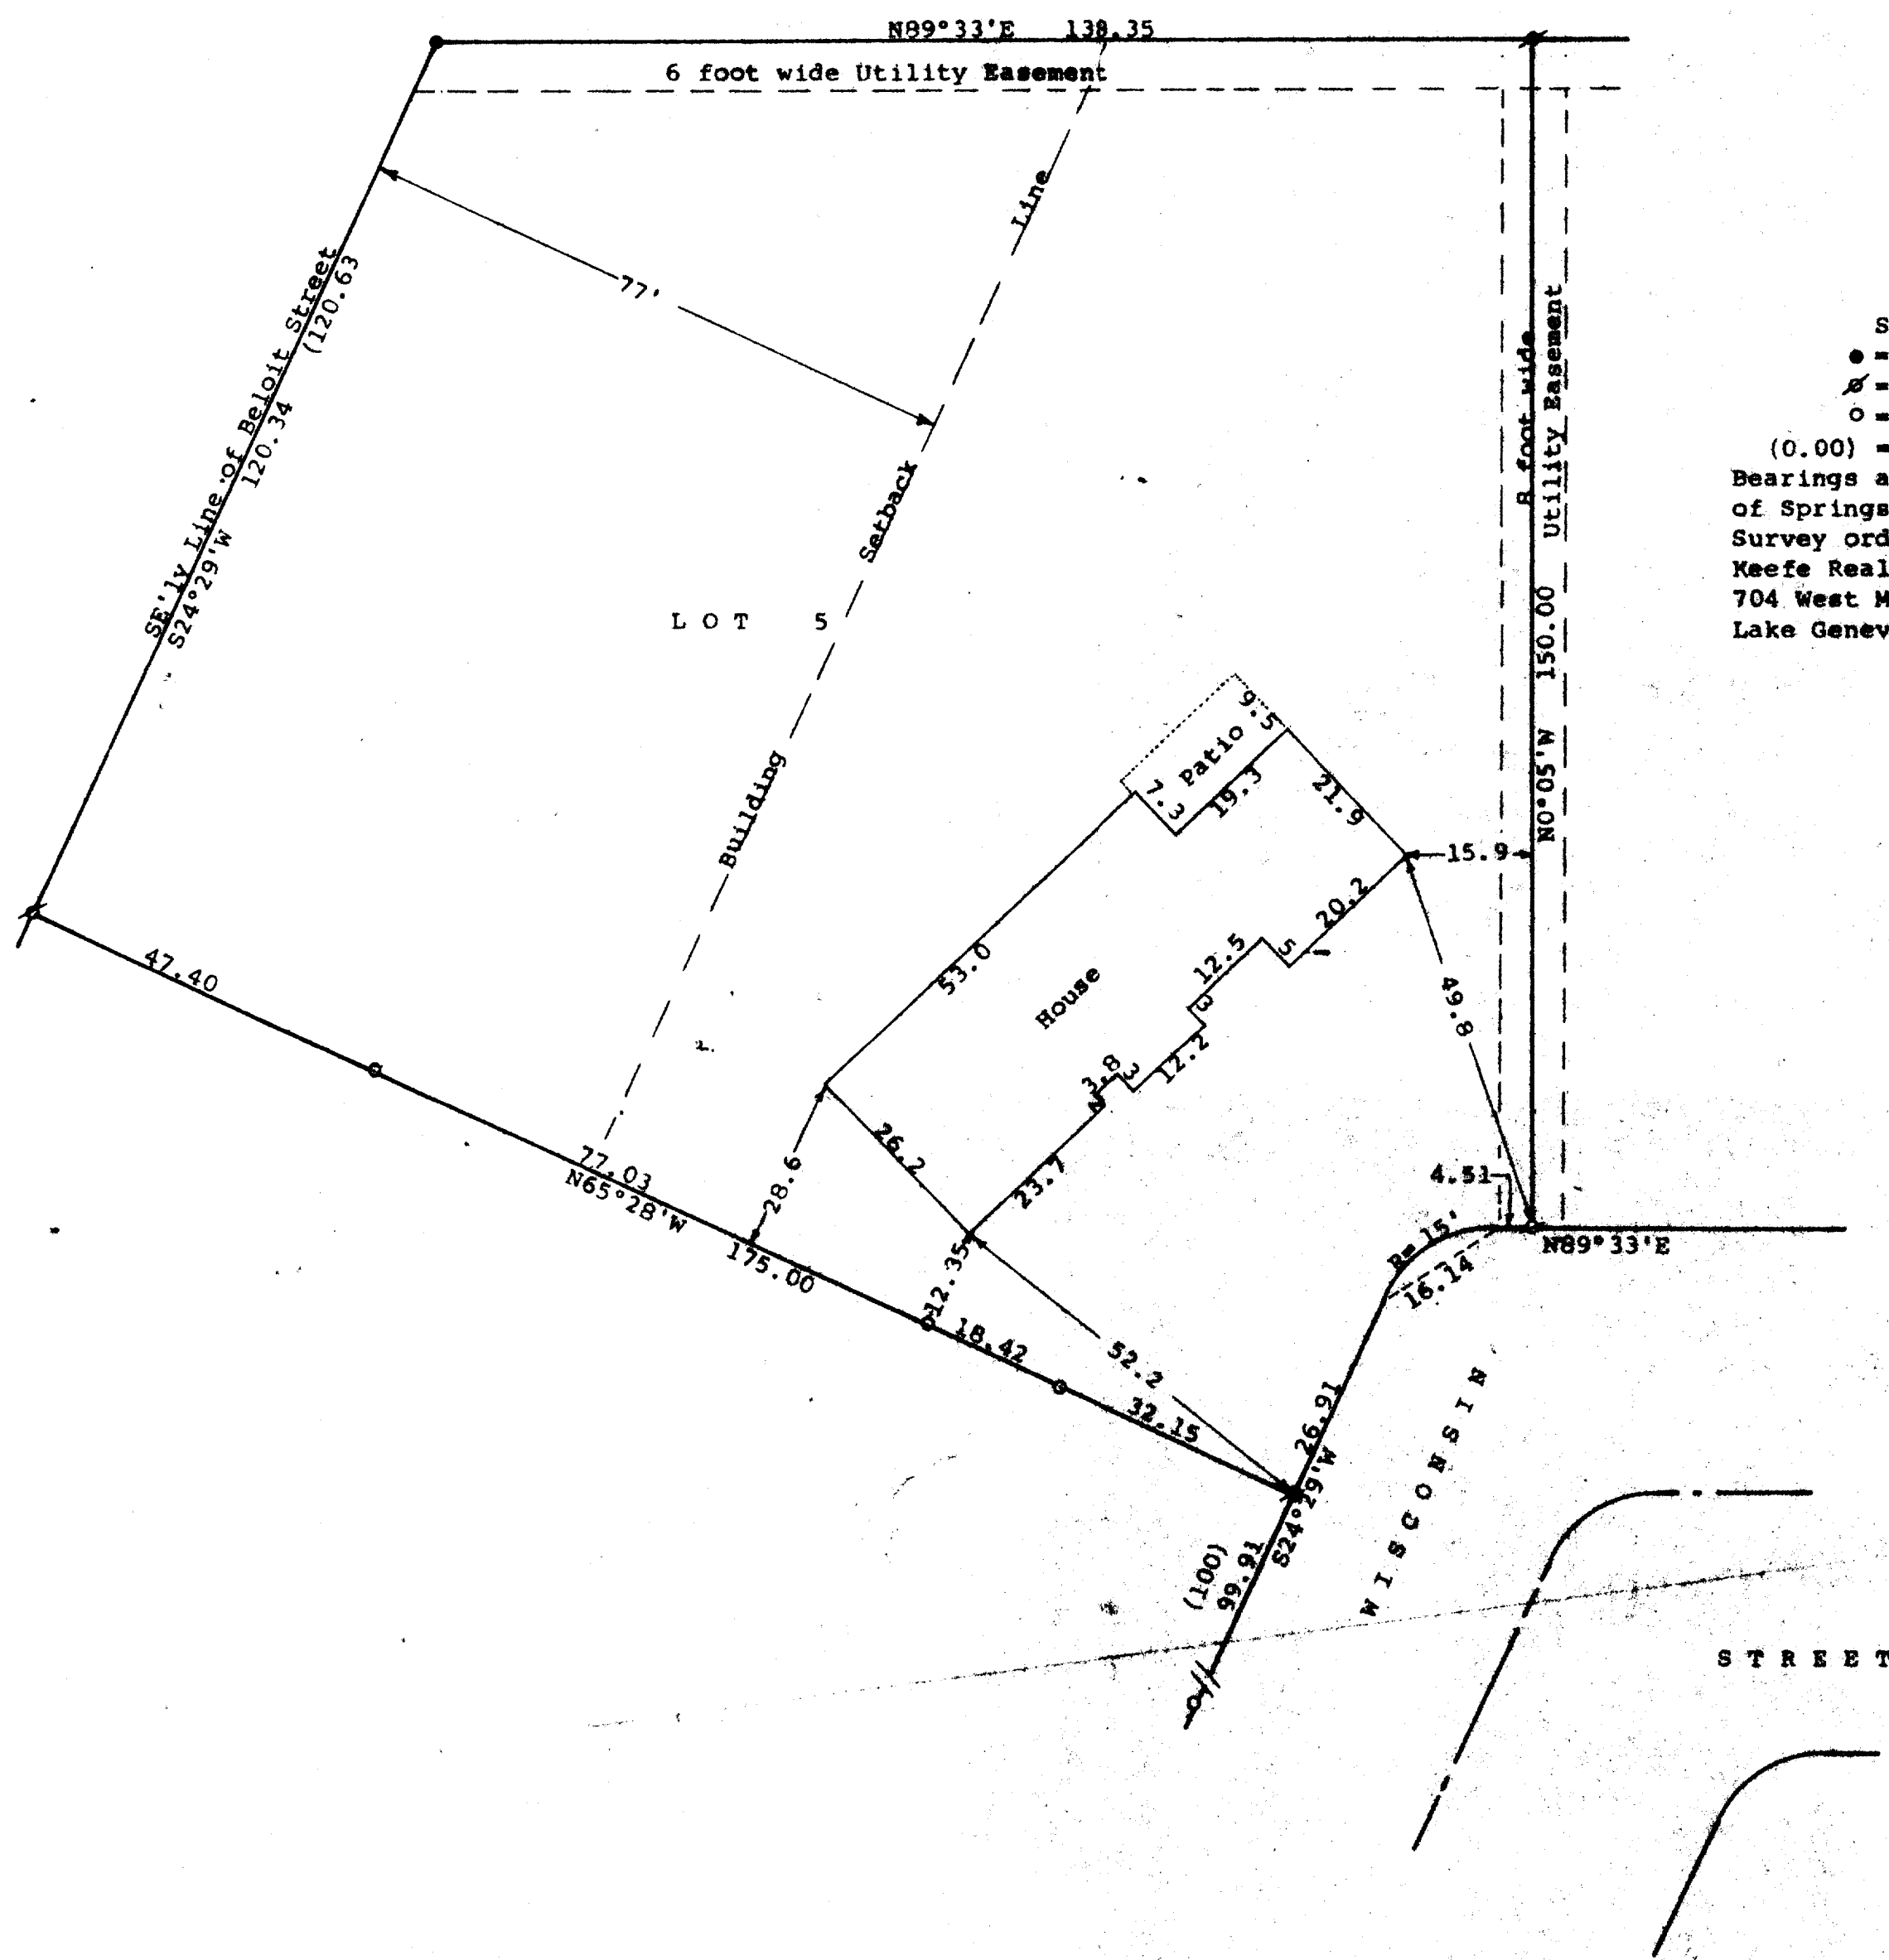

N

Scale - 1" = 20'

● = Concrete Monument Found

⊗ = 1" Iron Pipe Found

○ = 1/2" Iron Pipe Set

(0.00) = recorded distance

Bearings are those on the recorded plat of Springs Park Subdivision Addition No. 1

Survey ordered by:

Keefe Real Estate Inc.

704 West Main Street

Lake Geneva, WI 53147

STATE OF WISCONSIN) ss
COUNTY OF WALWORTH)



I, George T. Dunham, Surveyor, certify that I have surveyed the property described as follows:

Lot 5 in Block 4 of Springs Park Subdivision Addition No. 1, located in the City of Delavan, Walworth County, Wisconsin.

and that the plat shown hereon is a correct representation thereof and shows the size and location of the property, its exterior boundaries, the location of all visible structures and dimensions of all principal buildings thereon, boundary fences, apparent easements, roadways and visible encroachments, if any, and that I have surveyed the property hereon described, according to the official records, to the best of my knowledge and belief.

November 8, 1995

George T. Dunham
George T. Dunham, Surveyor

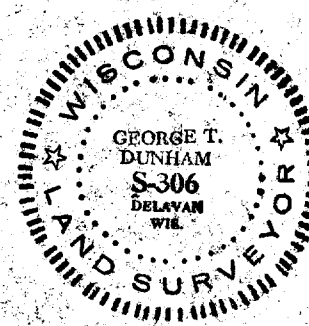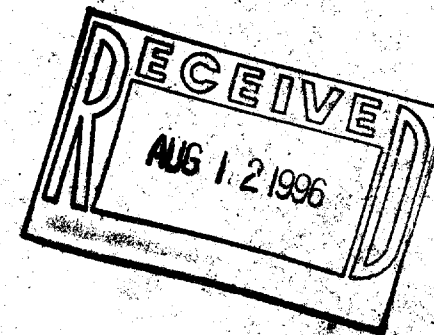

XSPS1-4

602-1518