


FARRIS, HANSEN & ASSOCIATES, INC.
 ENGINEERING, ARCHITECTURE, SURVEYING
 7 RIDGWAY COURT - P.O.BOX 437, ELKHORN, WISCONSIN 53121
 PHONE: (414) 723-2098 FAX: (414) 723-5886

PLAT OF SURVEY
 LOT 1 BLOCK 2
 CHESTNUT RIDGE SUBDIVISION WEST
 LOCATED IN EAST 1/2 OF THE SW 1/4 OF SEC. 13
 TOWN 2 NORTH, RANGE 15 EAST, CITY OF DELAVAN
 WALWORTH COUNTY, WISCONSIN

WHISPERING PINES DRIVE

- - SET IRON REBAR STAKE
- - FOUND IRON REBAR STAKE
- (x) - RECORDED AS

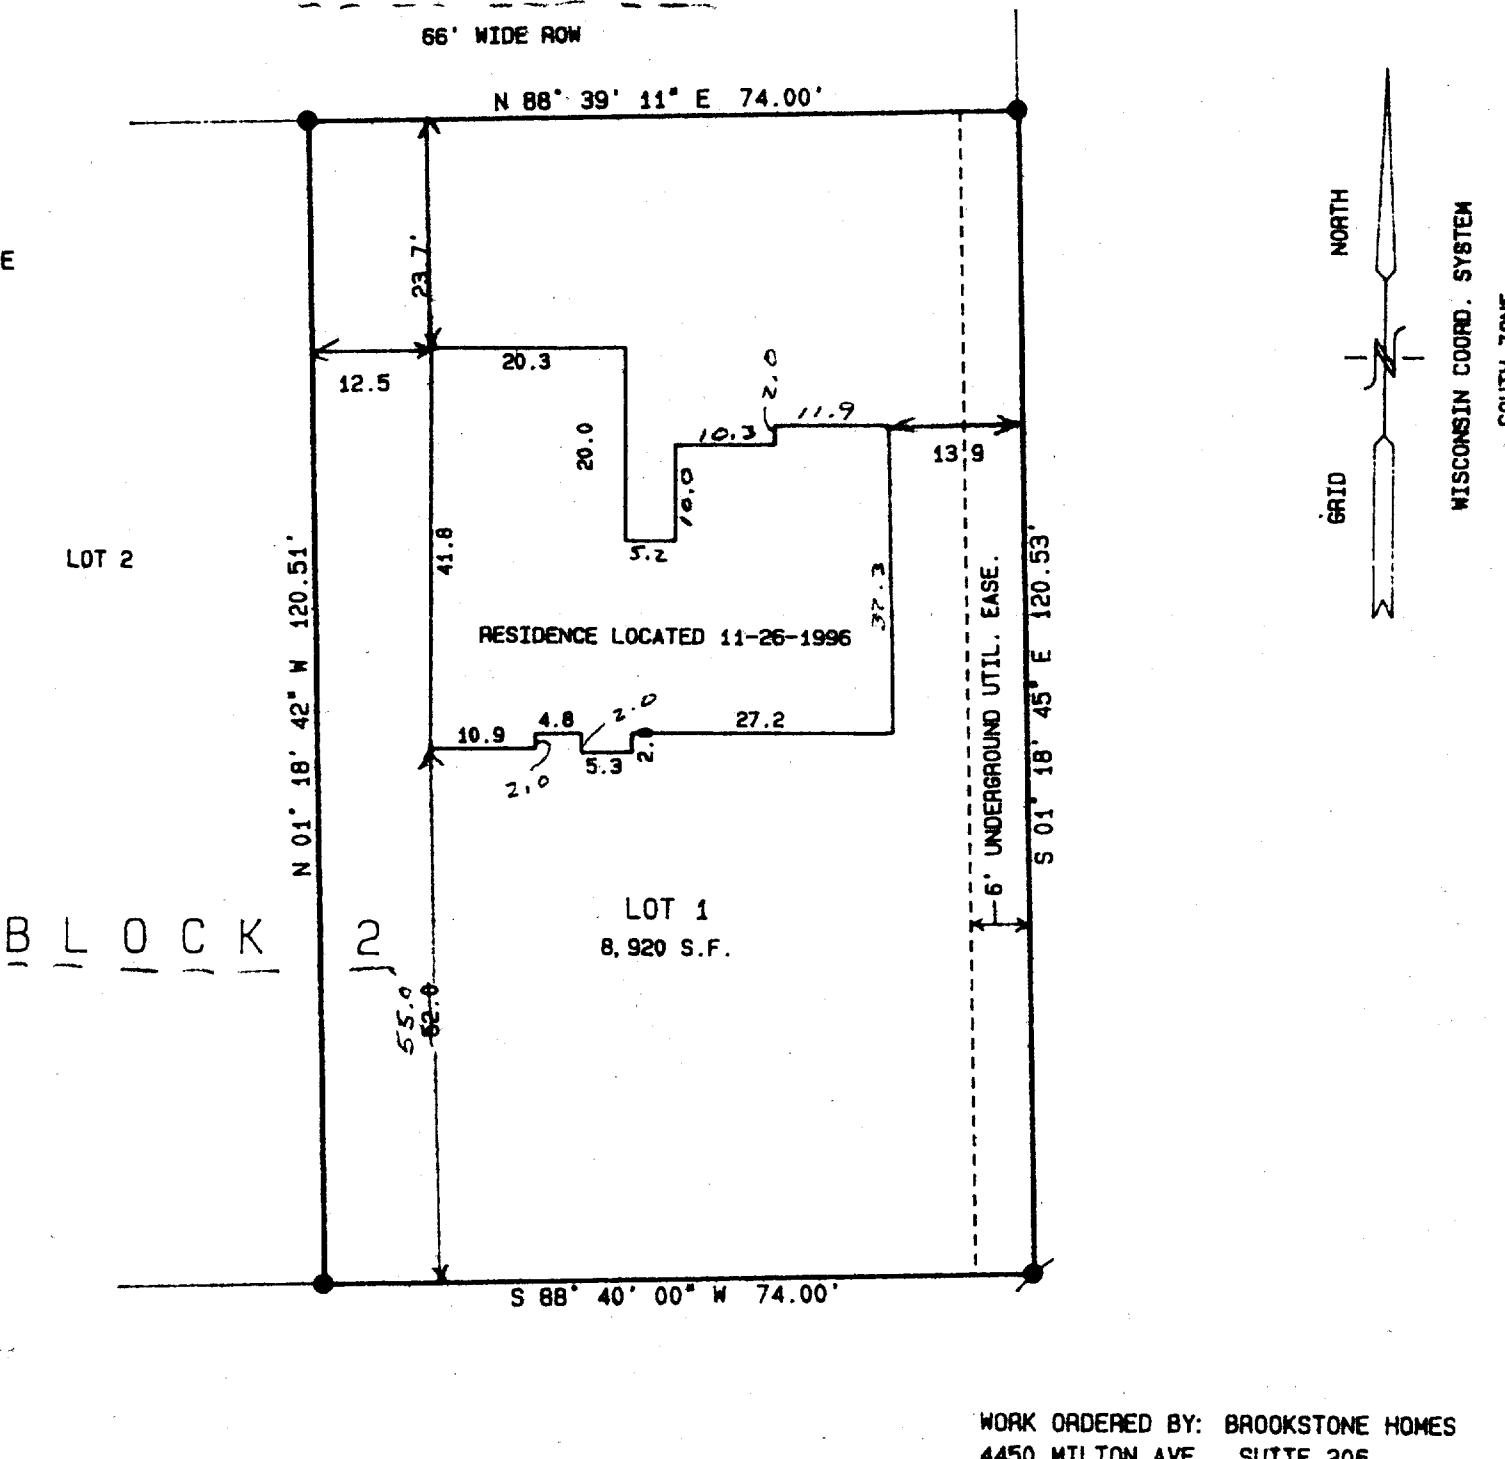

WORK ORDERED BY: BROOKSTONE HOMES
 4450 MILTON AVE., SUITE 206
 JANEVILLE, WISCONSIN 53546


NOTE: COPIES OF THIS MAP TO WHICH THE FOLLOWING CERTIFICATE WILL APPLY ARE BLUE LINE PRINTS SHOWING SURVEYOR'S ORIGINAL SEAL AND SIGNATURE IN BLACK INK. COPIES BY ANY OTHER MEANS MAY HAVE ALTERATIONS WHICH DO NOT REPRESENT THE SURVEYOR'S WORK PRODUCT.

I HEREBY CERTIFY THAT THE ABOVE DESCRIBED PROPERTY HAS BEEN SURVEYED UNDER MY DIRECTION AND THAT THE ABOVE MAP IS A TRUE REPRESENTATION THEREOF AND SHOWS THE SIZE AND LOCATION OF THE PROPERTY AND ITS EXTERIOR BOUNDARIES. THIS SURVEY IS MADE FOR THE USE OF THE PRESENT OWNERS OF THE PROPERTY, AND ALSO THOSE WHO PURCHASE, MORTGAGE, OR GUARANTEE THE TITLE THERETO WITHIN ONE YEAR FROM THE DATE HEREOP.

DATED: 7-17-96

REVISED 11-26-96 TO SHOW SIZE & LOCATION OF RESIDENCE AS BUILT

Peter S. Gordon
 PETER S. GORDON S.L.S. 2101

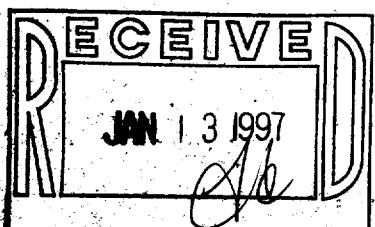

PROJ 3690.01.2

002-1577
 XCRW-8