


PLAT OF SURVEY

LOT 33 OF WHISPERING PINES SUBDIVISION,
LOCATED IN SECTION 13, TOWN 2 NORTH, RANGE 15
EAST, CITY OF DELAVAN, WALWORTH COUNTY,
WISCONSIN.


OWNER: TOM AND MIKE McDONOUGH
N3445 COMO RD.
LAKE GENEVA, WI. 53147

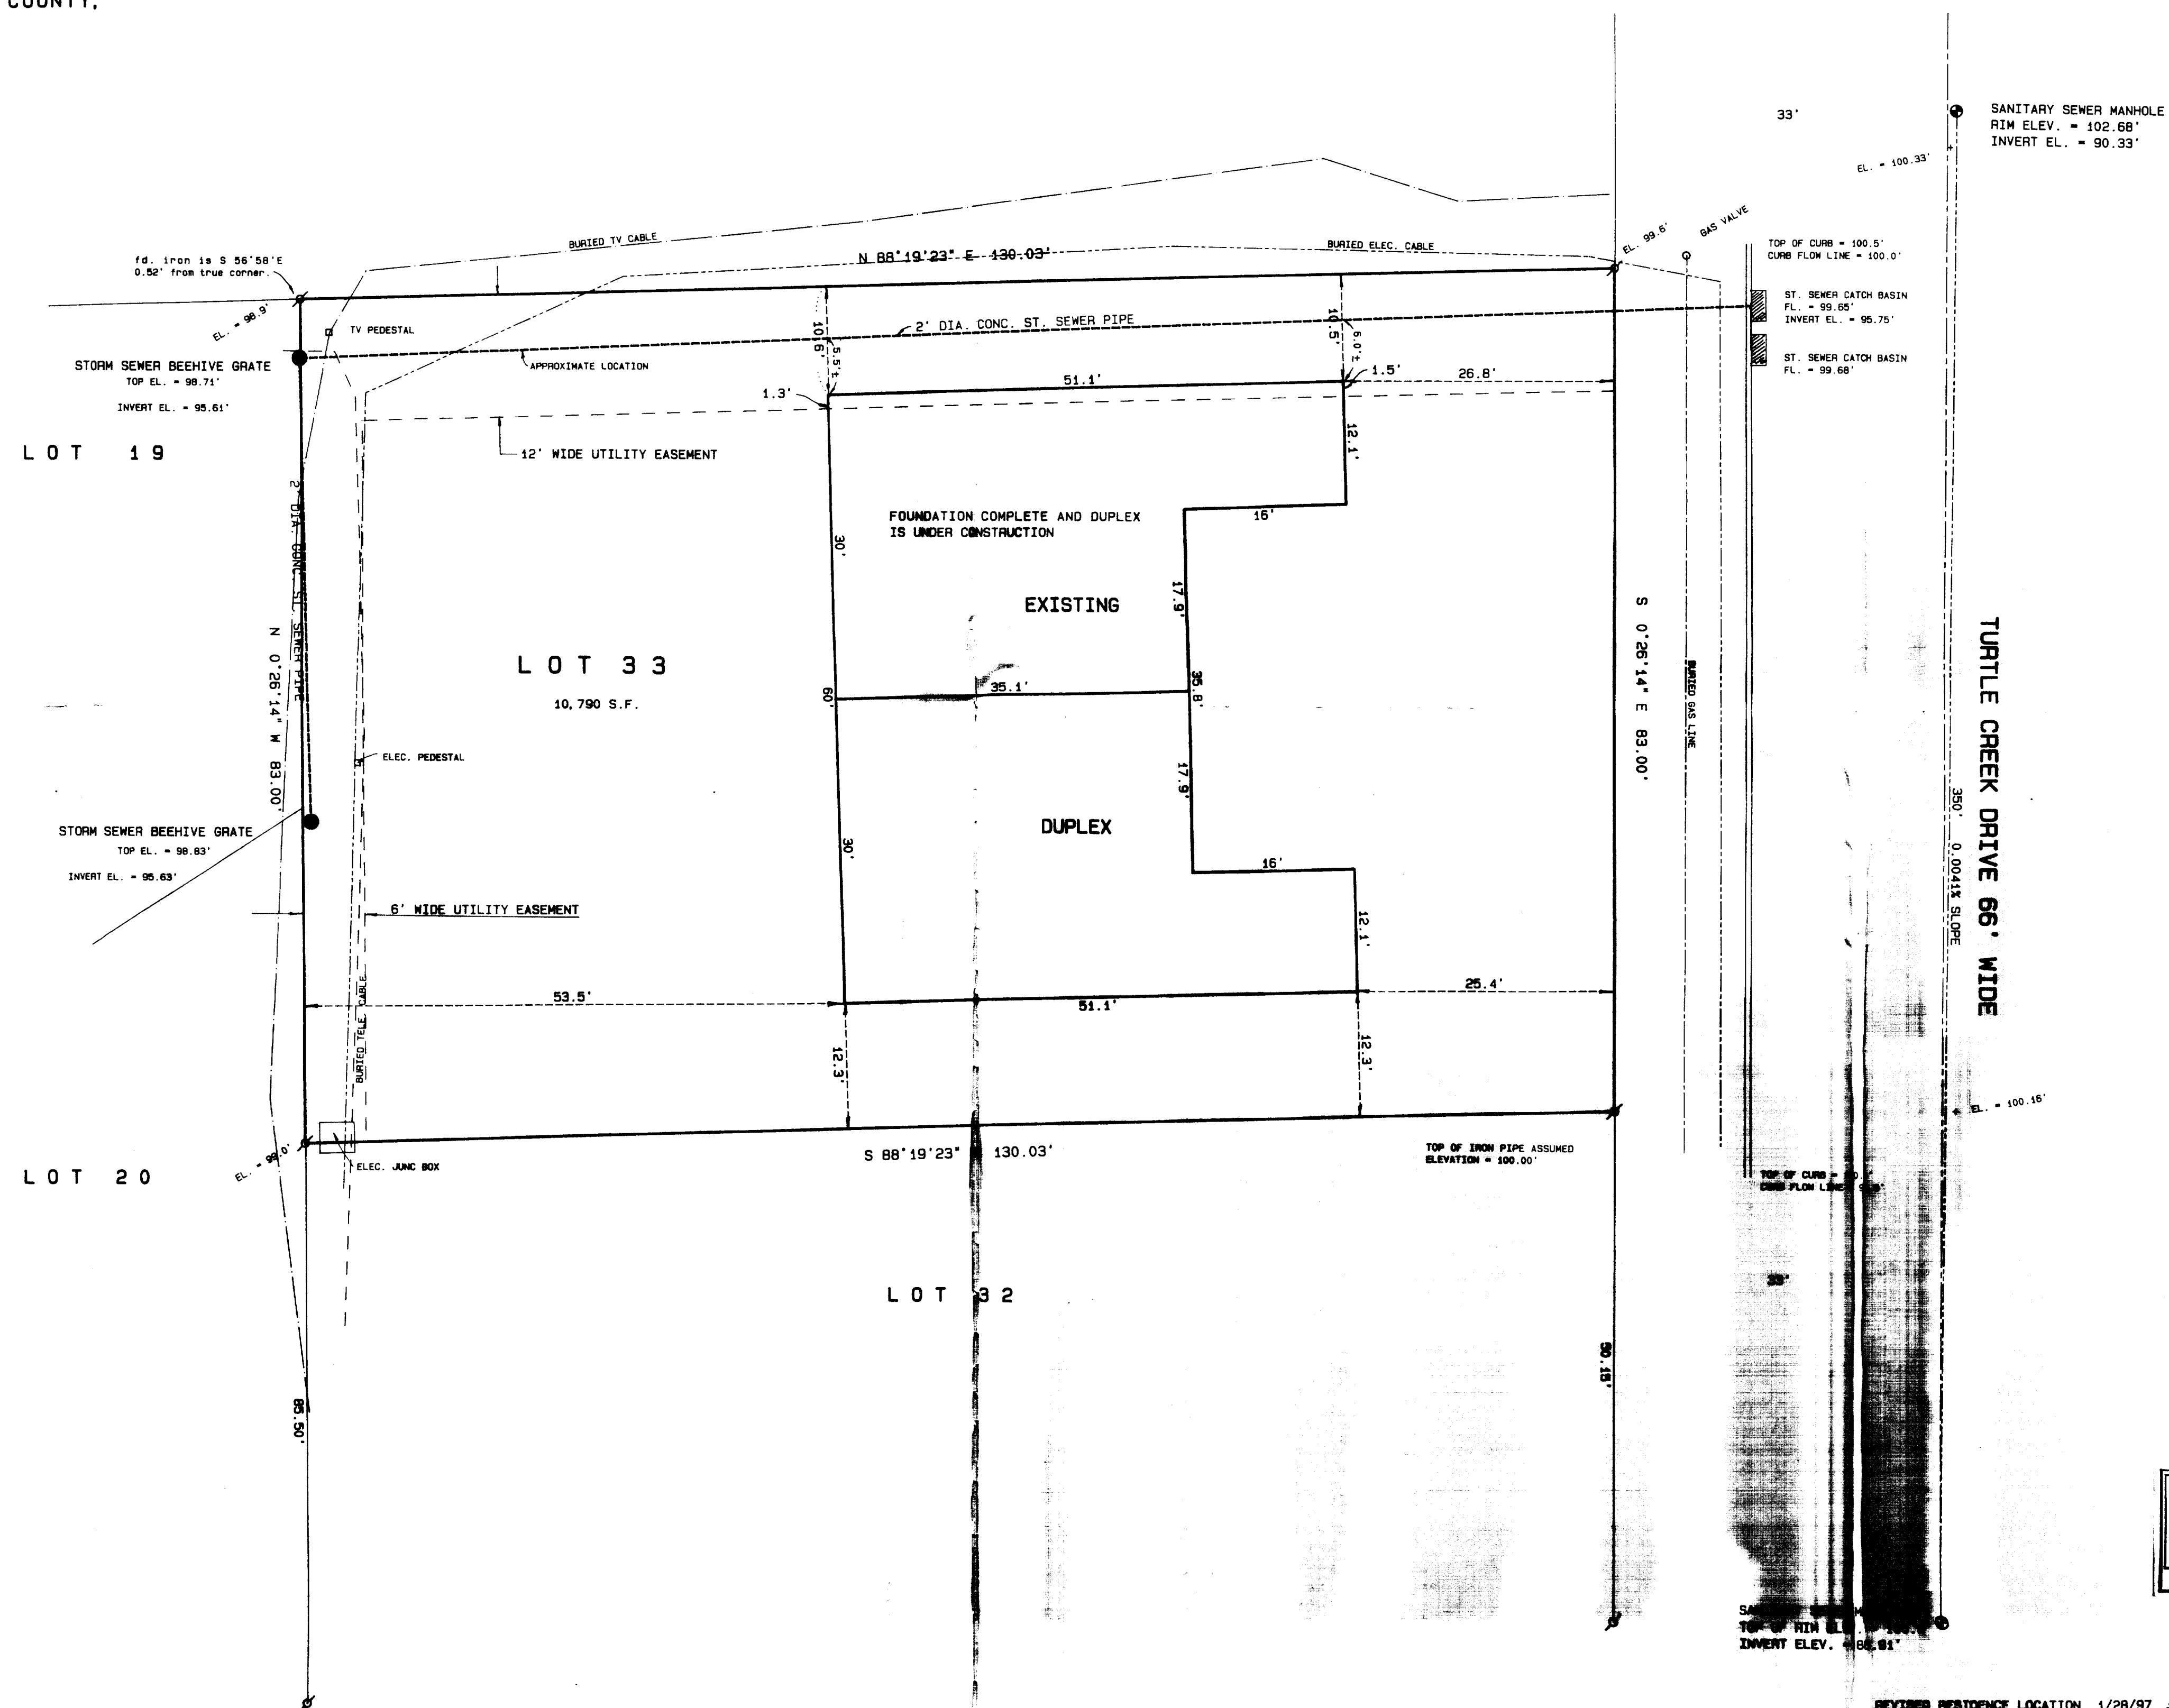

SCALE 1" = 10 FEET

Legend


- ✂ FOUND IRON PIPE
 - ✂ FOUND IRON ROD
 - ☐ FOUND BRASS CAPPED MONUMENT
 - FOUND CONCRETE MONUMENT
 - ✚ CHISEL CUT IN CONCRETE
 - SET IRON ROD, 24" LONG, WEIGHING 1.3 LBS./LINEAL FT., 3/4" DIA.
 - SET IRON ROD, 30" LONG, WEIGHING 4.5 LBS./LINEAL FT., 1-11/16" DIA.
- (xx) RECORDED AS DIMENSION
- x — EXISTING FENCE

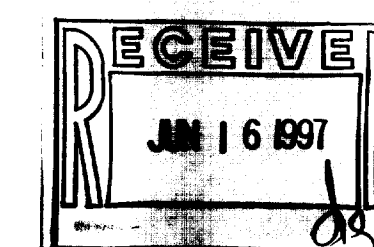

SCALE: 1"= 10 FEET

REVISED RESIDENCE LOCATION 1/28/97

AS BUILT LOCATION 5/14/97

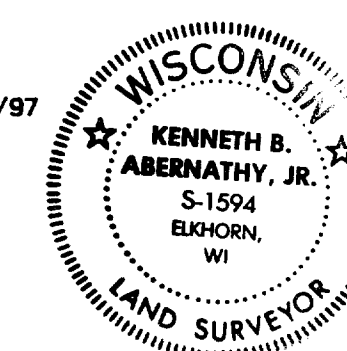

KENNETH B. ABERNATHY, JR.
WISCONSIN REGISTERED LAND SURVEYOR,
S-1594

Date: OCT. 23, 1996 Job No. 96.1002