


BLOCK

LOT 23

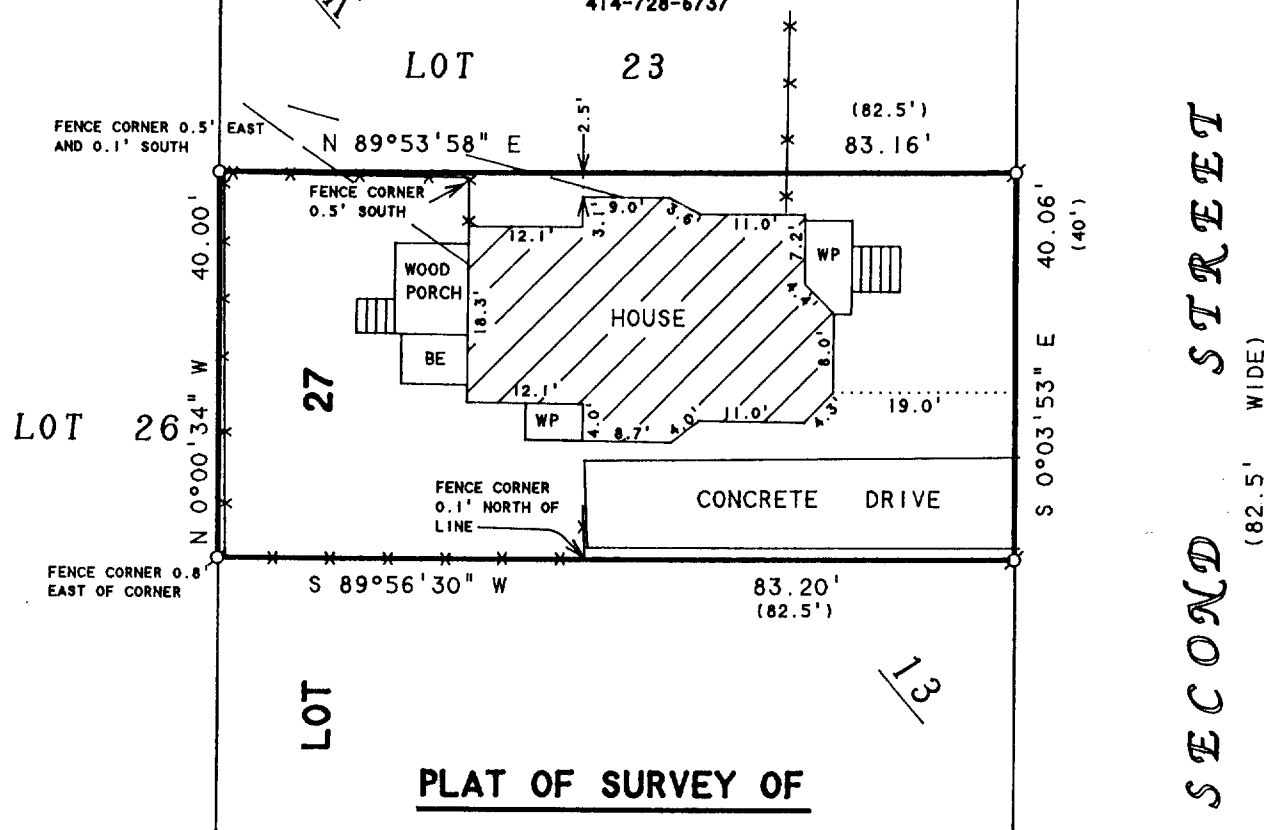


Tax Key No. XOP 00144

ORDERED BY: RE/MAX-LAKES AREA REALTORS
1815 N. SHORE DRIVE
DELAVER, WI. 53115



LEGEND

- — — OVERHEAD WIRES

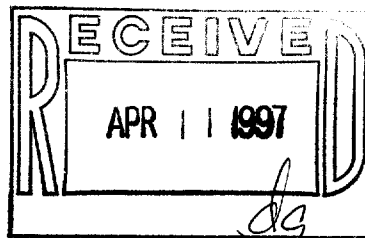

FROM DATE HEREON.

Daniel F. Bell

February 26, 1997

DATE _____ JOB NUMBER - 97028
NOTE: THIS IS NOT A CERTIFIED COPY UNLESS SEALED.

002-1598

XOP-144