

FH


SURVEY W/ IMPROVEMENTS
1303 BIRCHWOOD STREET
DELAVER, WISCONSIN

**BROOKSTONE HOMES
4450 MILTON AVENUE
SUITE 206
JANSEVILLE, WISCONSIN 53456**

Engineering, Architecture, Surveying
7 Ridgway Court P.O. Box 437
ELKHORN, WISCONSIN 53121
Office: (414) 723-2098
Fax: (414) 723-5886

VISIONS

PROJECT NO.	3690.23
DATE:	10/02/97
SHEET NO.	1 OF 1

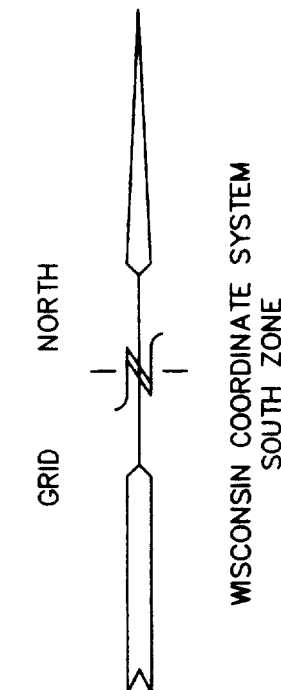


RECEIVED
NOV 7 1997


I HEREBY CERTIFY THAT THE ABOVE DESCRIBED PROPERTY HAS BEEN SURVEYED UNDER MY DIRECTION AND THAT THE ABOVE MAP IS A TRUE REPRESENTATION THEREOF AND SHOWS THE SIZE AND LOCATION OF THE PROPERTY AND ITS EXTERIOR BOUNDARIES. THIS SURVEY IS MADE FOR THE USE OF THE PRESENT OWNERS OF THE PROPERTY, AND ALSO THOSE WHO PURCHASE, MORTGAGE, OR GUARANTEE THE TITLE THERETO WITHIN ONE YEAR FROM THE DATE HEREOF.

DATED: OCT. 2, 1997


PETER S. GORDON R.L.S. 2101

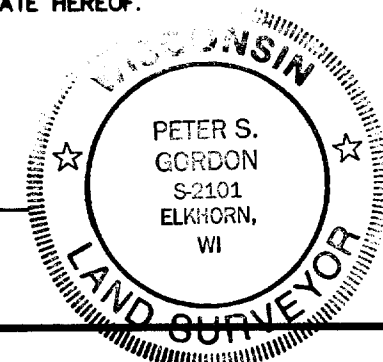

⊙ - FOUND IRON REBAR STAKE
 ● - SET IRON REBAR STAKE
 () - RECORDED AS

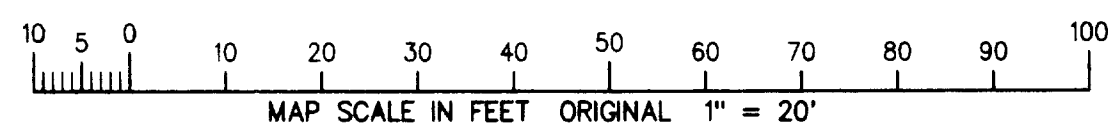

002-1663

XCR-23