


DUNHAM & RASMUSSEN
SURVEYING & ENGINEERING
DELAVER, WISCONSIN

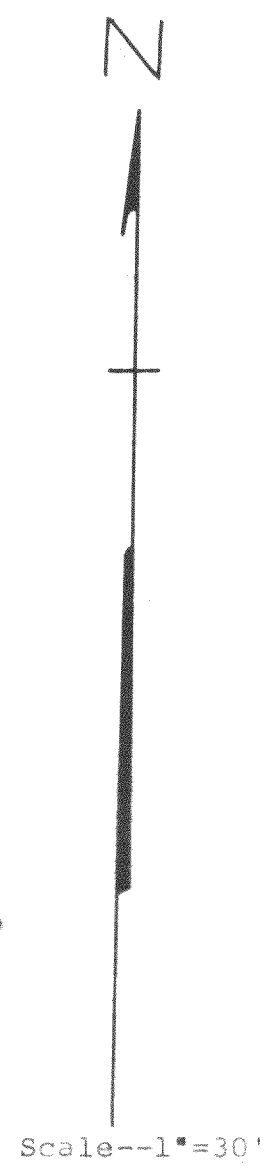

STATE OF WISCONSIN)
WALWORTH COUNTY)SS

I, George T. Dunham, do hereby certify that I have surveyed the property described as follows,:

Lots 1 and 2 and the East 74.50 feet of Lot 3 in Block 1 of Passage, Aram, and Downie Addition to the City of Delavan, Walworth County, Wisconsin

and that the plat shown above is a correct representation of the property lines and of the improvements located thereon.
September 11, 1961

George T. Dunham
George T. Dunham, Surveyor