


N
 SCALE 1"=20'
 O=IRON PIPE
 ●=CONC. MONU.

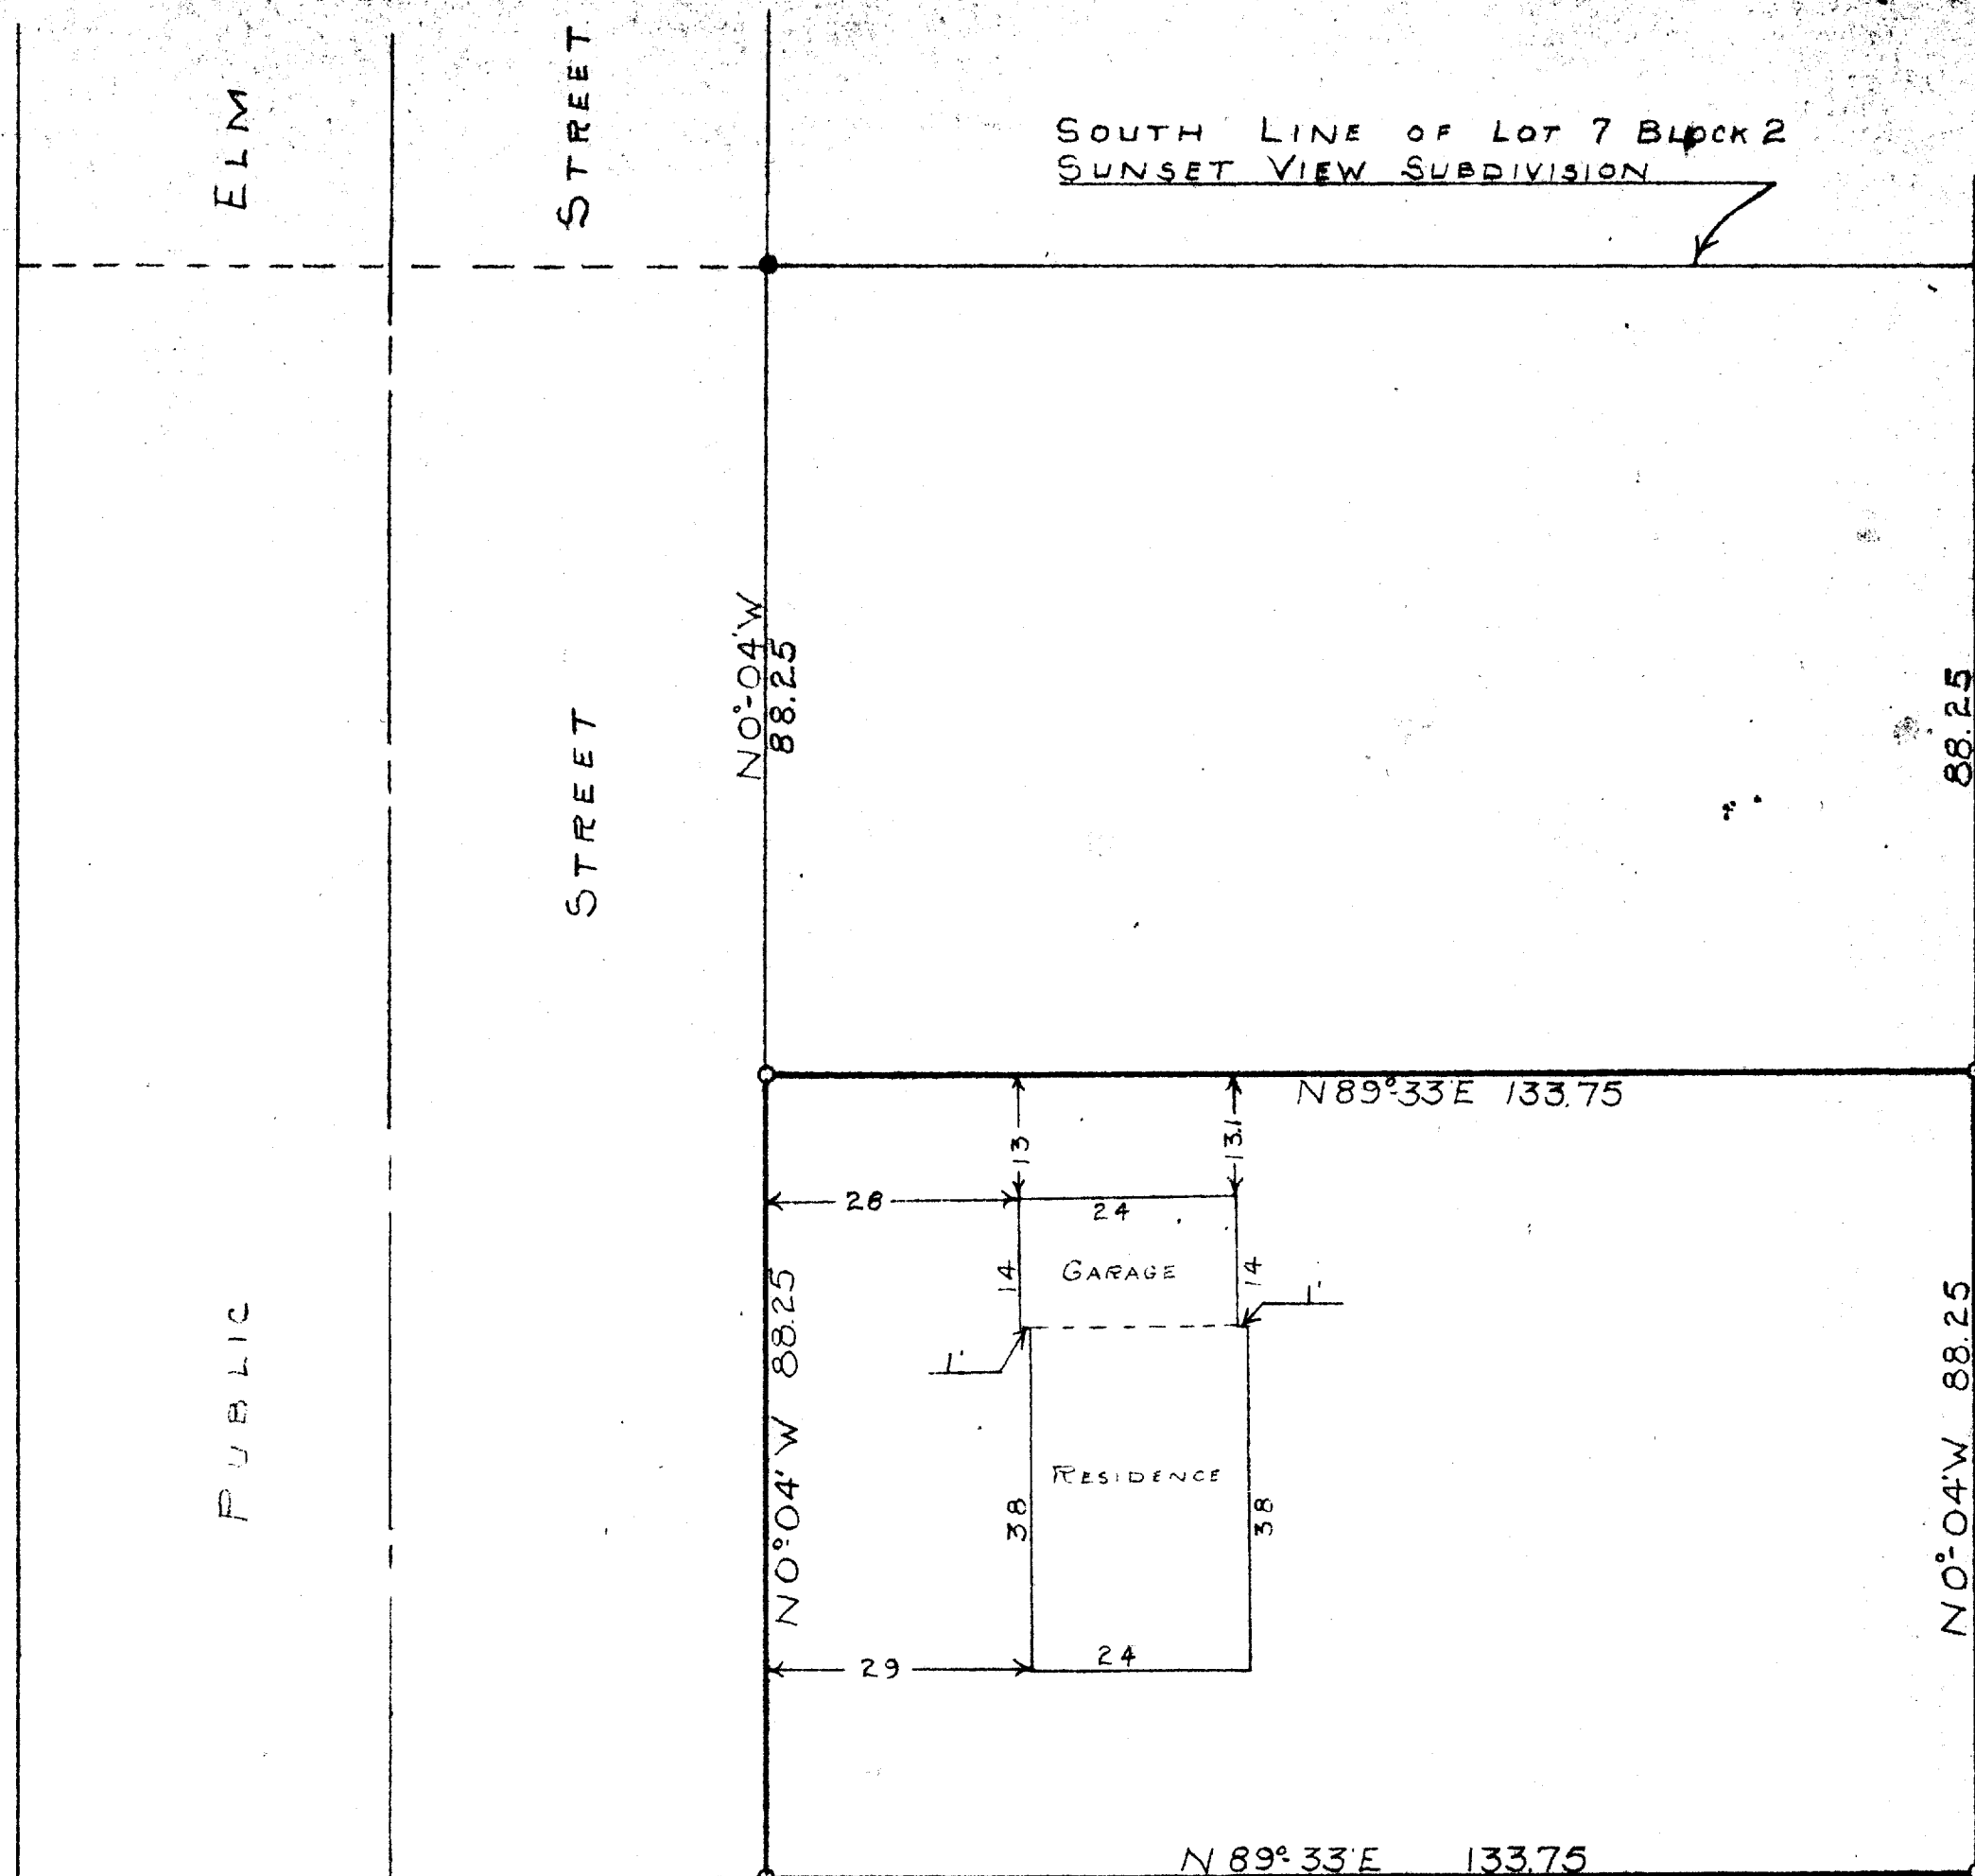

STATE OF WISCONSIN,
 COUNTY OF WALWORTH, ss

I, GEORGE T. DUNHAM, DO HEREBY CERTIFY THAT I HAVE SURVEYED THE
 PROPERTY DESCRIBED AS FOLLOWS:

A PARCEL OF LAND LOCATED IN THE SW 1/4 OF SECTION 18, T2N R16E, CITY
 OF DELAVAN, WALWORTH COUNTY, WISCONSIN, DESCRIBED AS FOLLOWS, TO-WIT:
 COMMENCING AT THE SW CORNER OF LOT 7, BLOCK 2 IN SUNSET VIEW
 SUBDIVISION; THENCE S 0° 04' E ON THE EAST LINE OF ELM STREET PRODUCED
 SOUTH 88.25 FEET TO THE PLACE OF BEGINNING; THENCE N 89° 33' E PARALLEL
 WITH THE SOUTH LINE OF SAID LOT 7, 133.75 FEET TO A POINT; THENCE
 S 0° 04' E 88.25 FEET TO A POINT; THENCE S 89° 33' W 133.75 FEET TO THE EAST
 LINE OF ELM STREET PRODUCED SOUTH, THENCE N 0° 04' W 88.25 FEET TO
 THE PLACE OF BEGINNING.

AND THAT THE PLAT SHOWN ABOVE IS A CORRECT REPRESENTATION OF THE
 PROPERTY LINES.
 JUNE 27, 1953

George T. Dunham
 GEORGE T. DUNHAM
 DELAVAN, WISCONSIN
 SURVEYOR