

GEORGE T. DUNHAM

SURVEYING & SUBDIVIDING
DELAVER, WISCONSIN

WISCONSIN


66.00

STREET

STREET

82.50

SEVENTH

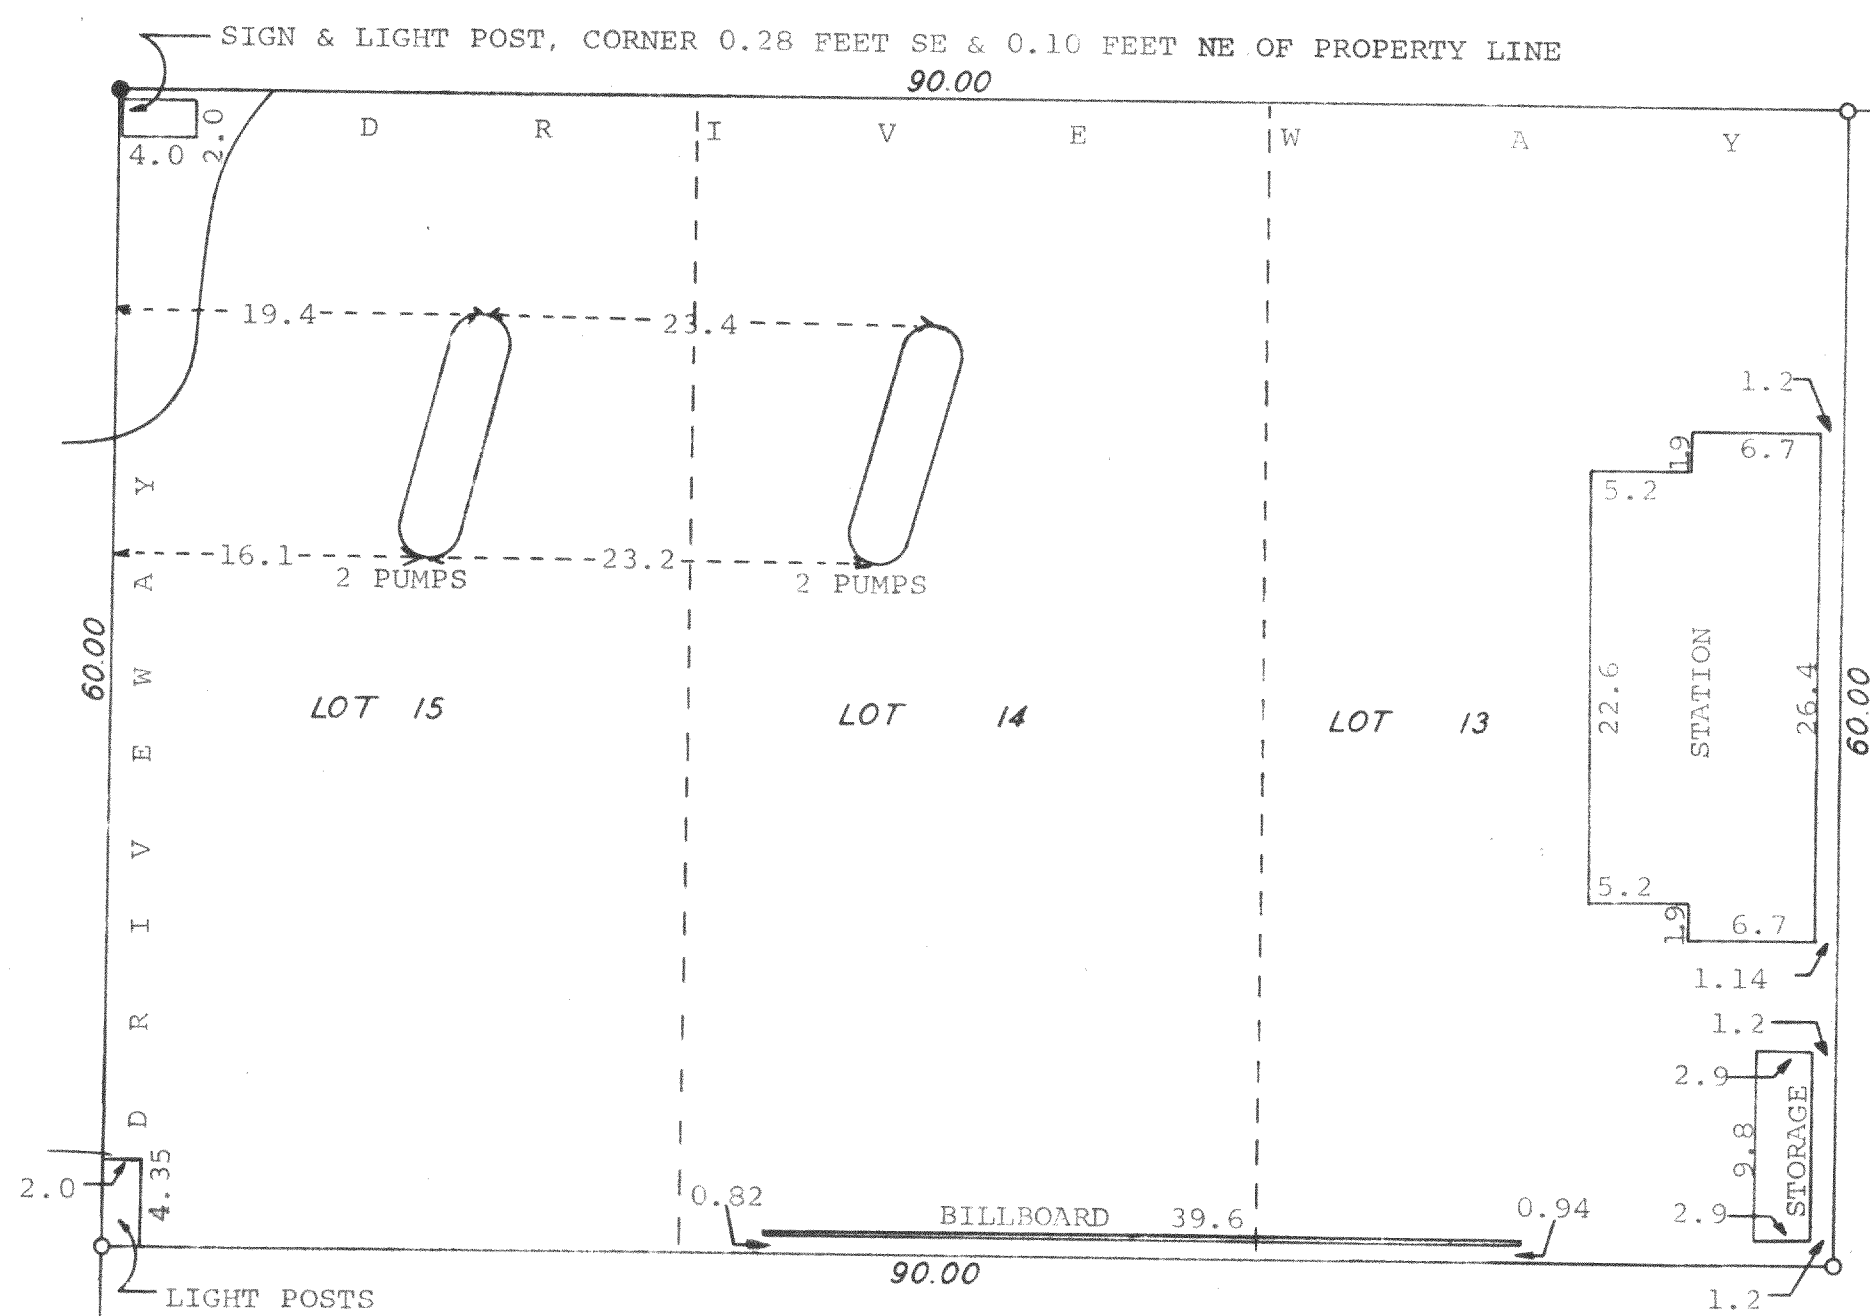

STATE OF WISCONSIN)
COUNTY OF WALWORTH)^{SS}

I, George T. Dunham, Surveyor, do certify that I have surveyed the property described as follows:

Lots 13, 14, and 15, Block 15, Passage, Aram, & Downie Addition, City of Delaver, Walworth County, Wisconsin.

and that the above plat is an accurate survey and a true representation thereof and correctly shows the exterior boundary lines and location of buildings and other improvements on said property and the correct measurements thereof.
July 18, 1962

George T. Dunham
George T. Dunham, Surveyor

Scale - 1" = 10'
○ = Iron Pipe
● = Iron Rod in Concrete