


STREET

THIRD

BLOCK

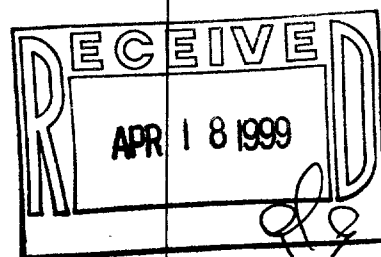


LOT 2

18

166.08'
SOUTH LINE LOT 2 (165')

TAX PARCEL
XOP-194
AREA 0.30 ACRES

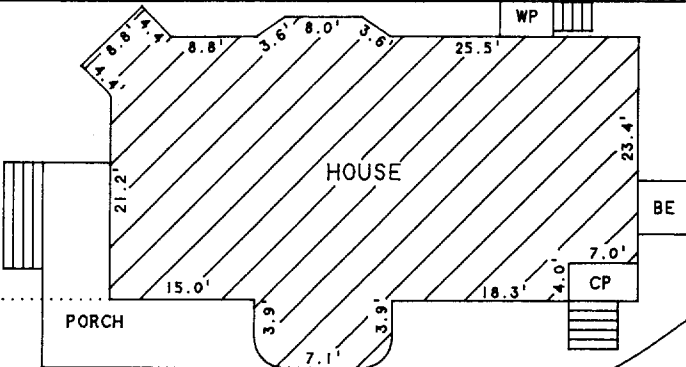

LOT 3

BLACKTOP DRIVE

BLACKTOP DRIVE

LOT 4

PLAT OF SURVEY OF

THE SOUTH 6 FEET OF LOT 2 AND ALL OF LOT 3, BLOCK 18,
ORIGINAL PLAT, CITY OF DELAVAN, WALWORTH COUNTY,
WISCONSIN.

ORDERED BY: RE/MAX-LAKES AREA REALTORS
1815 N. SHORE DRIVE
DELAVAN, WI. 53115



SCALE 1"=20'

LEGEND

- -IRON PIPE FOUND
- -CONCRETE MONUMENT FOUND
- △ -UTILITY POLE
- BE -BASEMENT ENTRY
- CP -CONCRETE PORCH
- WP -WOOD PORCH
- XX -CHAINLINK FENCE
- () -RECORDED AS

I HEREBY CERTIFY THAT I HAVE SURVEYED THE ABOVE DESCRIBED PROPERTY AND THAT THE ABOVE MAP IS A TRUE REPRESENTATION THEREOF AND SHOWS THE SIZE AND LOCATION OF THE PROPERTY, ITS EXTERIOR BOUNDARIES, THE LOCATION OF ALL VISIBLE STRUCTURES AND DIMENSIONS OF ALL PRINCIPAL BUILDINGS THEREON, BOUNDARY FENCES, APPARENT EASEMENTS, ROADWAYS AND VISIBLE ENCROACHMENTS, IF ANY, TO THE BEST OF MY KNOWLEDGE AND BELIEF.

THIS SURVEY IS MADE FOR THE USE OF THE PRESENT OWNERS OF THE PROPERTY, AND ALSO THOSE WHO PURCHASE, MORTGAGE, OR GUARANTEE THE TITLE THERETO WITHIN ONE (1) YEAR FROM DATE HEREON.

David F. Abell

DAVID F. ABELL
WISCONSIN REGISTERED LAND SURVEYOR, S-1596

December 23, 1998

DATE JOB NUMBER - 98231
NOTE: THIS IS NOT A CERTIFIED COPY UNLESS SEALED.

XOP-194
002-17666