


GEORGE T. DUNHAM
SURVEYING & SUBDIVIDING
DELAVER, WISCONSIN

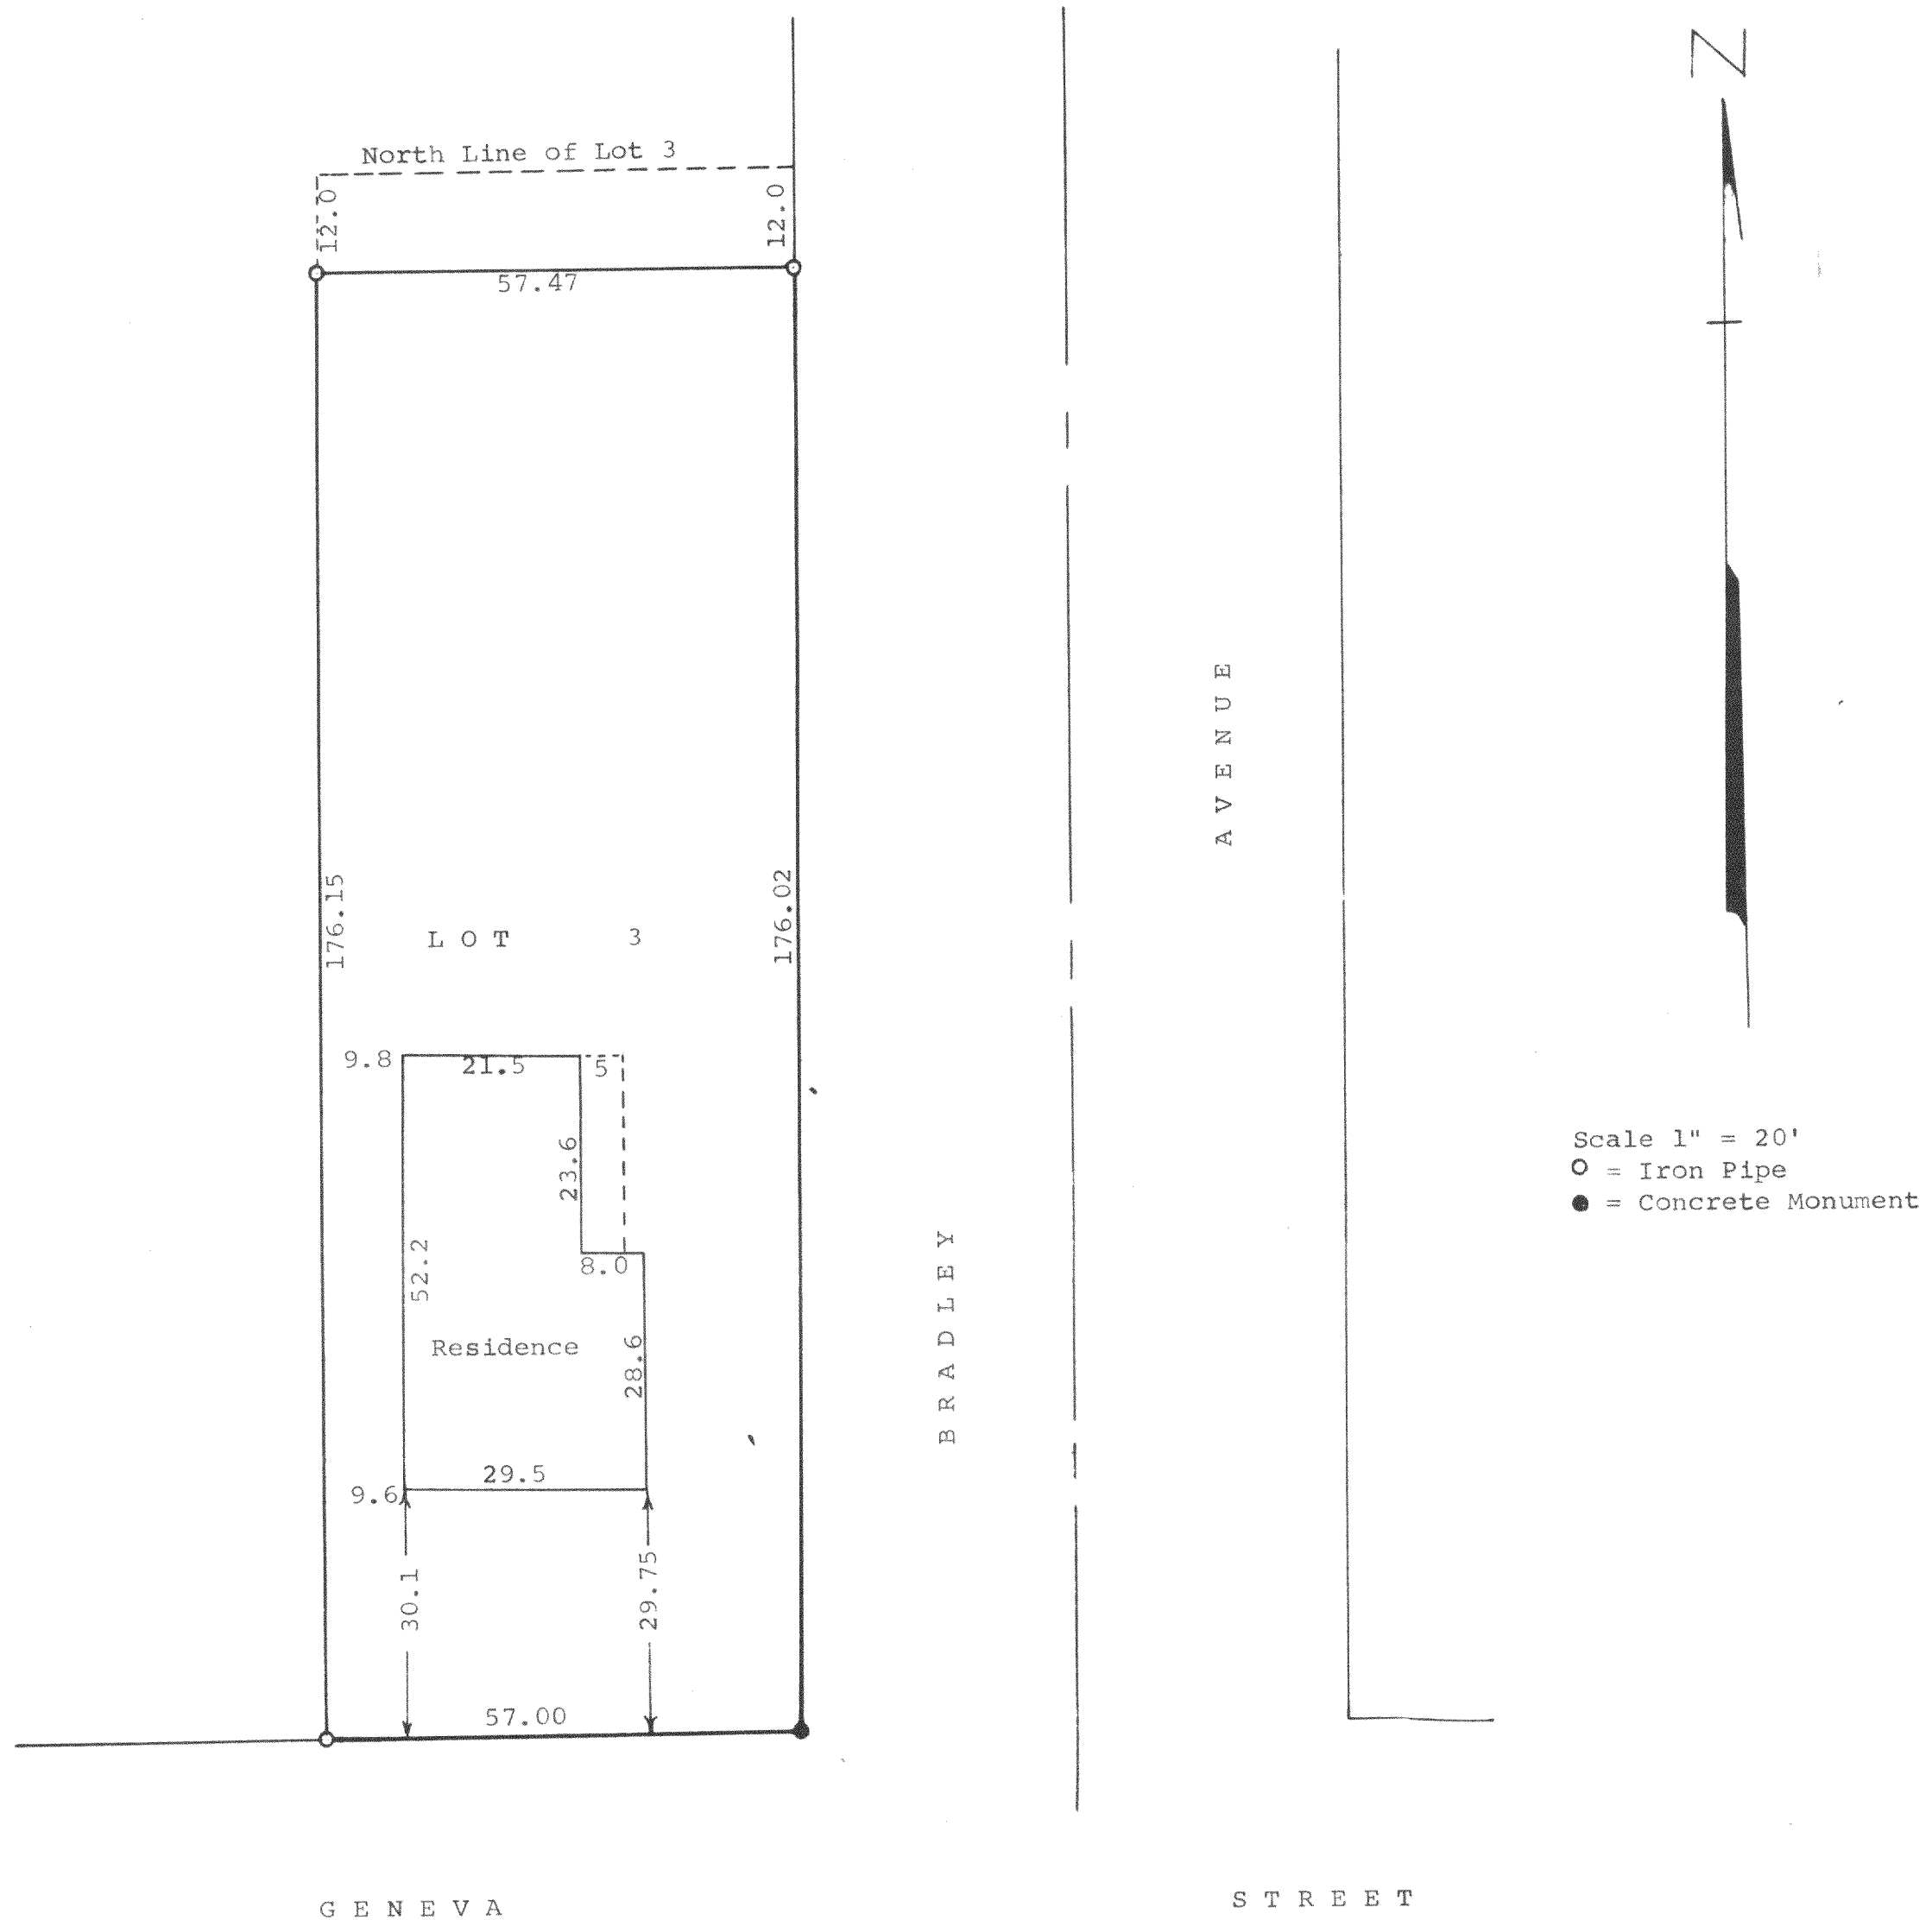

STATE OF WISCONSIN)
WALWORTH COUNTY)SS

I, George T. Dunham, do hereby certify that I have surveyed the property described as follows,
Lot 3, except the North 12 feet thereof, of Tyrrell Subdivision, an addition to the City of Delavan Walworth County, Wisconsin,
and that the plat shown above is a correct representation of the property lines and of the improvements located thereon.
October 1, 1962

George T. Dunham
George T. Dunham, Surveyor