


LAUREL HEIGHTS
DRIVE

ABELL
SURVEYING & MAPPING
DELAVER, WISCONSIN 53115
414-728-6737

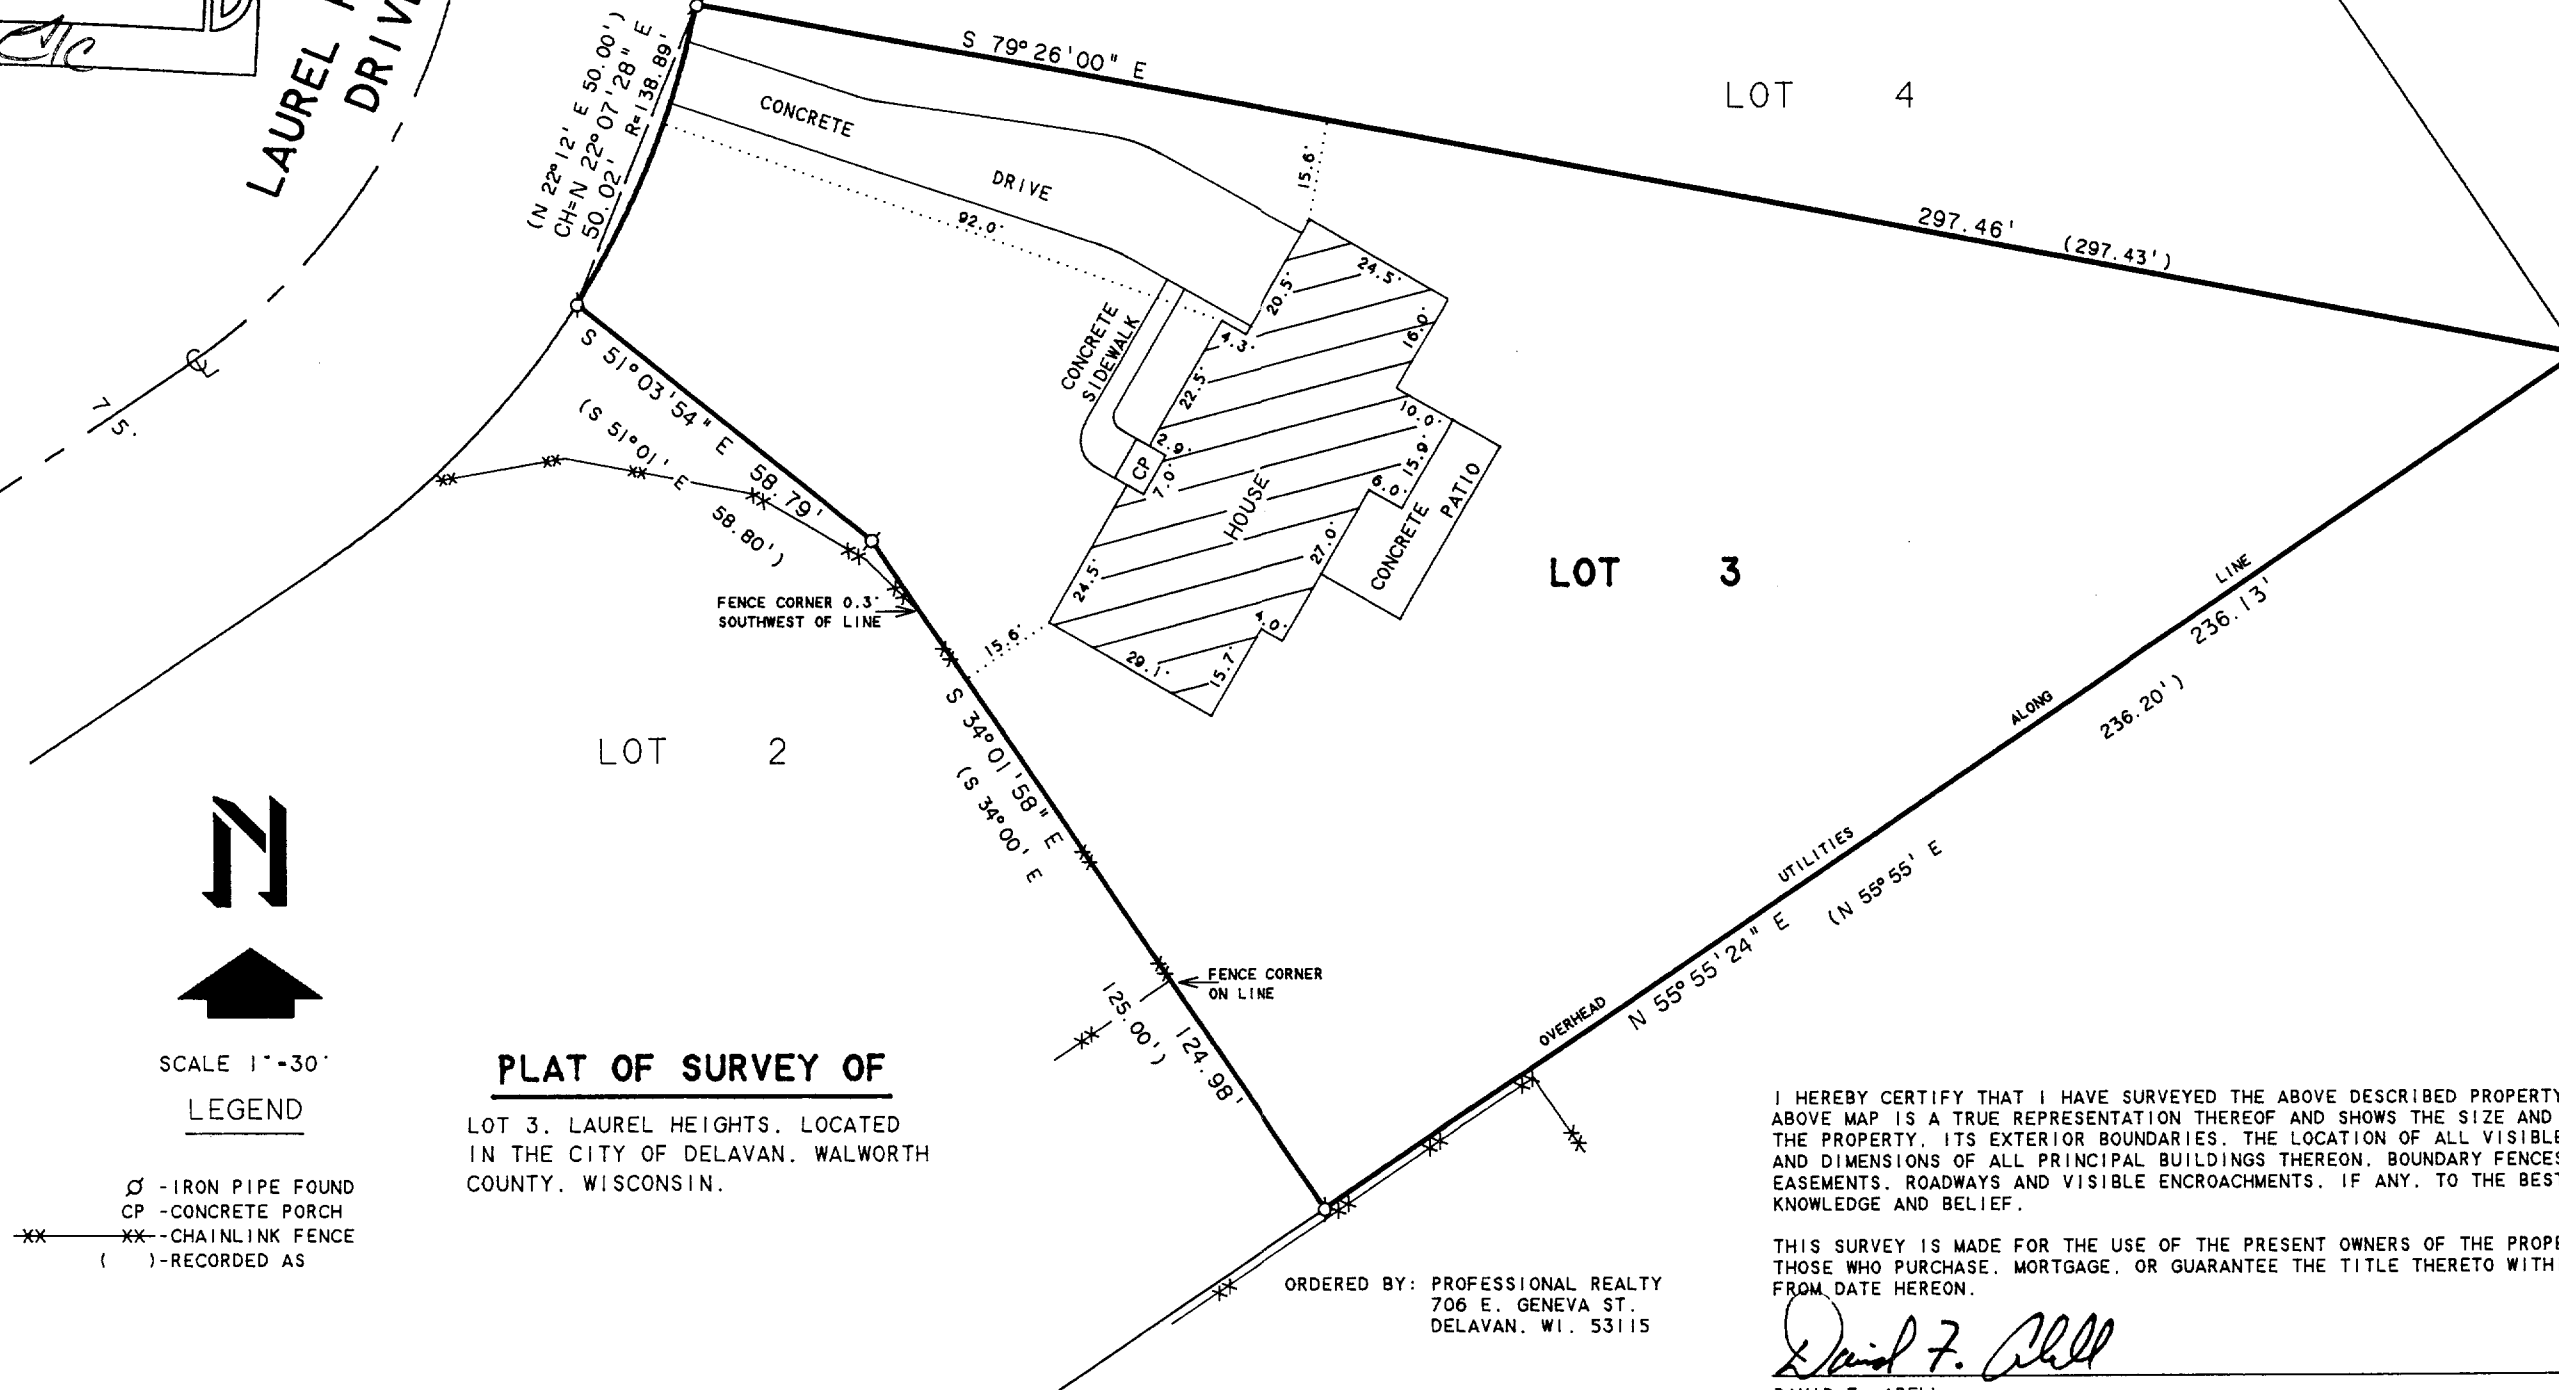

SCALE 1"=30'
LEGEND

Ø - IRON PIPE FOUND
CP - CONCRETE PORCH
XX - CHAINLINK FENCE
() - RECORDED AS

PLAT OF SURVEY OF
LOT 3, LAUREL HEIGHTS, LOCATED
IN THE CITY OF DELAVER, WALWORTH
COUNTY, WISCONSIN.

NOTE: BEARINGS ARE REFERENCED TO THE
RECORDED SUBDIVISION PLAT.

ORDERED BY: PROFESSIONAL REALTY
706 E. GENEVA ST.
DELAVER, WI. 53115

RECERTIFIED: FEBRUARY 2, 1999
ORDERED BY: HIBL'S REAL ESTATE SALES, INC.
10348 ANN STREET
DELAVER, WI 53115

I HEREBY CERTIFY THAT I HAVE SURVEYED THE ABOVE DESCRIBED PROPERTY AND THAT THE
ABOVE MAP IS A TRUE REPRESENTATION THEREOF AND SHOWS THE SIZE AND LOCATION OF
THE PROPERTY, ITS EXTERIOR BOUNDARIES, THE LOCATION OF ALL VISIBLE STRUCTURES
AND DIMENSIONS OF ALL PRINCIPAL BUILDINGS THEREON, BOUNDARY FENCES, APPARENT
EASEMENTS, ROADWAYS AND VISIBLE ENCROACHMENTS, IF ANY, TO THE BEST OF MY
KNOWLEDGE AND BELIEF.

THIS SURVEY IS MADE FOR THE USE OF THE PRESENT OWNERS OF THE PROPERTY, AND ALSO
THOSE WHO PURCHASE, MORTGAGE, OR GUARANTEE THE TITLE THERETO WITHIN ONE (1) YEAR
FROM DATE HEREON.

David F. Abell

DAVID F. ABELL
WISCONSIN REGISTERED LAND SURVEYOR, S-1596

JUNE 10, 1992

DATE: _____ JOB NUMBER - 92117
NOTE: THIS IS NOT A CERTIFIED COPY UNLESS SEALED.

XLH-3

002-1786