


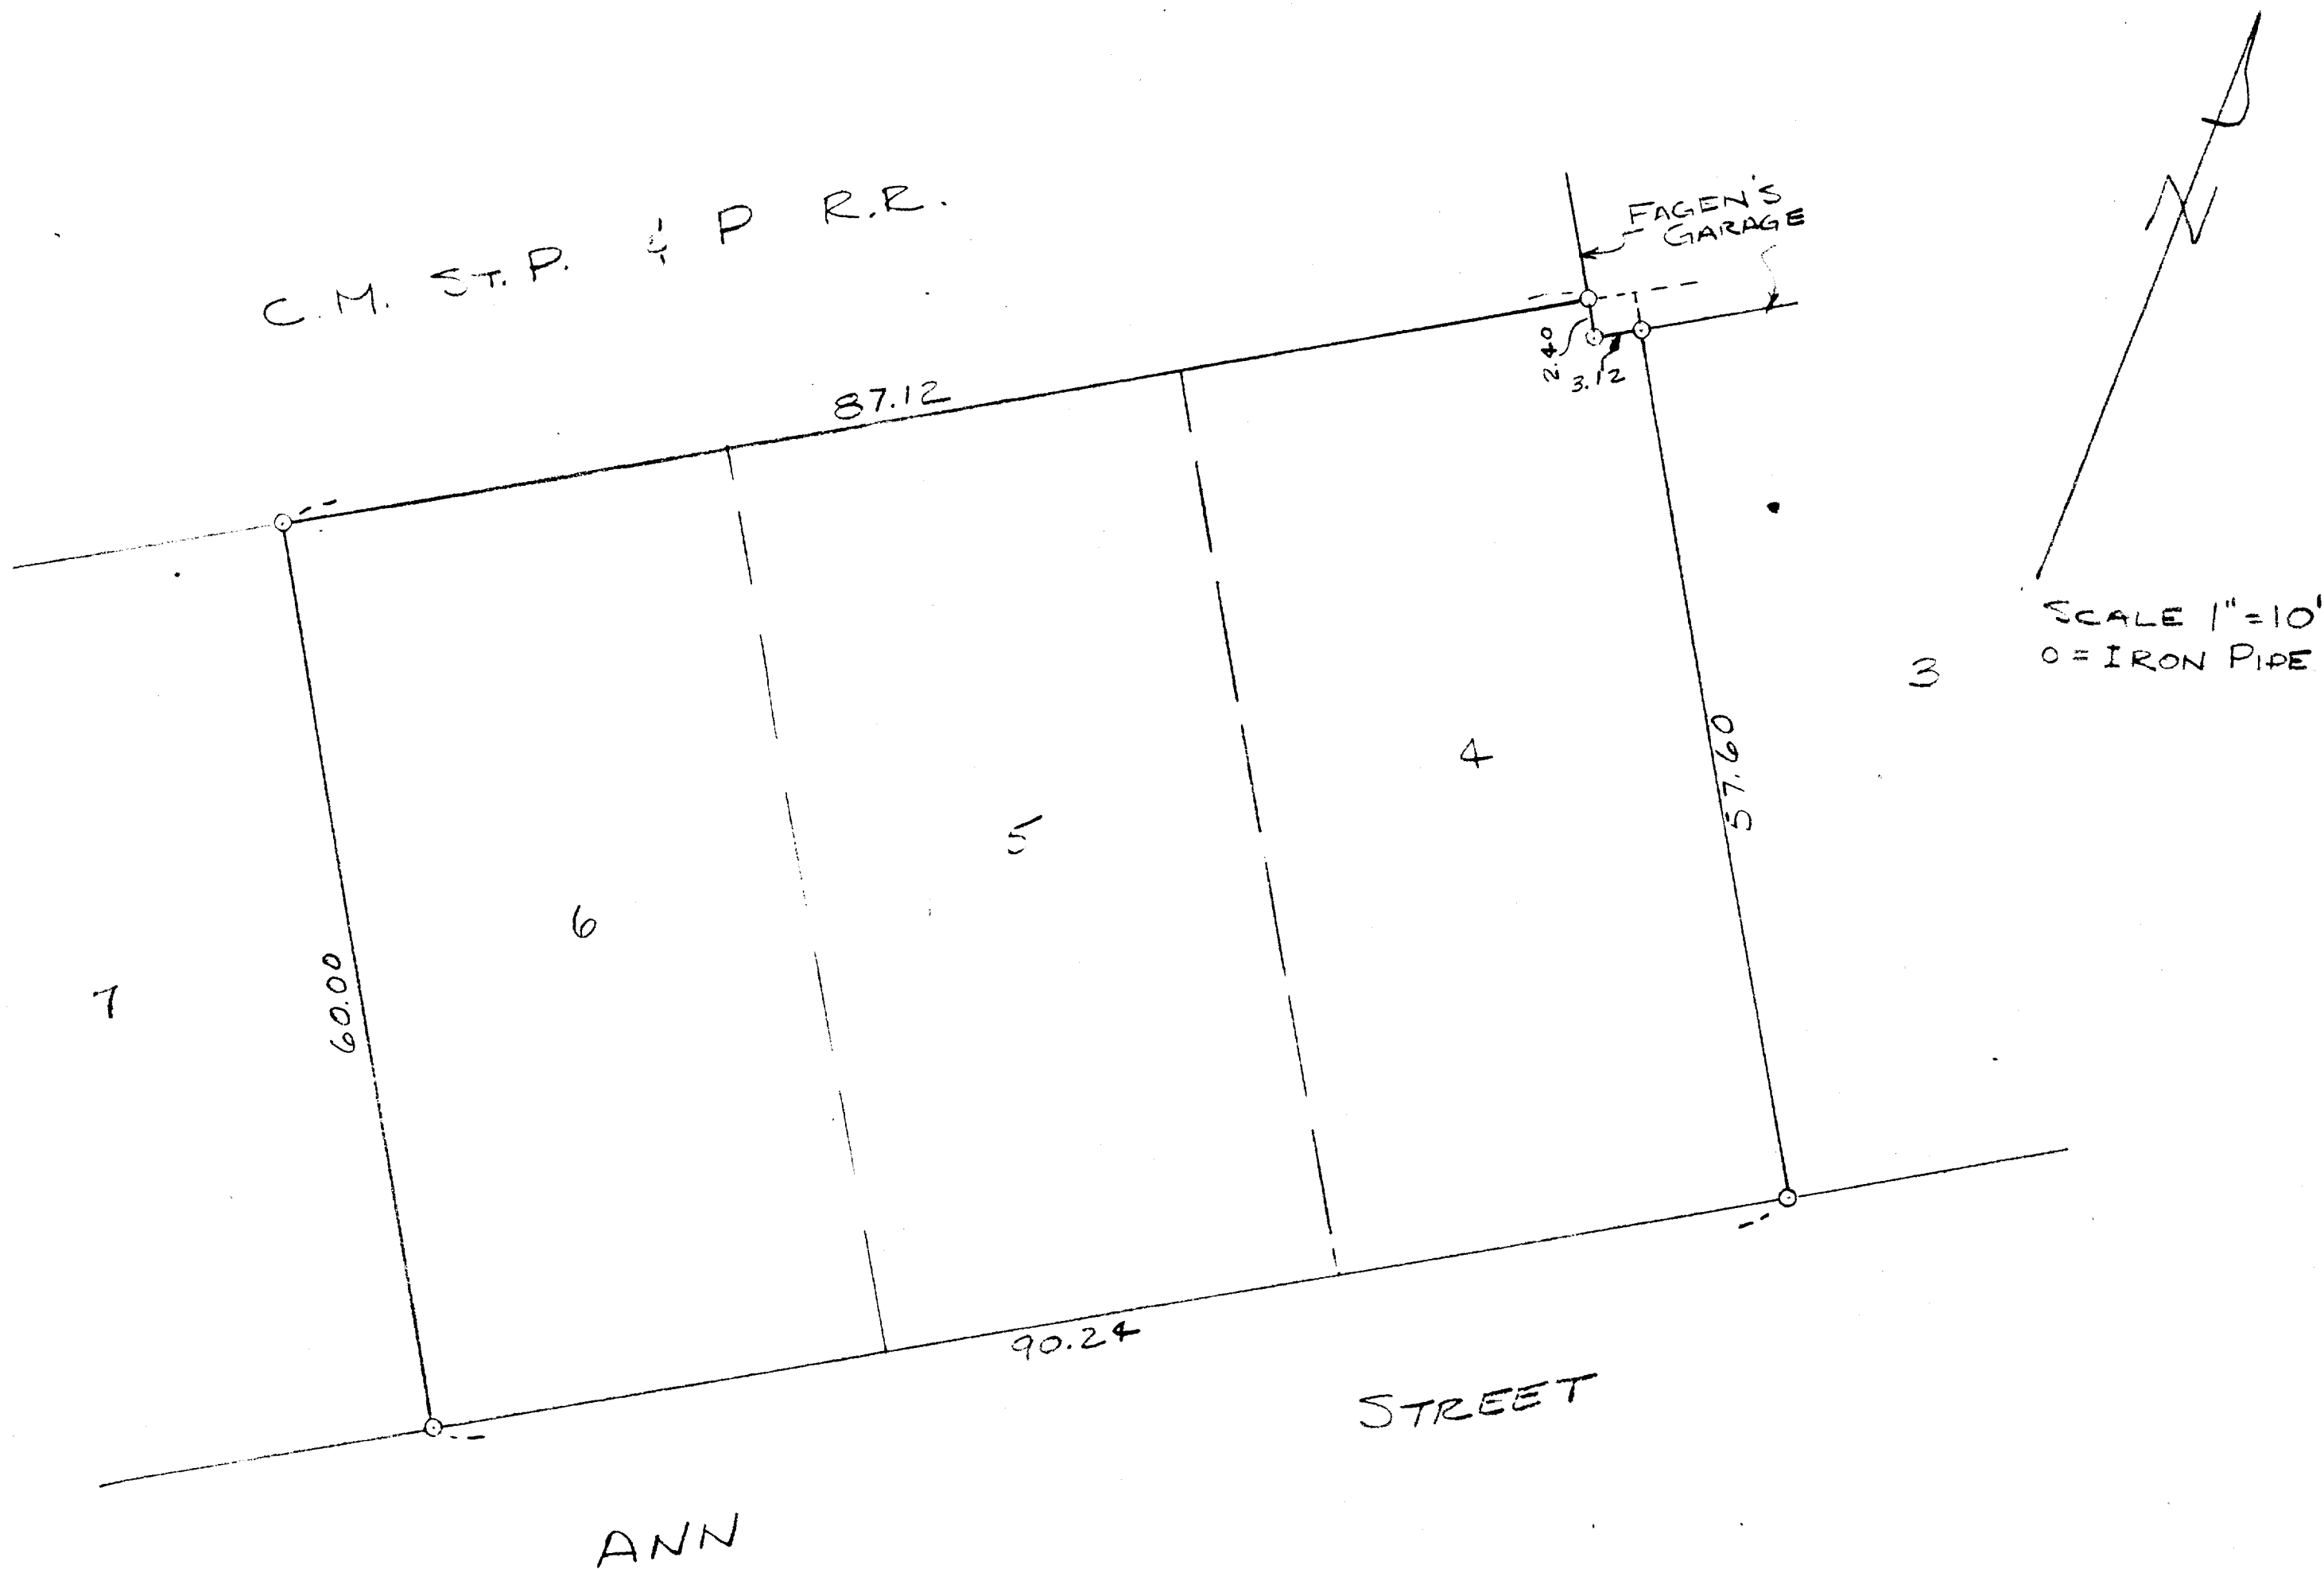

PLAT OF SURVEY OF LOTS 4, 5, & 6 OF BLOCK 10
OF PASSAGE, ARAM, & DOWNIES ADDITION TO THE CITY
OF DELAYAN, WALWORTH COUNTY, WISCONSIN.

OCTOBER 1950

Lloyd L. Jensen
COUNTY SURVEYOR