


ABELL
SURVEYING & MAPPING
140 SEQUOIA STREET • DELAVAN, WISCONSIN 53115
414-728-6737

FRANKLIN STREET

66 FEET WIDE

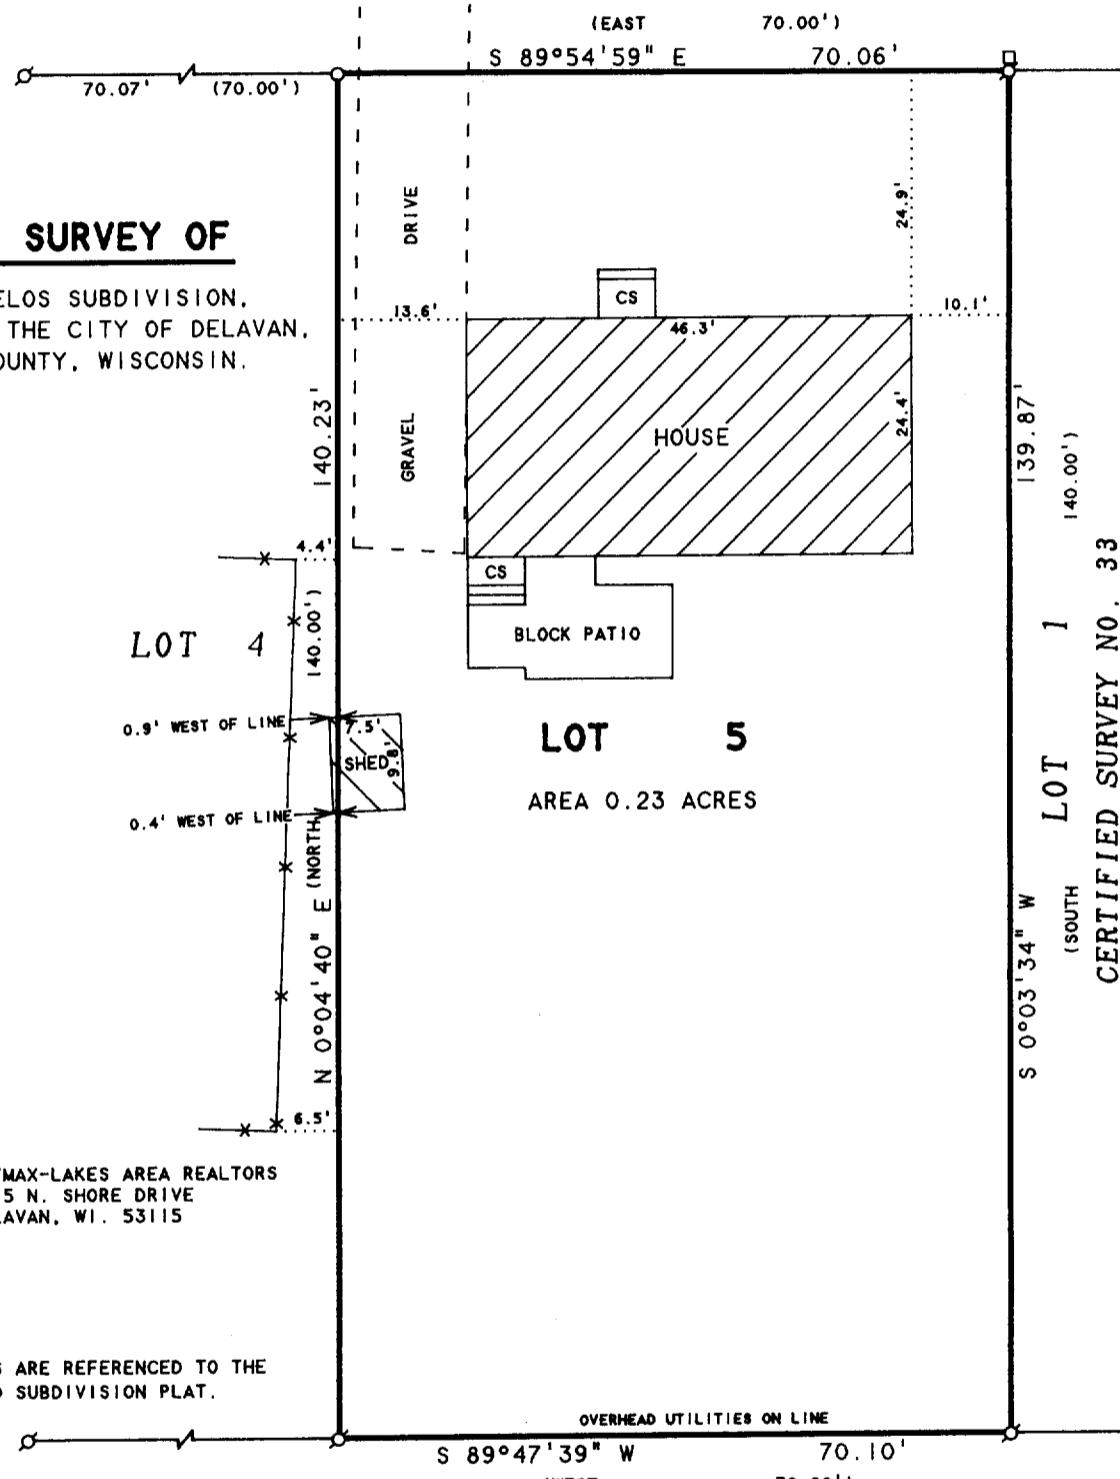

N

SCALE 1"=20'
LEGEND

I HEREBY CERTIFY THAT I HAVE SURVEYED THE ABOVE DESCRIBED PROPERTY AND THAT THE ABOVE MAP IS A TRUE REPRESENTATION THEREOF AND SHOWS THE SIZE AND LOCATION OF THE PROPERTY, ITS EXTERIOR BOUNDARIES, THE LOCATION OF ALL VISIBLE STRUCTURES AND DIMENSIONS OF ALL PRINCIPAL BUILDINGS THEREON, BOUNDARY FENCES, APPARENT EASEMENTS, ROADWAYS AND VISIBLE ENCROACHMENTS, IF ANY, TO THE BEST OF MY KNOWLEDGE AND BELIEF.

THIS SURVEY IS MADE FOR THE USE OF THE PRESENT OWNERS OF THE PROPERTY, AND ALSO THOSE WHO PURCHASE, MORTGAGE, OR GUARANTEE THE TITLE THERETO WITHIN ONE (1) YEAR FROM DATE HEREON.

David F. Abell

DAVID F. ABELL
WISCONSIN REGISTERED LAND SURVEYOR, S-1596

July 16, 1999

DATE: July 16, 1999
JOB NUMBER - 99122

NOTE: THIS IS NOT A CERTIFIED COPY UNLESS SEALED.

IRON PIPE FOUND
1" DIA. IRON PIPE SET
CONCRETE STOOP
CHAINLINK FENCE
UTILITY PED.
RECORDED AS

XAT-5

002-1802