

PLAT OF SURVEY
-OF-

LOT 64, WHISPERING PINES SECOND ADDITION, BEING PART OF
THE NORTHWEST 1/4 OF THE SOUTHEAST 1/4 OF SECTION 13,
TOWN 2 NORTH, RANGE 15 EAST, IN THE CITY OF DELAVAN,
COUNTY OF WALWORTH, STATE OF WISCONSIN.


SURVEY FOR: SOUTHEASTERN HOUSING CORP.

SURVEY ADDRESS: _____ WHISPERING PINES DRIVE

NOTE: MISSING LOT CORNERS TO BE SET BY RSV ENGINEERING
AFTER FINAL GRADING AND SIDEWALKS ARE COMPLETED.

LEGEND

○ FOUND IRON PIPE

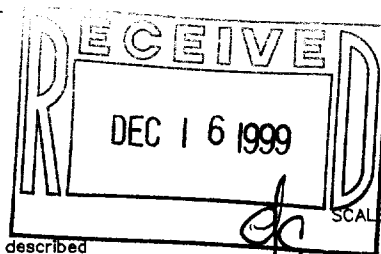


"I hereby certify that I have surveyed the above described
property and that the above map is a correct representation thereof
and shows the size and location of the property, its exterior
boundaries, the location of all visible structures and dimensions
of all principal buildings thereon, boundary fences, apparent
easements, roadways and encroachments, if any."

"This survey is made for the use of the present owners of the
property, and those who purchase, mortgage, or guarantee the
title thereto within one year from date hereof."



B.W. SURVEYING


412 N. PINE STREET
BURLINGTON, WI 53105
(414)-767-0225

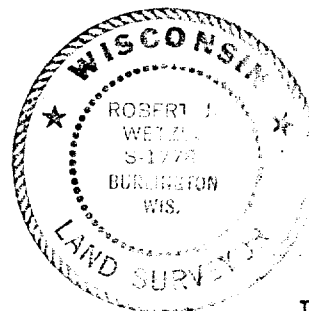

THIS IS NOT AN ORIGINAL PRINT
UNLESS THIS SEAL IS RED.

WHISPERING-PINES-DRIVE

66' WIDE

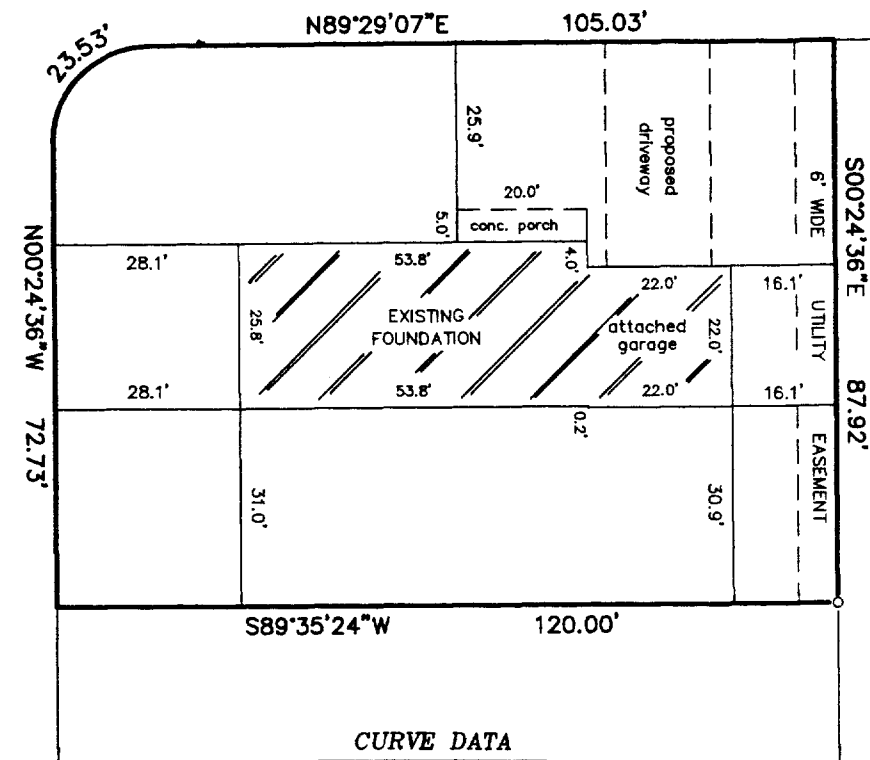

CURVE DATA

DELTA = 89°53'43"
RADIUS = 15.00'
CHORD = 21.19'
CHD B'ING = N44°32'15.5"E

Robert J. Wetzel
ROBERT J. WETZEL S-1778

OCTOBER 25, 1999
DATE

4110
JOB NUMBER

XWP2-11

002-1812