


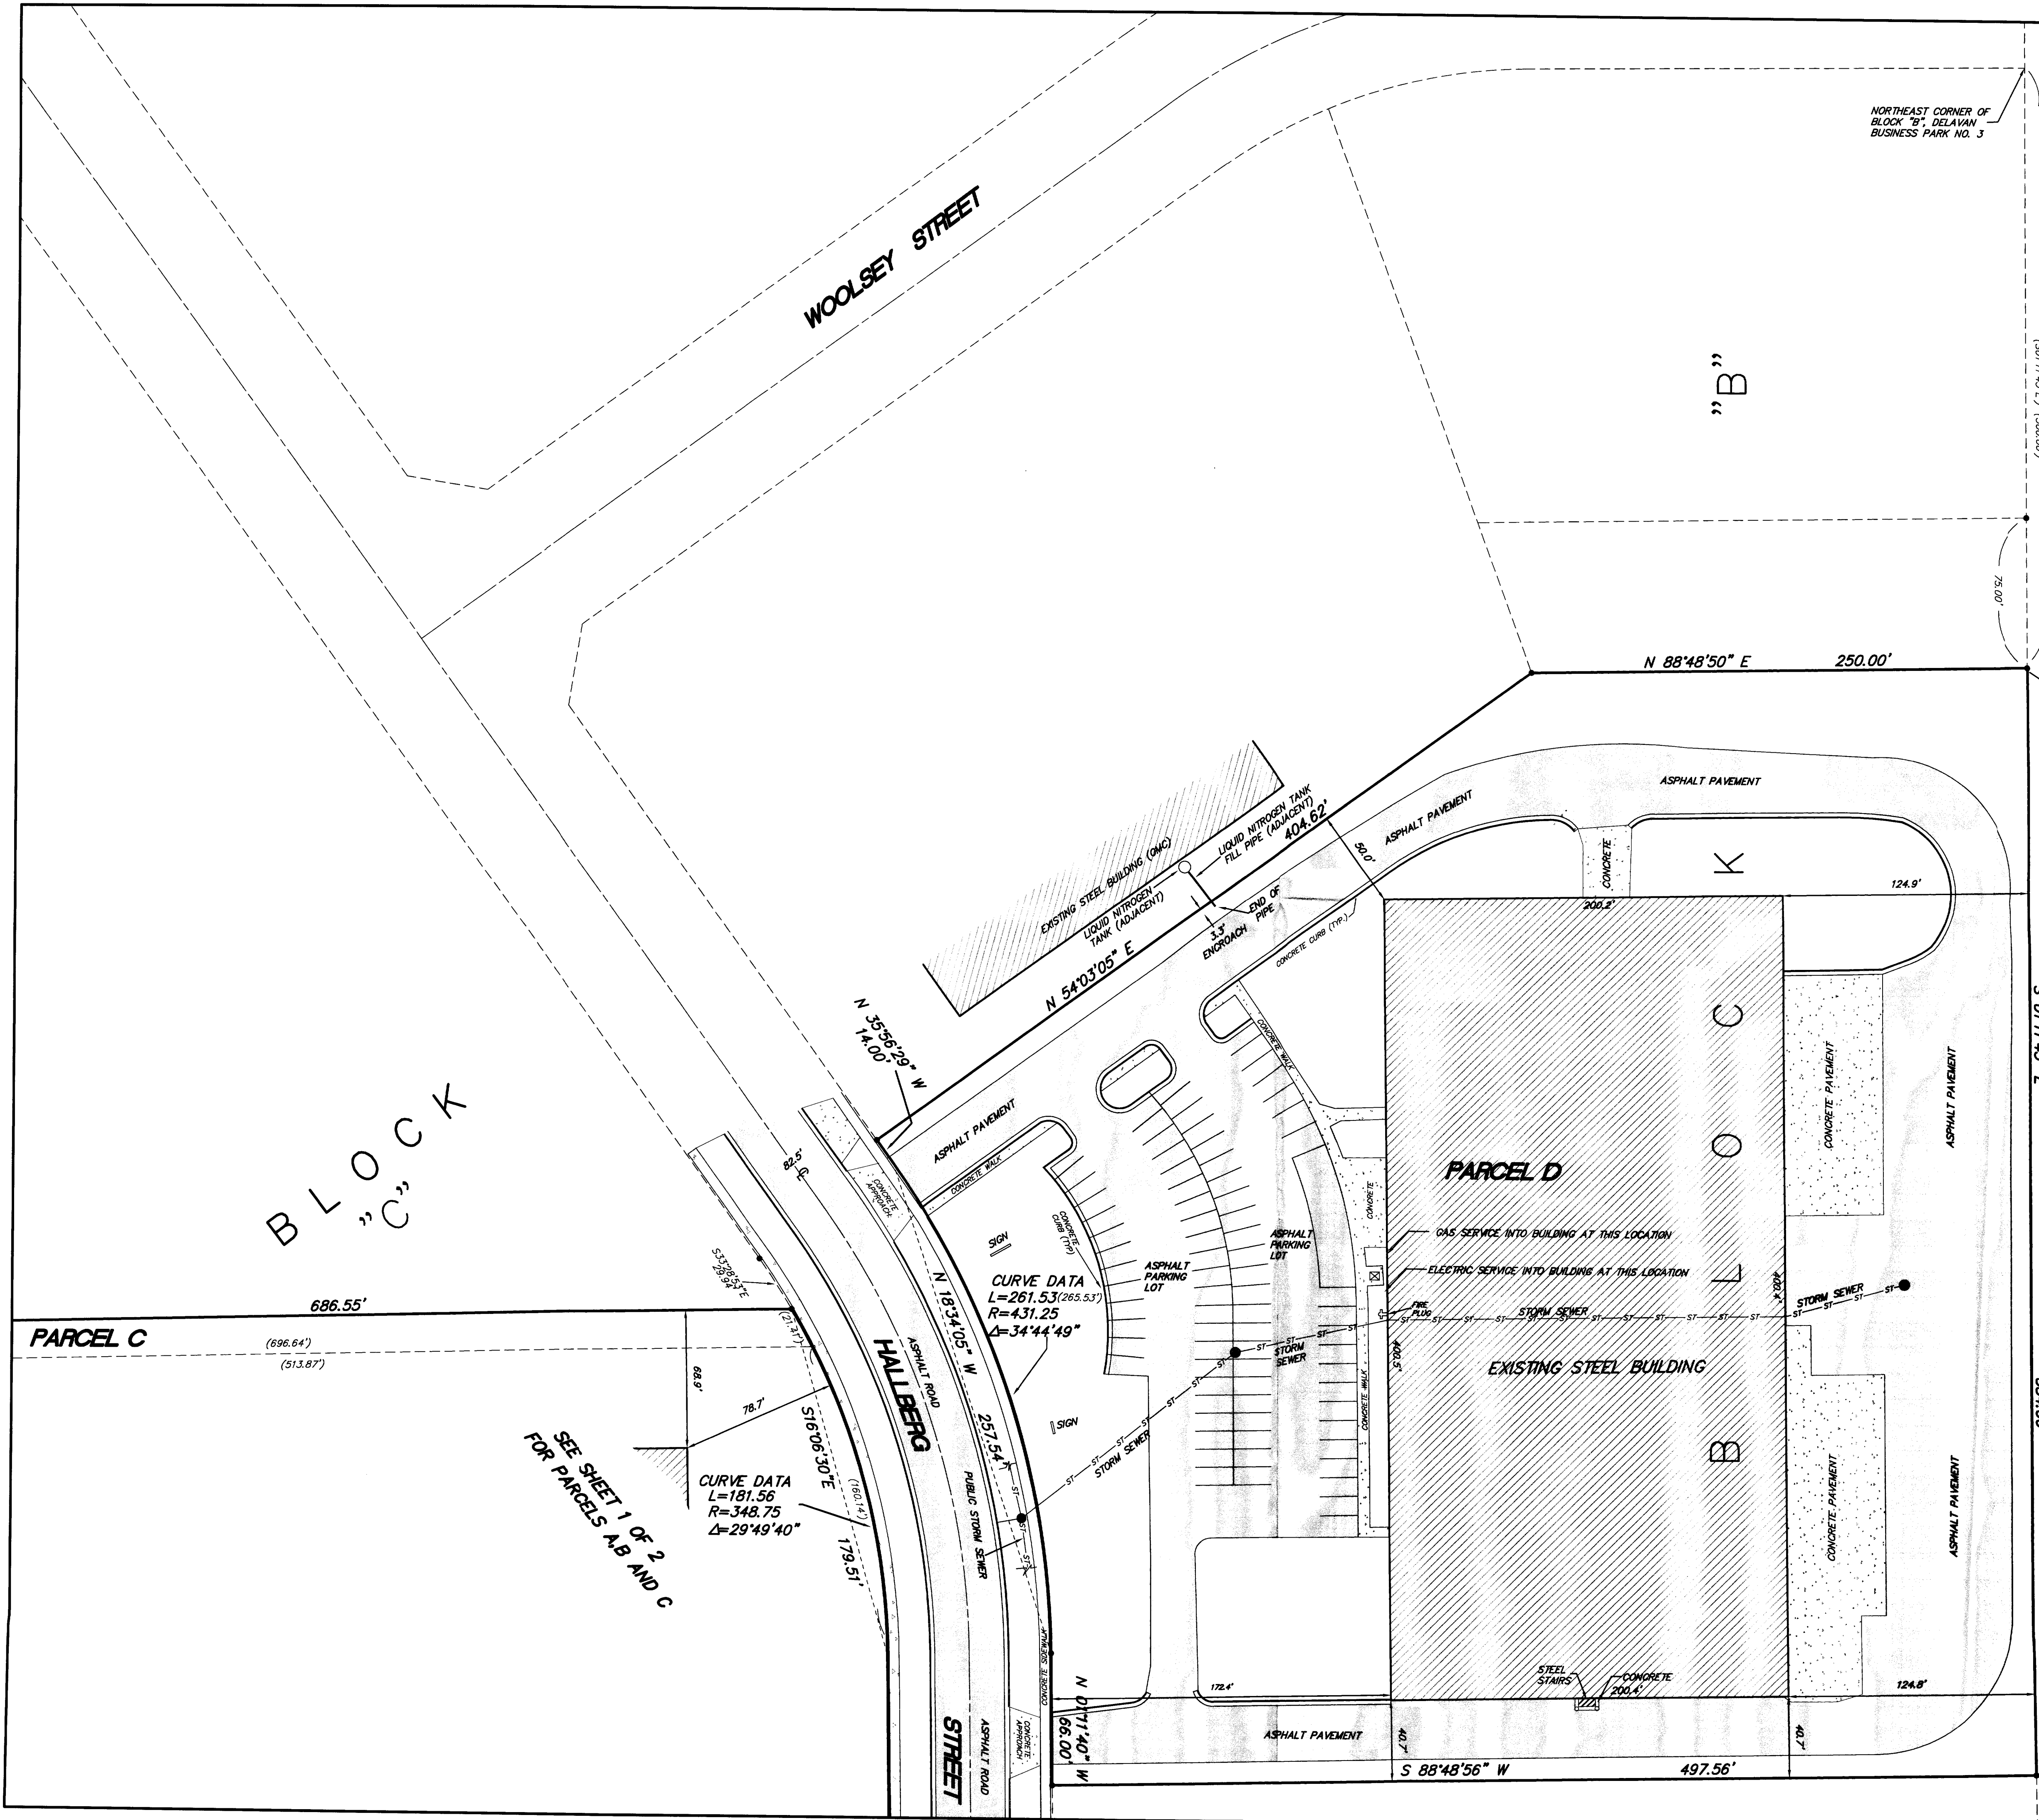

NORTHEAST CORNER OF
BLOCK "B", DELAVAN
BUSINESS PARK NO. 3

(5071.43') (300.00')

75.00'

N 88°48'50" E 250.00'

POINT OF BEGINNING
PARCEL "D"

BLOCK
"C"

686.55'

(696.64')
(513.87')

PARCEL C


SEE SHEET 1 OF 2
FOR PARCELS A, B AND C

CURVE DATA
L=181.56
R=348.75
Δ=29°49'40"




CURVE DATA
L=261.53 (265.53')
R=431.25
Δ=34°44'49"

PARCEL D

EXISTING STEEL BUILDING

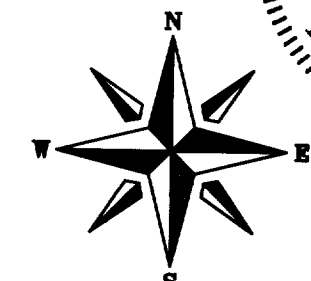

BEARINGS ARE REFERENCED TO
THE PLAT OF DELAVAN BUSINESS
PARK NO. 3

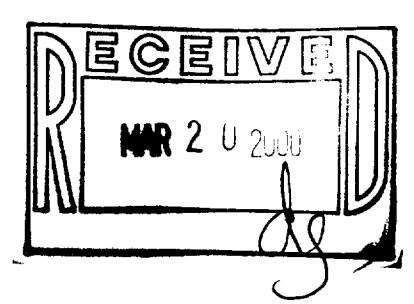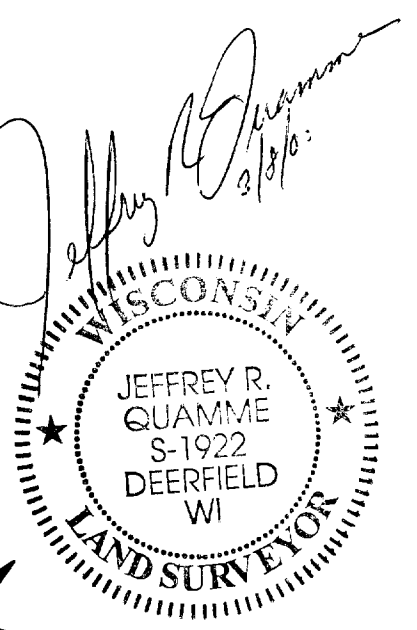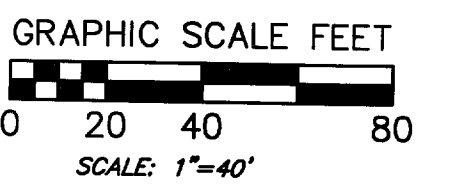

- LEGEND
- FOUND 3/4" # REBAR
(183.13') "RECORDED AS" DATA
 - ST—ST—ST STORM SEWER
 - CATCH BASIN
 - CURB INLET

PLAT OF SURVEY PARTS OF BLOCKS B AND C DELAVAN BUSINESS PARK NO. 3 CITY OF DELAVAN, WALWORTH COUNTY, WI			
		REVISIONS	
6200 MINERAL POINT ROAD • MADISON WI 53705 • 608-233-5800		NO.	DATE
DRAFTER JRQ		CHECKED JRQ,PRK	DATE 3/8/00
SCALE VERT. 1"=40'		REMARKS	
SHEET 2 OF 2		FILE NO.	
DWG. NO.		FILE NO.	