


1140 SEQUOIA STREET • DELAVAN, WISCONSIN 53115
262-728-6737

82.50 FEET WIDE



- ♂ - IRON PIPE FOUND
 ■ - CONCRETE MONUMENT FOUND
 CS - CONCRETE STOOP
 * - WOOD FENCE
 () - RECORDED AS

THE EAST 1/2 OF LOTS 5 AND 6, BLOCK 2,
PASSAGE, ARAM AND DOWNIE ADDITION TO THE
CITY OF DELAVAN, WALWORTH COUNTY, WISCONSIN

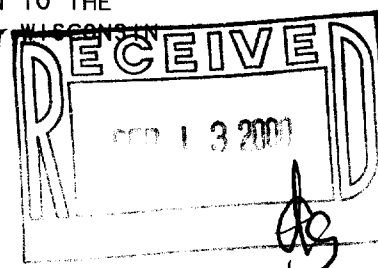

I HEREBY CERTIFY THAT I HAVE SURVEYED THE ABOVE DESCRIBED PROPERTY AND THAT THE ABOVE MAP IS A TRUE REPRESENTATION THEREOF AND SHOWS THE SIZE AND LOCATION OF THE PROPERTY, ITS EXTERIOR BOUNDARIES, THE LOCATION OF ALL VISIBLE STRUCTURES AND DIMENSIONS OF ALL PRINCIPAL BUILDINGS THEREON, BOUNDARY FENCES, APPARENT EASEMENTS, ROADWAYS AND VISIBLE ENCROACHMENTS, IF ANY, TO THE BEST OF MY KNOWLEDGE AND BELIEF.

THIS SURVEY IS MADE FOR THE USE OF THE PRESENT OWNERS OF THE PROPERTY, AND ALSO THOSE WHO PURCHASE, MORTGAGE, OR GUARANTEE THE TITLE THERETO WITHIN ONE (1) YEAR FROM DATE HEREON.

FROM DATE HEREON.

David F. Abell

DAVID F. ABELL
WISCONSIN REGISTERED LAND SURVEYOR. S-1596

ORDERED BY: KEEFE REAL ESTATE
1155 E. GENEVA STREET
DELAVER, WI 53115

August 10, 2000

DATE _____ JOB NUMBER - 00127
NOTE: THIS IS NOT A CERTIFIED COPY UNLESS SEALED.

XP-21

002-1865