


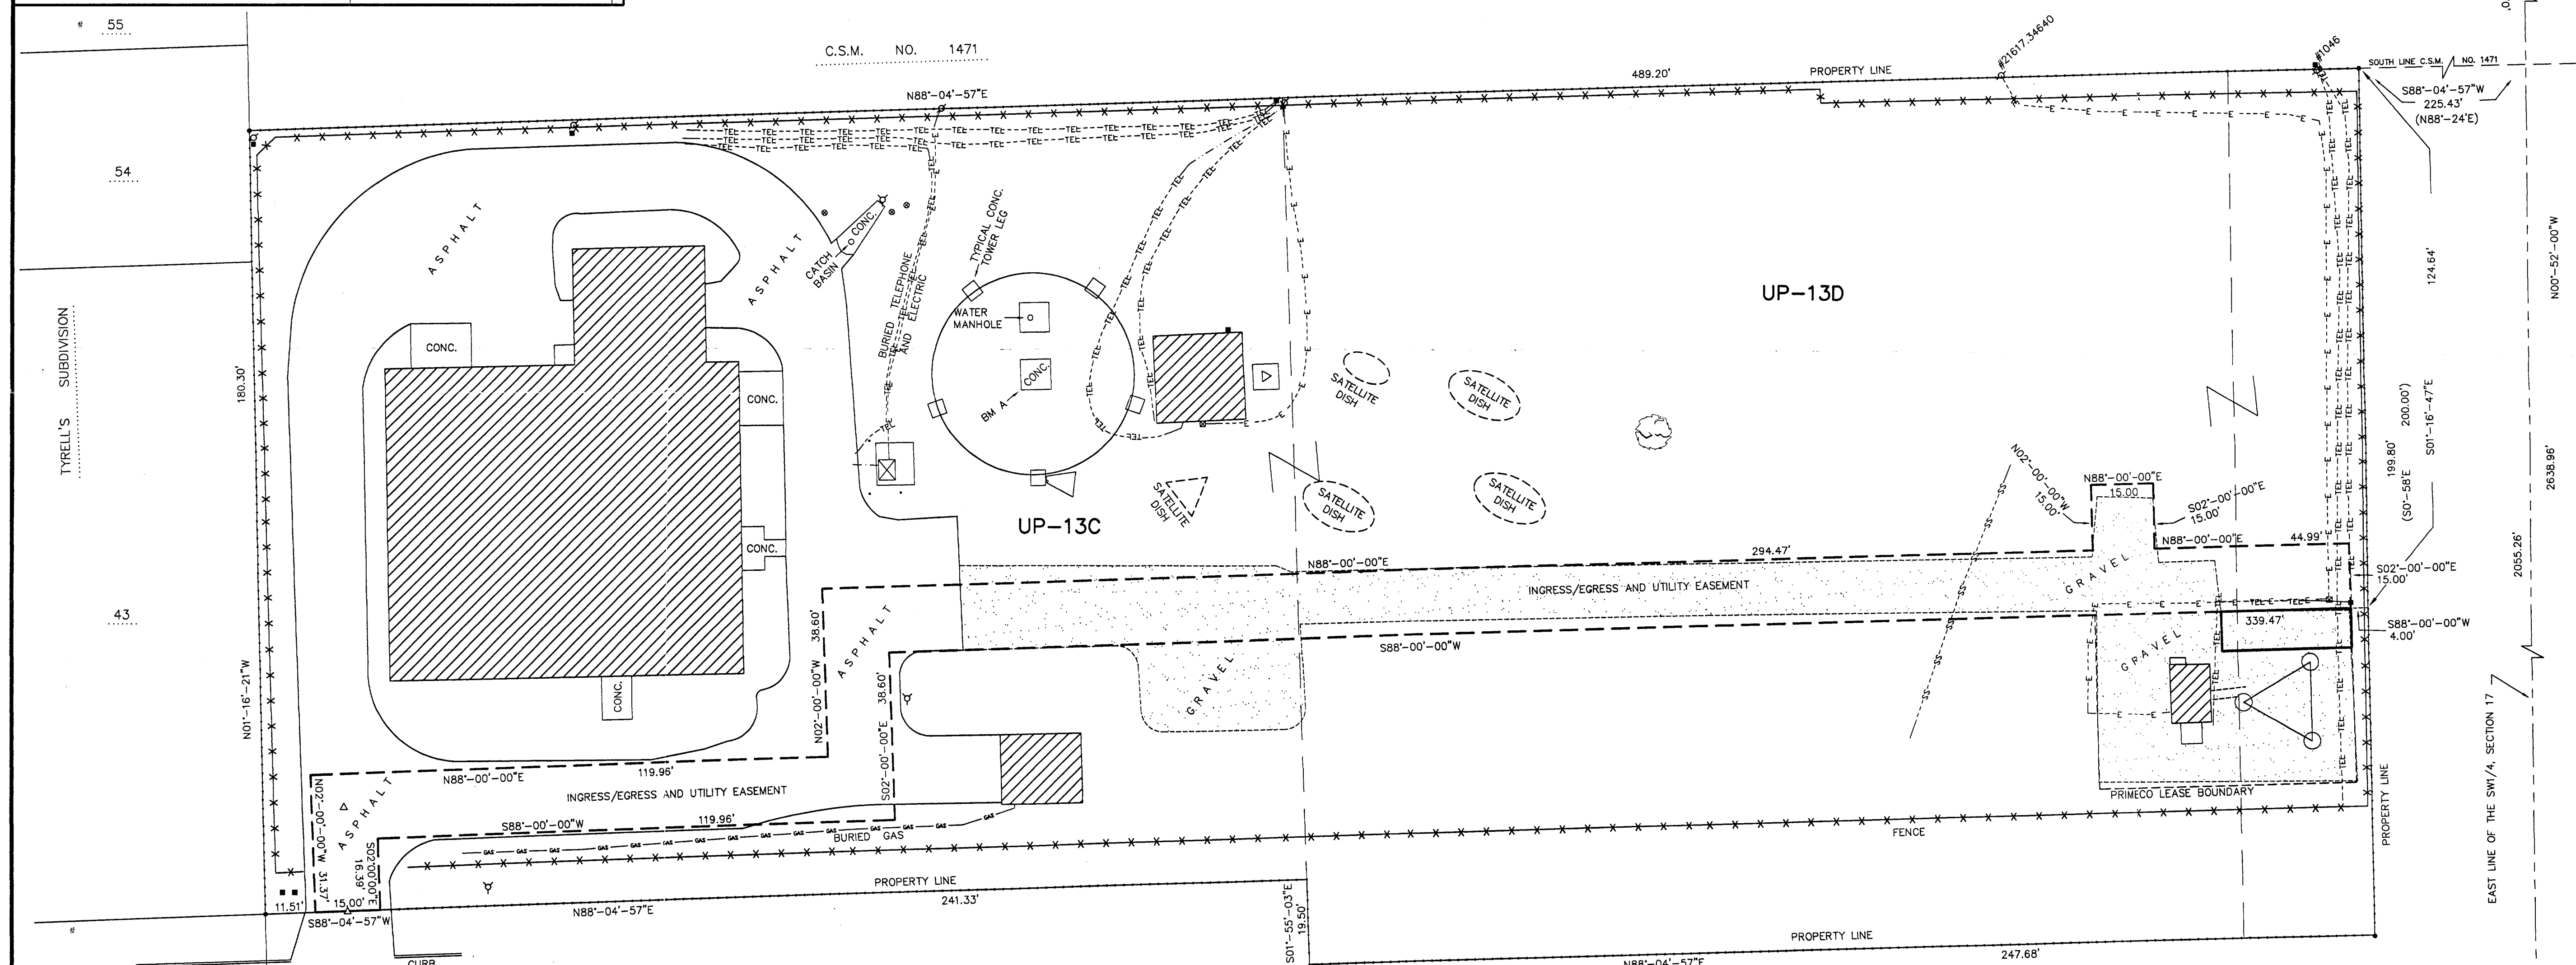

WILEMAN SCHOOL PROPERTY

— TOWER BASE —

Latitude: 42°-37'-51.73"
Longitude: 88°-37'-49.87"
(Per North American Datum of 1983/91)

Elevation: 939.8'
Top of Tower Elevation: 1119.7'
Top of Antenna Elevation: 1122.9'
Bottom of Antenna Elevation: 1116.7'
(Per National Geodetic Vertical Datum of 1929)

PROJECT: CITY OF DELAVAN WT ML33XC023A

PROPERTY OWNER:
CITY OF DELAVAN
123 S. SECOND STREET
DELAVAN, WI 53115

PROPERTY ADDRESS:
1111 EDWARDS STREET
TAX KEY NO. XWUP 00013C
&
XWUP 00013D

SURVEYOR'S CERTIFICATE

I, Craig A. Keach, Wisconsin Registered Land Surveyor of Aero-Metric Incorporated, certify that I have surveyed the above property and that the map shown to the left is a true and accurate representation thereof to the best of my knowledge and belief.

ALSO

I, Craig A. Keach, Wisconsin Registered Land Surveyor of Aero-Metric, Inc., certify that I have surveyed the described property and that the map shown is a true and accurate representation thereof to the best of my knowledge and belief.

Dated this 16th day of OCTOBER, 2000.

Craig A. Keach
WISCONSIN REGISTERED LAND SURVEYOR
Craig A. Keach, S-2333

Only if the surveyor's signature or stamp is in RED is this an original copy. Anything other than an original copy may contain unauthorized alterations to the original.

The surveyor accepts no responsibility for non-original copies of this document.

42

SCALE: 1" = 20'


BEARINGS REFERENCED TO THE WISCONSIN COORDINATE SYSTEM - SOUTH ZONE

SURVEYED FOR:
SPRINT PCS
9801 W. HIGGINS ROAD
SUITE 340
ROSEMONT, ILLINOIS 60018

TOWER OWNER:
VERIZON WIRELESS
700 WEST VIRGINIA STREET
SUITE 300
MILWAUKEE, WI 53204
414-390-5200

S1/4 CORNER
SECTION 17
T.2N., R.16E.

XWUP-13C
XWUP-13D

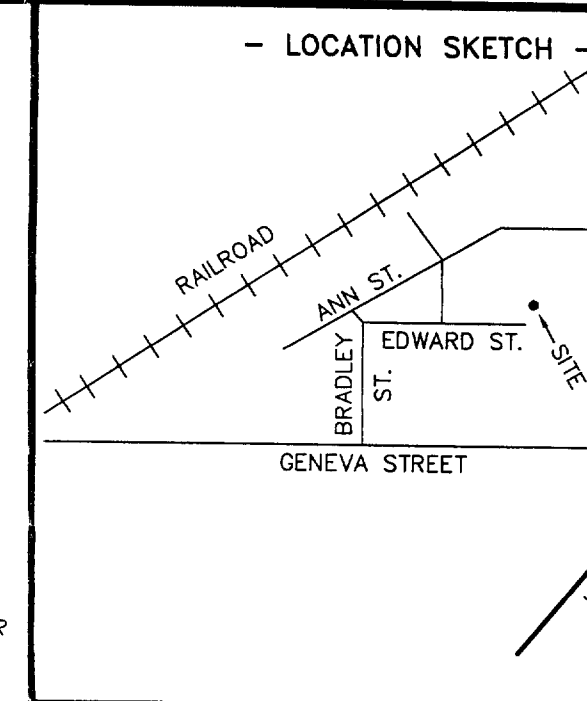[illegible]

 **AERO-METRIC**
Aero-Metric, Incorporated
Land Planning & Design Division
920-849-7708 800-472-3313 FAX (849-7709)
539 NORTH WADSWIN STREET CHILTON, WISCONSIN 53014

**SITE SURVEY
FOR
SPRINT PCS**

A PART OF THE NE1/4 OF THE SW1/4,
SECTION 17, T.2N., R.16E., CITY OF
DELAVER, WALWORTH COUNTY, WISCONSIN



SHEET NO.
1 OF 1

FILE NO.
K-837

SPRINT PCS
SITE NO.
ML33XC023